


Traffic Control For Street Installations

**General Notes**

1. The Contractor is required to place the necessary construction sign, detour sign, street closing sign, land closing sign, men working sign, two way traffic sign, warning signs, road construction and end of construction signs on the barricades at all times during construction.
2. The Contractor is responsible to keep barricading in place and working at all times.
3. The Contractor is responsible for one (1) Part-A-Can for each increment of 20 employees.
4. The Contractor shall be responsible for the restoration of the South Lane only of Les Lacs Avenue, to include joint sealing/repair, installation of the five foot sidewalk, and traffic buttons which are missing, shall be constructed in accordance with the Town Of Addison's standard specifications.
5. All joints through the gutter shall be sealed with hot-poured rubber sealer unless otherwise specified.
6. Any removal of concrete pavement shall be made by a power driven saw prior to the replacement of the paving.
7. The Contractor shall be responsible to visit site field verify the condition of Les Lacs Avenue.

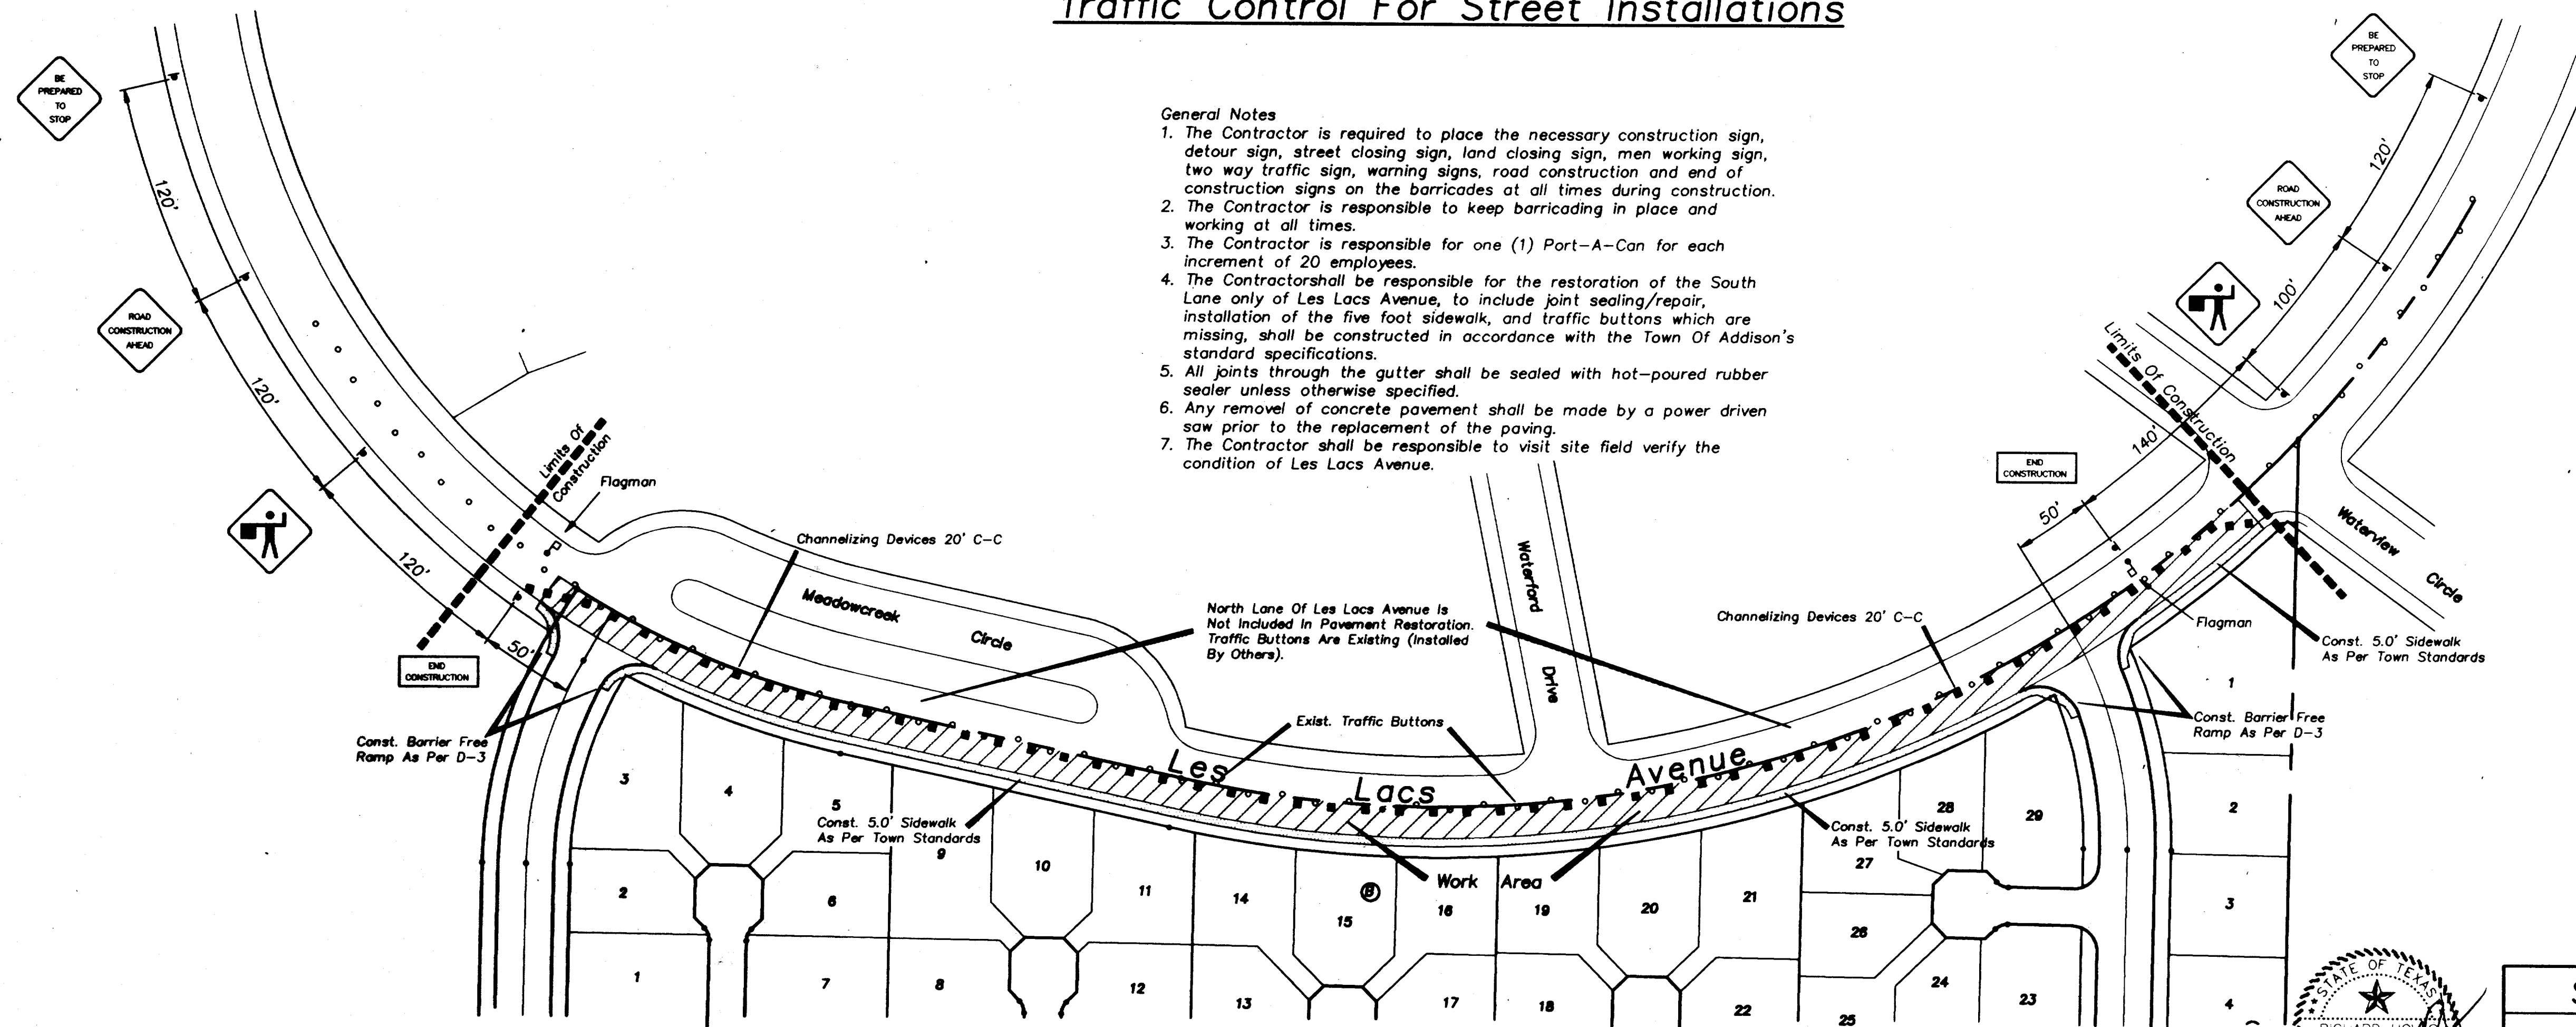

Traffic Control & Warning Device For  
Restoration Of Les Lacs Avenue


As-Built Plans  
5-28-93

**STREET RESTORATION PLAN**  
**GRAND ADDISON II**  
Town Of Addison, Texas

**TIPTON ENGINEERING, INC.**

6330 Belt Line Rd. ~ Suite C ~ Garland, Texas 75043

DESIGN	DRAWN	DATE	SCALE	NOTES	FILE	NO.
T.E. Inc.	T.E. Inc.	10/92	1"=60'		3726	11

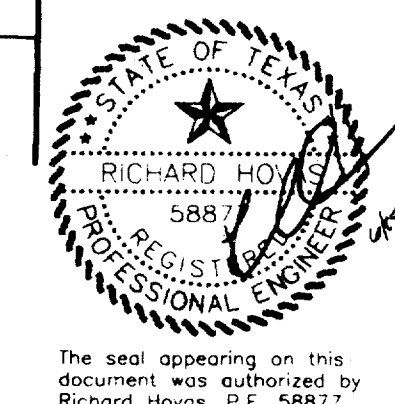

The seal appearing on this document was authorized by Richard Hevas, P.E. 5887

11-13-92  
3726SRP