


CV.1 A=38'24"16" R=70.0' T=24.38' L=46.92'

CV.2 A=34'43"01" R=70.0' T=21.88' L=42.41'

CV.3 A=86'20"00" R=70.0' T=65.66' L=105.48'

CV.4 A=31'57"27" R=70.0' T=20.04' L=39.04'

NOTE!  
SEE SHEET 7 FOR PROFILES OF LINES  
"A-1"; "A-2"; "A-3"; "A-4"; "A-5"; "A-6"

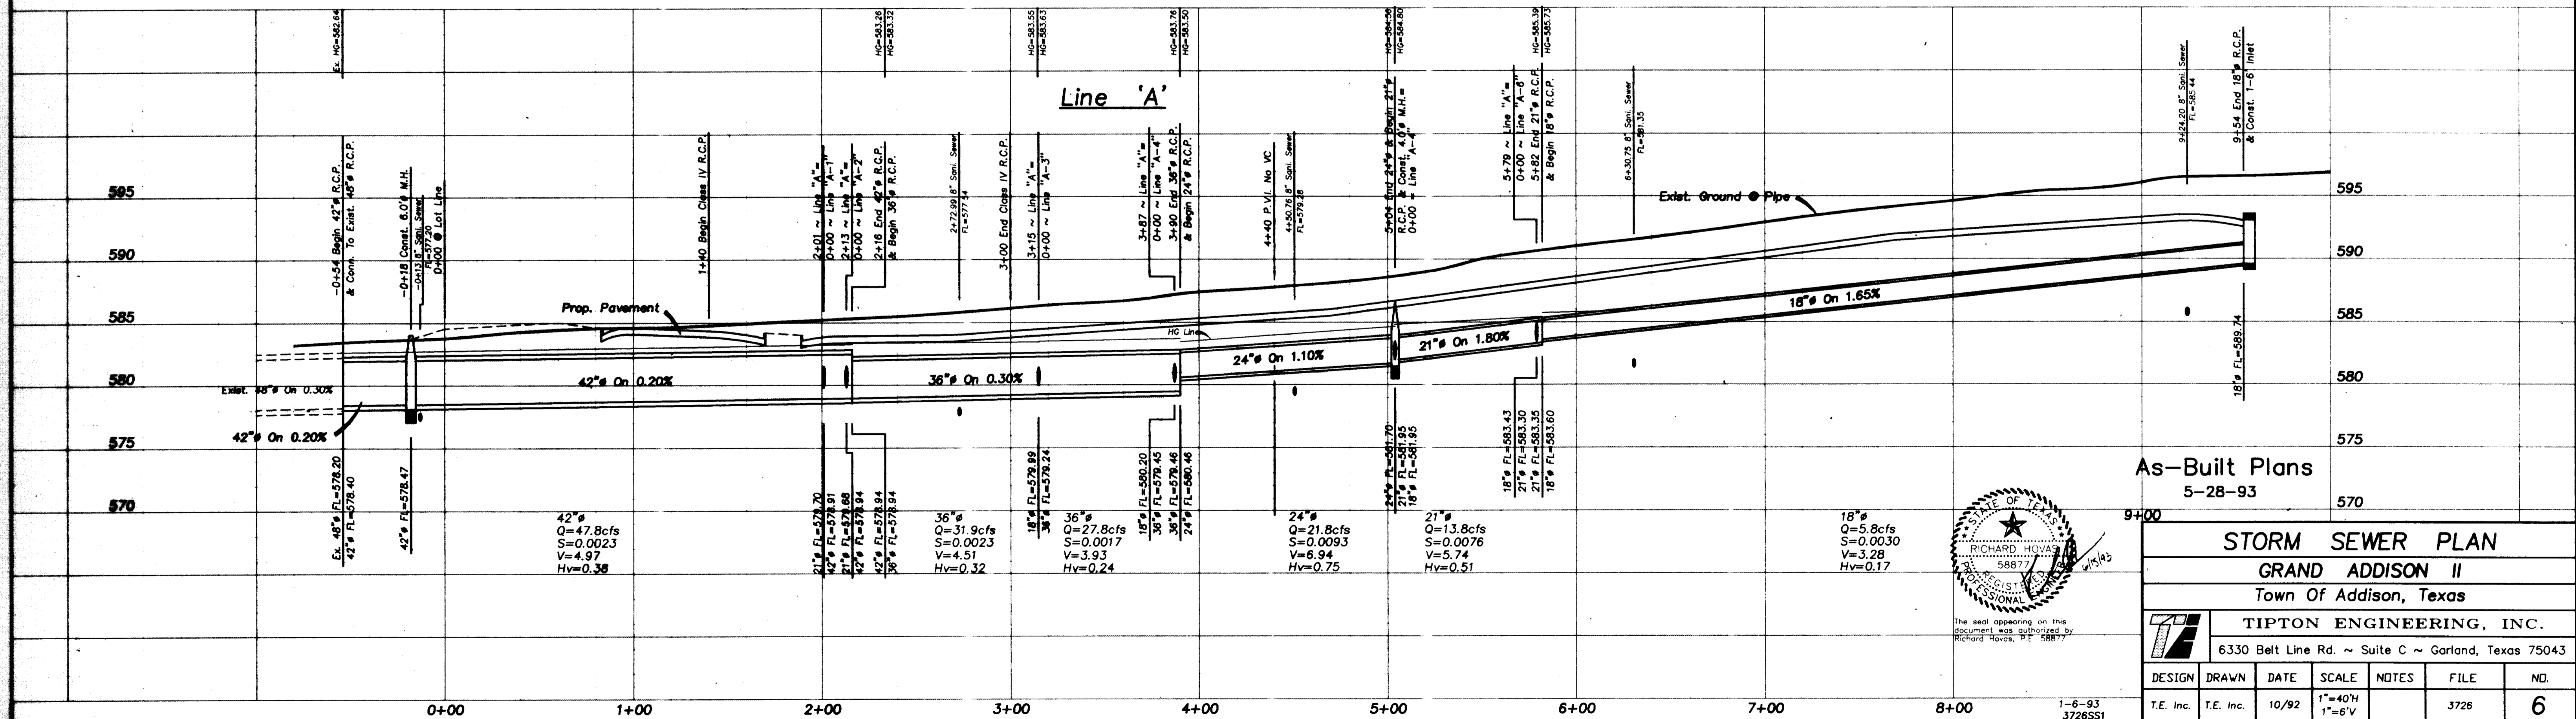

**As-Built Plans**  
5-28-93

**STORM SEWER PLAN**  
**GRAND ADDISON II**  
Town Of Addison, Texas

**TIPTON ENGINEERING, INC.**  
6330 Belt Line Rd. ~ Suite C ~ Garland, Texas 75043

DESIGN	DRAWN	DATE	SCALE	NOTES	FILE	NO.
T.E. Inc.	T.E. Inc.	10/92	1"=40' H 1"=6' V		3726	6