


As-Built Plans
5-28-93

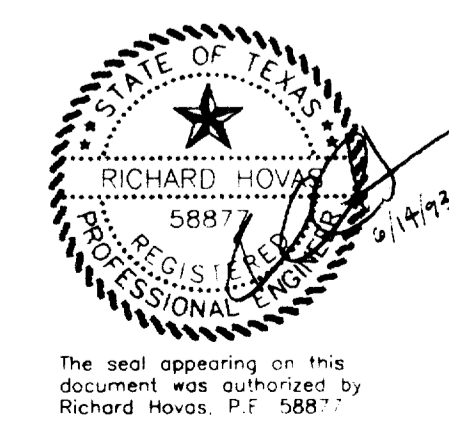

WATER & SEWER AS-BUILT TIES
GRAND ADDISON II
Town Of Addison, Texas

TIPTON ENGINEERING, INC.
6330 Belt Line Rd. ~ Suite C ~ Garland, Texas 75043

DESIGN	DRAWN	DATE	SCALE	NOTES	FILE	NO.
T.E. Inc.	T.E. Inc.	10/92	1"=40'		3726	8A

6-14-93
3726ASB