


40 20 0 40 80
SCALE FEET



As-Built Plans
5-28-93

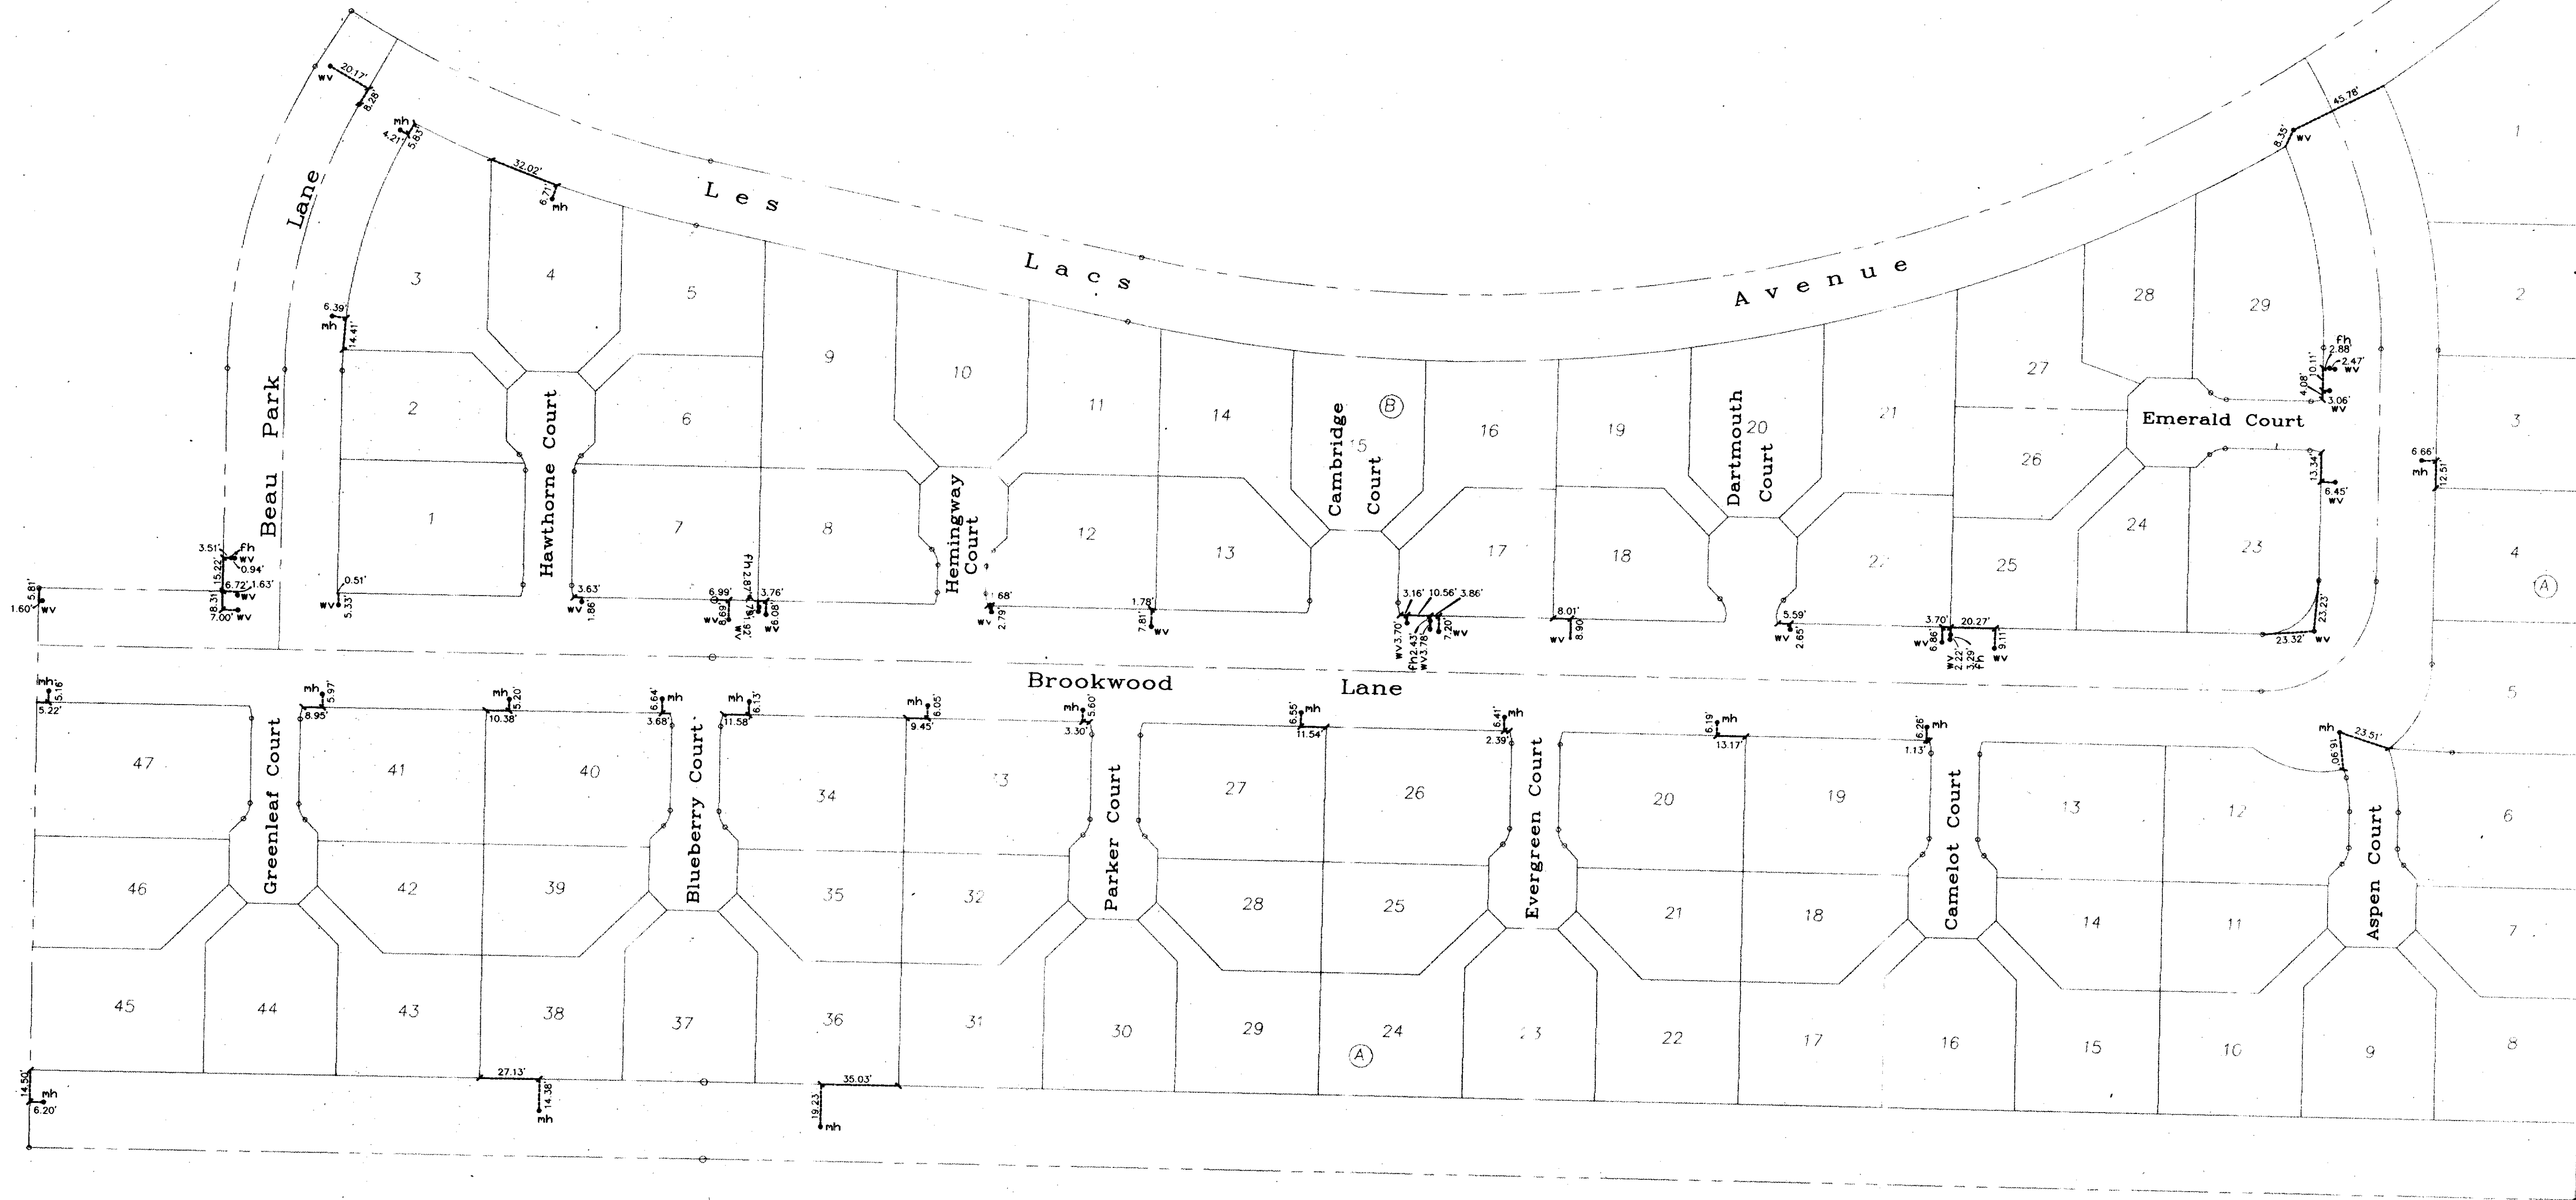

The seal appearing on this document was authorized by Richard Howes, P.E. 5887.

WATER & SEWER AS-BUILT TIES						
GRAND ADDISON II						
Town Of Addison, Texas						
TIPTON ENGINEERING, INC.						
6330 Belt Line Rd. ~ Suite C ~ Garland, Texas 75043						
DESIGN	DRAWN	DATE	SCALE	NOTES	FILE	NO.
T.E. Inc.	T.E. Inc.	10/92	1"=40'		3726	8A

6-14-93
3726ASB