


MEADOWCREEK CIRCLE

WATERFORD DRIVE

LES LACS AVE.

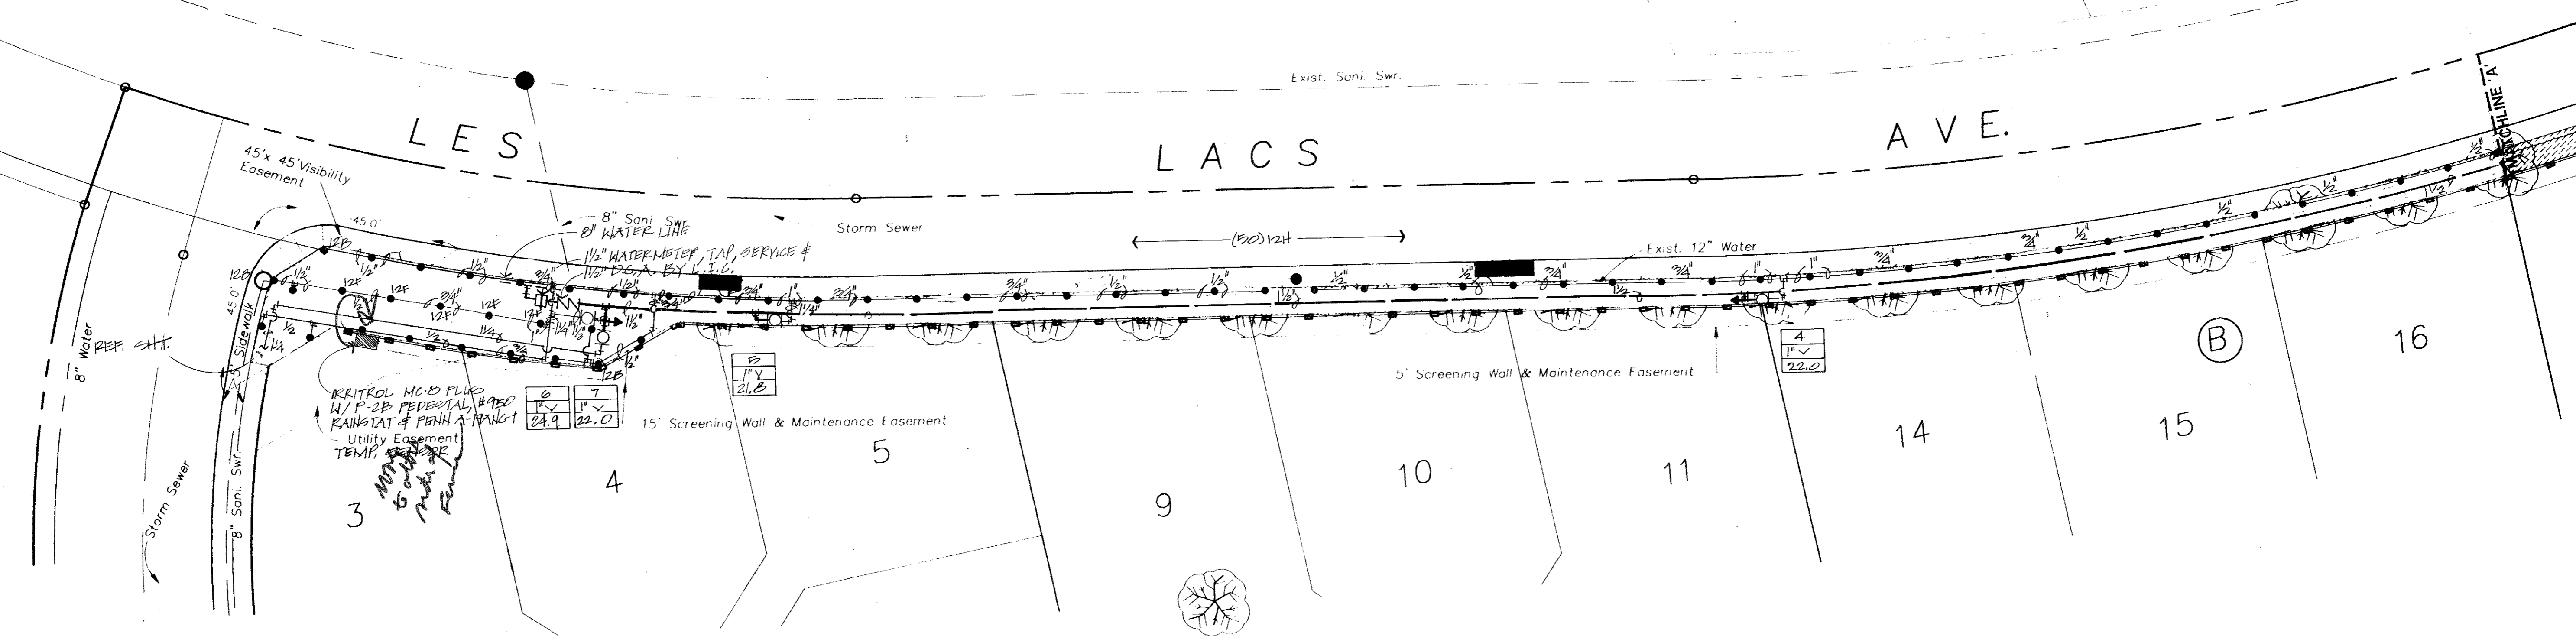


CONTROL M.C.D. PLUG
W/P 2\"/>

6	7
21.9	22.0

B	1/4
21.8	

A	1/4
22.2	

RADIUS LEGEND		IRRIGATION LEGEND	
SYMBOL	DESCRIPTION	SYMBOL	DESCRIPTION
F-360°		●	LAWN SPRAY HEAD
H-180°		□	CONTROLLER
O-90°		○	REMOTE CONTROL VALVE
A-120°		▲	QUICK COUPLING VALVE
B-135°		—	MAINLINE PIPING
C-225°		---	LATERAL PIPING
D-240°		≡	DOUBLE CHECK ASSEMBLY
E-270°		⊕	METER, TAP & SERVICE

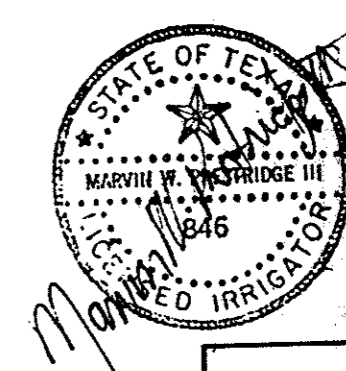

SYSTEMS DESIGN DEPARTMENT
IARI TECH CORPORATION
IRRIGATION TECHNOLOGY, 12650 Schroeder, Dallas, Texas 75231 • (214) 231-5151

IRRIGATION PLAN						
GRAND ADDISON II						
Town of Addison, Dallas County, Texas						
TIPTON ENGINEERING, INC.						
6330 Belt Line Rd. ~ Suite C ~ Garland, Texas 75043						
DESIGN	DRAWN	DATE	SCALE	NOTES	FILE	NO.
T.E., Inc.	T.E., Inc.	12/92	1" = 20'		#3726	7

(12/09/92 • 3726P2)

92011D