


SANITARY SEWER LINE A

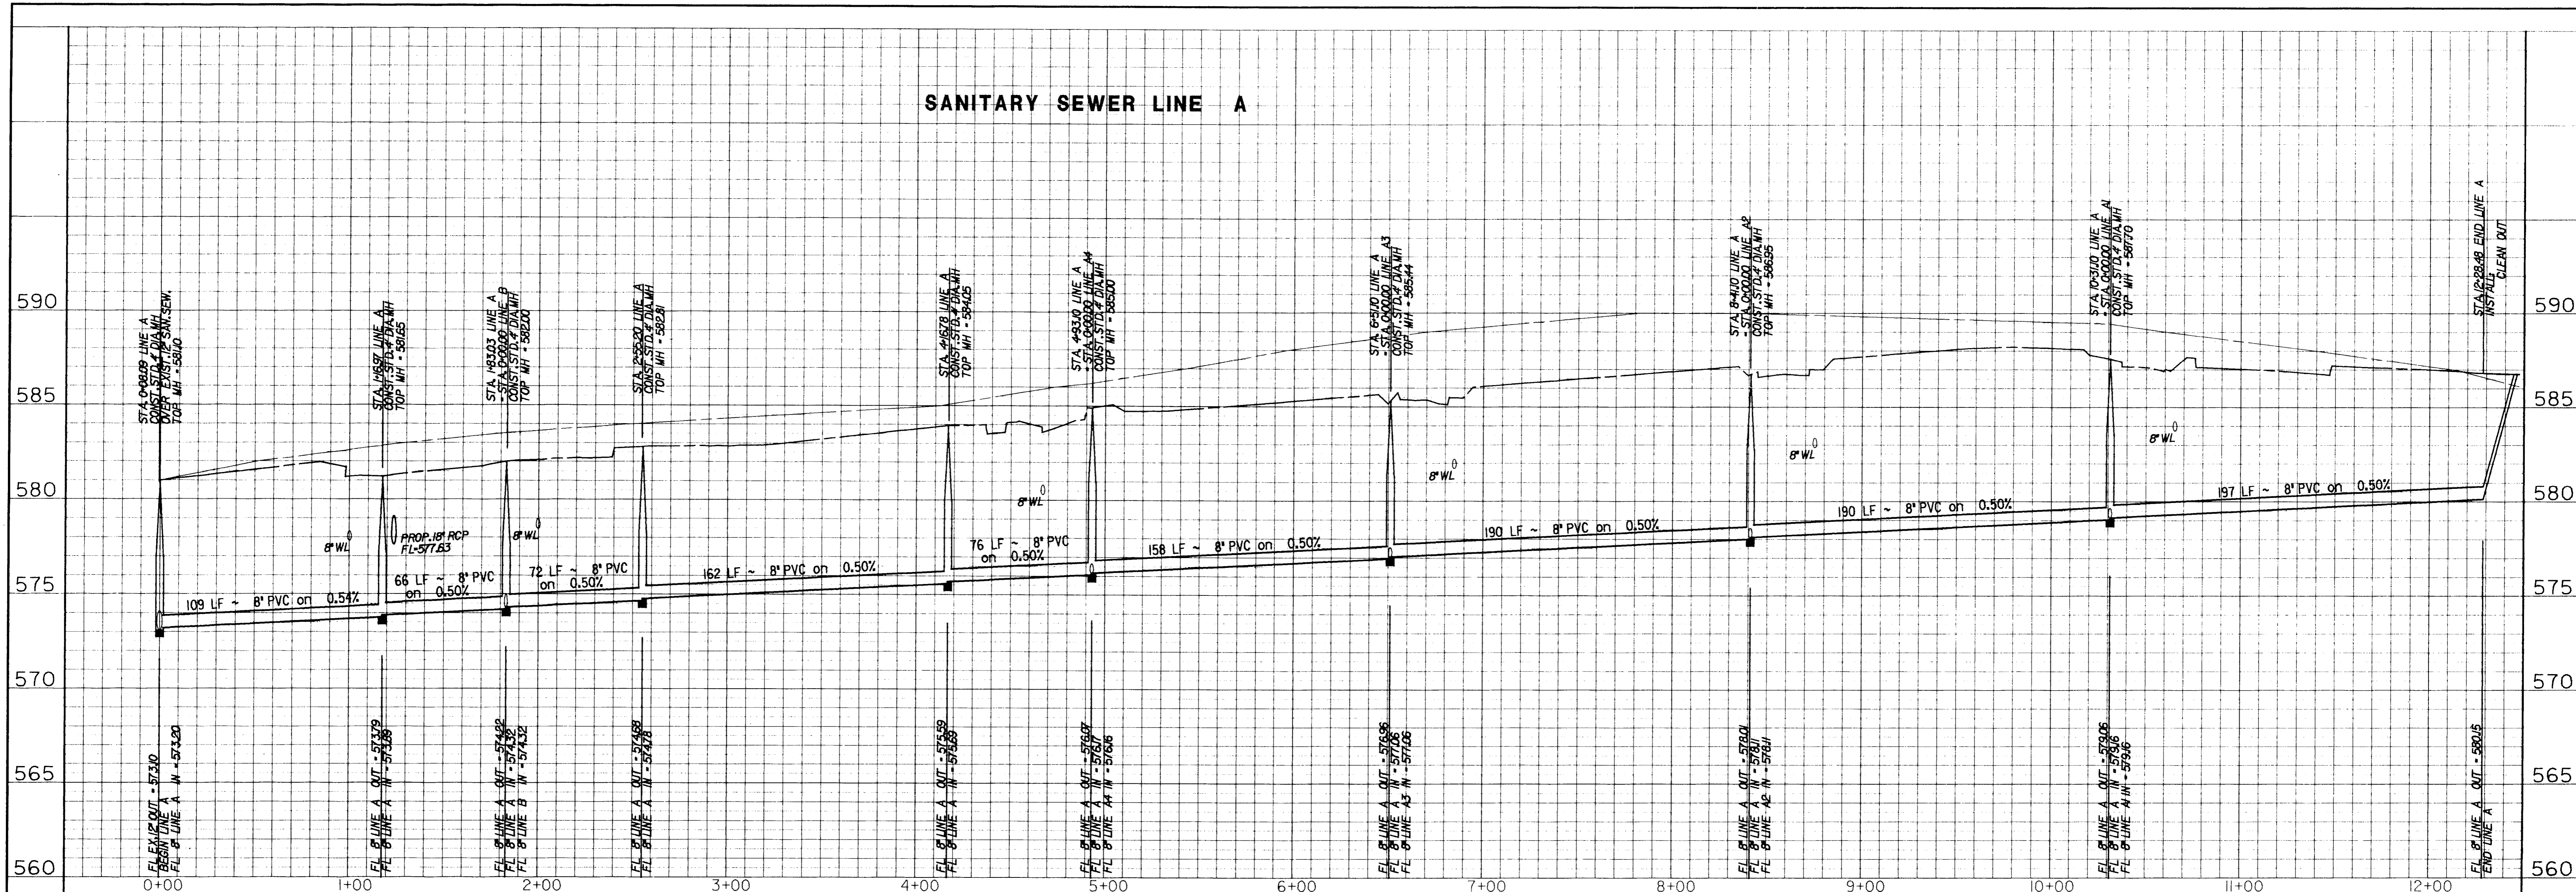


SANITARY SEWER LINE A1

SANITARY SEWER LINE A2

SANITARY SEWER LINE A3

SANITARY SEWER LINE A4


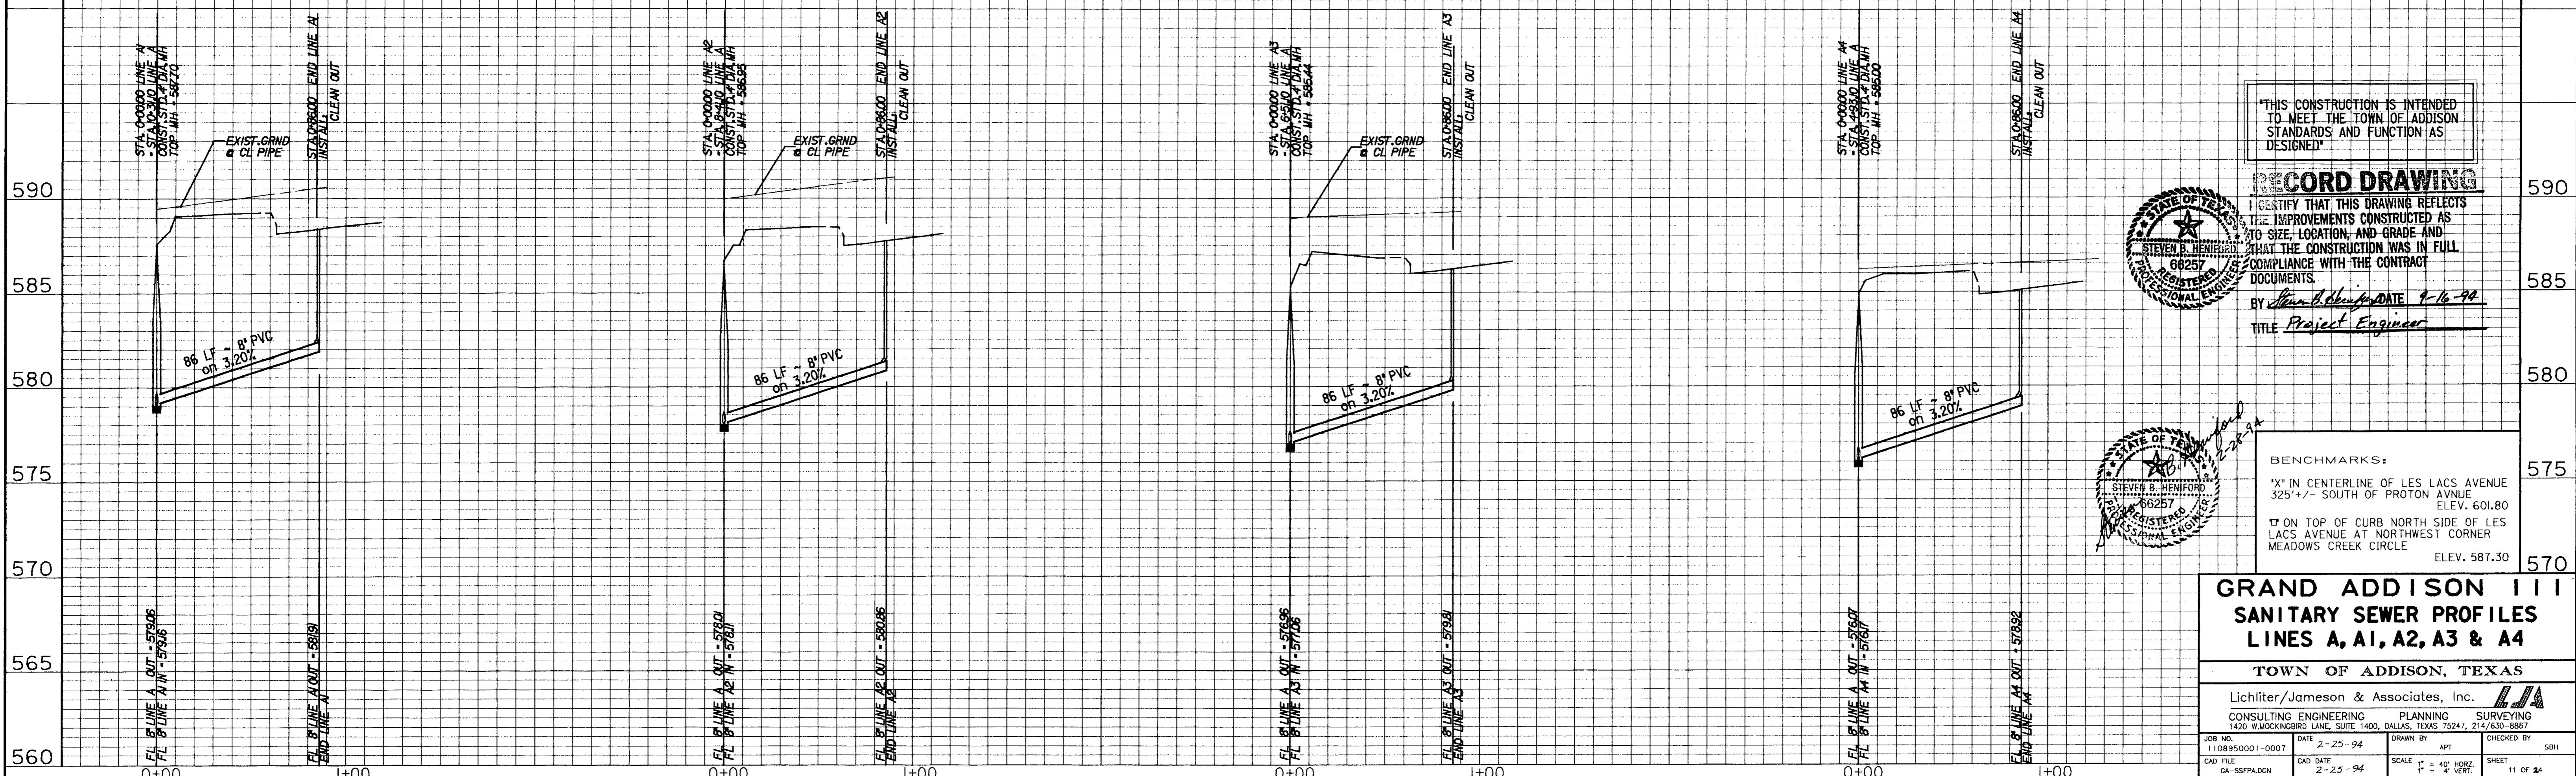


THIS CONSTRUCTION IS INTENDED TO MEET THE TOWN OF ADDISON STANDARDS AND FUNCTION AS DESIGNED.

RECORD DRAWING

I CERTIFY THAT THIS DRAWING REFLECTS THE IMPROVEMENTS CONSTRUCTED AS TO SIZE, LOCATION, AND GRADE AND THAT THE CONSTRUCTION WAS IN FULL COMPLIANCE WITH THE CONTRACT DOCUMENTS.

BY Steven B. Henford DATE 9-16-94
 TITLE Project Engineer

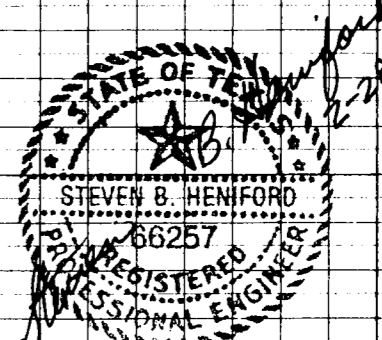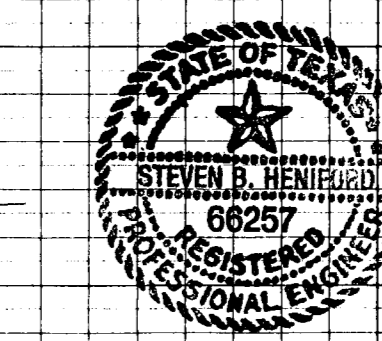

BENCHMARKS:
 *X IN CENTERLINE OF LES LACS AVENUE 325' +/- SOUTH OF PROTON AVENUE. ELEV. 601.80
 *ON TOP OF CURB NORTH SIDE OF LES LACS AVENUE AT NORTHWEST CORNER MEADOWS CREEK CIRCLE. ELEV. 587.30

**GRAND ADDISON III
 SANITARY SEWER PROFILES
 LINES A, A1, A2, A3 & A4**

TOWN OF ADDISON, TEXAS

Lichliter/Jameson & Associates, Inc.
 CONSULTING ENGINEERING SURVEYING
 1420 W. MOCKINGBIRD LANE, SUITE 1400, DALLAS, TEXAS 75247, 214/630-8867

JOB NO. 1108950001-0007	DATE 2-25-94	DRAWN BY APT	CHECKED BY SBH
CAD FILE GA-SSFPALDGN	CAD DATE 2-25-94	SCALE 1" = 40' HORIZ. 1" = 4' VERT.	SHEET 11 OF 24