


SEE SH. 19 FOR DRAINAGE DETAILS  
SEE SH. 6 FOR DRAINAGE GENERAL NOTES

STM. SEW. CURVE DATA 1	STM. SEW. CURVE DATA 2	STM. SEW. CURVE DATA 3
A= 08°55'26"	A= 42°42'29"	A= 42°42'30"
R= 200.00'	R= 50.00'	R= 50.00'
T= 15.61'	T= 19.55'	T= 19.55'
L= 31.51'	L= 37.27'	L= 37.27'

**BENCHMARKS:**  
 \*X' IN CENTERLINE OF LES LACS AVENUE  
 325' +/- SOUTH OF PROTON AVENUE ELEV. 601.80  
 □ ON TOP OF CURB NORTH SIDE OF LES LACS AVENUE AT NORTHWEST CORNER MEADOWS CREEK CIRCLE ELEV. 587.30

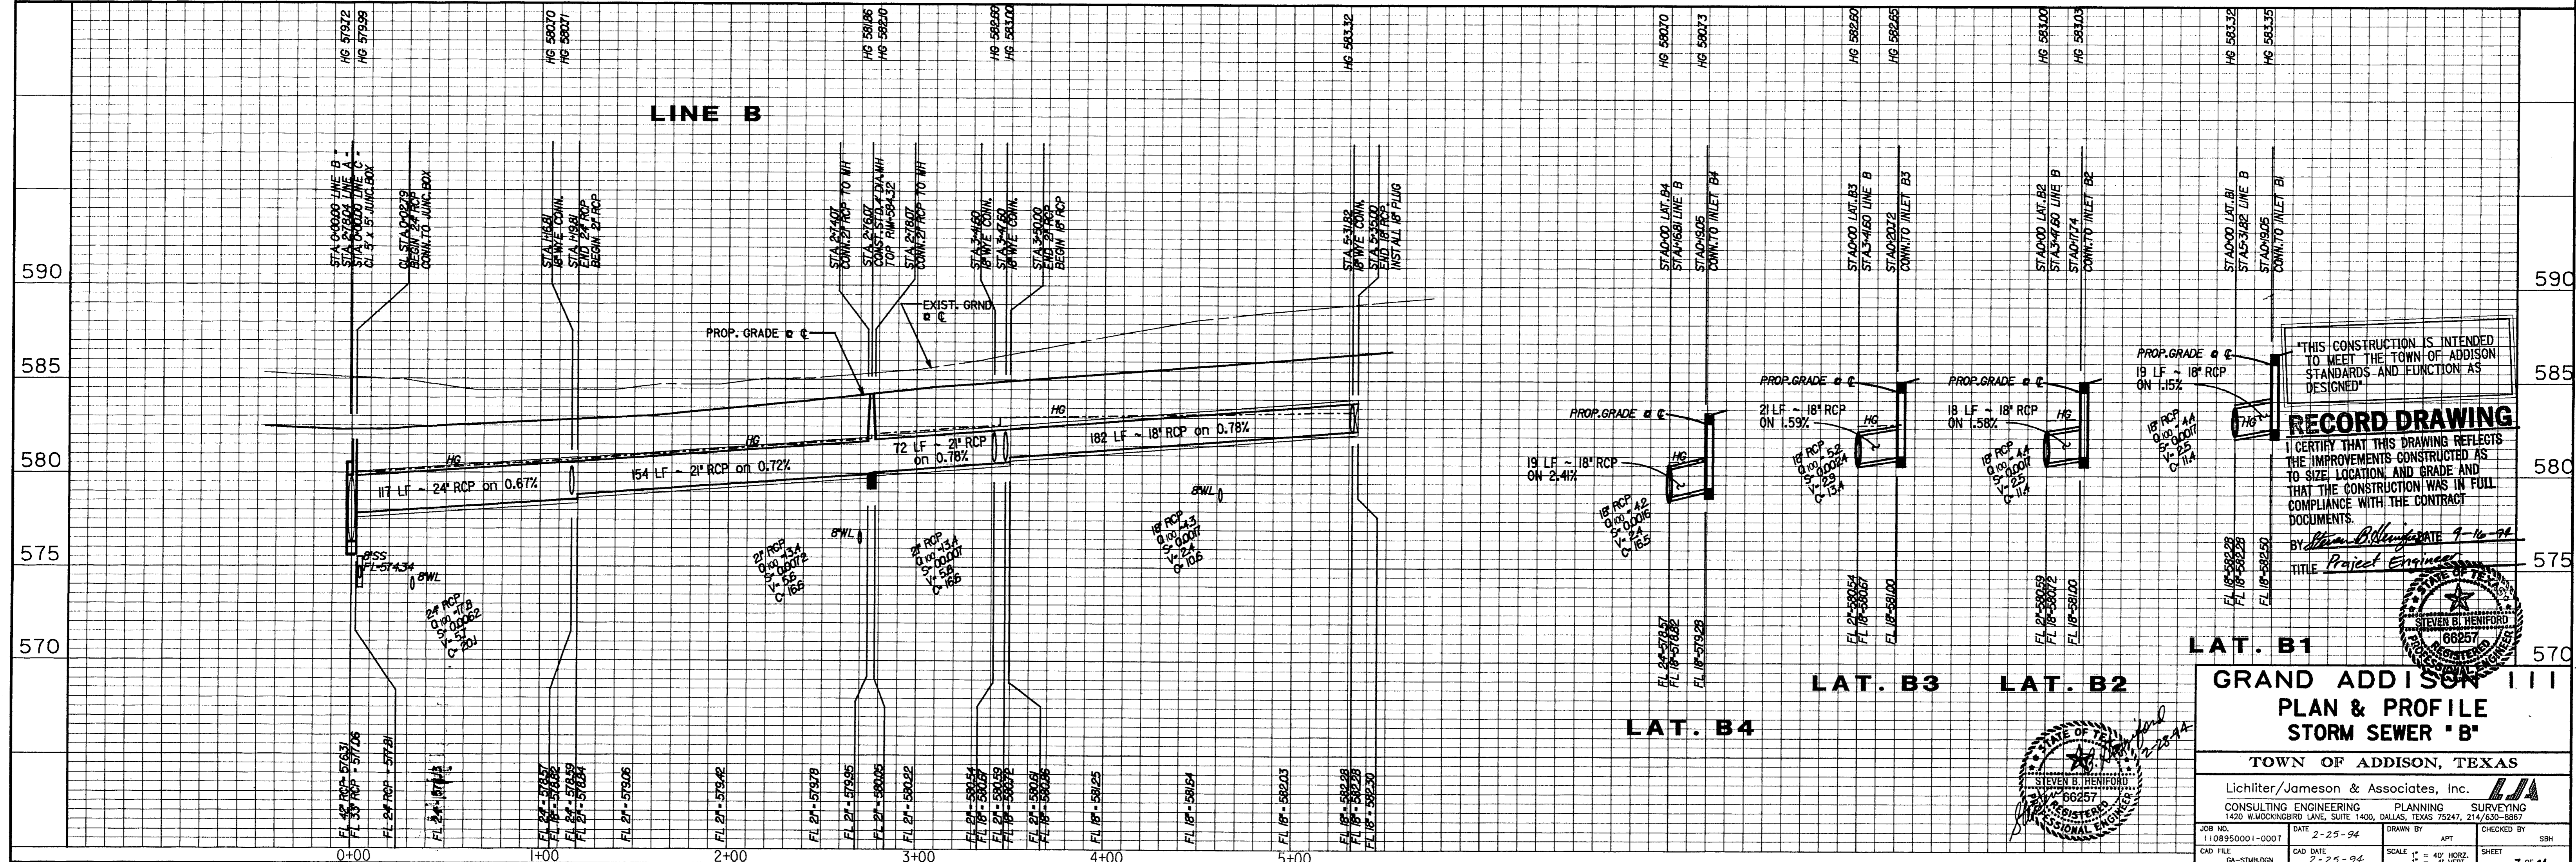


"THIS CONSTRUCTION IS INTENDED TO MEET THE TOWN OF ADDISON STANDARDS AND FUNCTION AS DESIGNED"

**RECORD DRAWING**

I CERTIFY THAT THIS DRAWING REFLECTS THE IMPROVEMENTS CONSTRUCTED AS TO SIZE, LOCATION, AND GRADE AND THAT THE CONSTRUCTION WAS IN FULL COMPLIANCE WITH THE CONTRACT DOCUMENTS.

BY: *Steven B. Heniford* DATE: 9-16-94  
 TITLE: Project Engineer

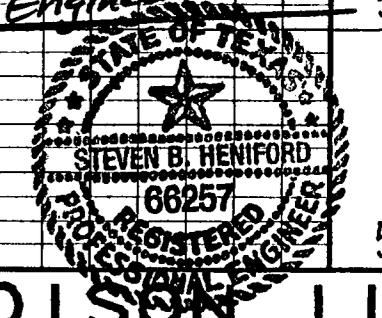

**LAT. B1**

**GRAND ADDISON III  
 PLAN & PROFILE  
 STORM SEWER 'B'**

TOWN OF ADDISON, TEXAS

Lichter/Jameson & Associates, Inc.

CONSULTING ENGINEERING PLANNING SURVEYING  
 1409 WOODSHADOW LANE, SUITE 1400, DALLAS, TEXAS 75247, 214/630-8887

DATE: 2-25-94  
 JOB NO.: 1108950001-0001  
 CAD FILE: 94-STMBLDGN  
 SCALE: 1" = 40' HORIZ. 1" = 4' VERT.  
 SHEET: 7 OF 24