


NOTE: SEE SHIT. 6 FOR PLAN VIEW OF LATERALS SHOWN ON THIS SHEET

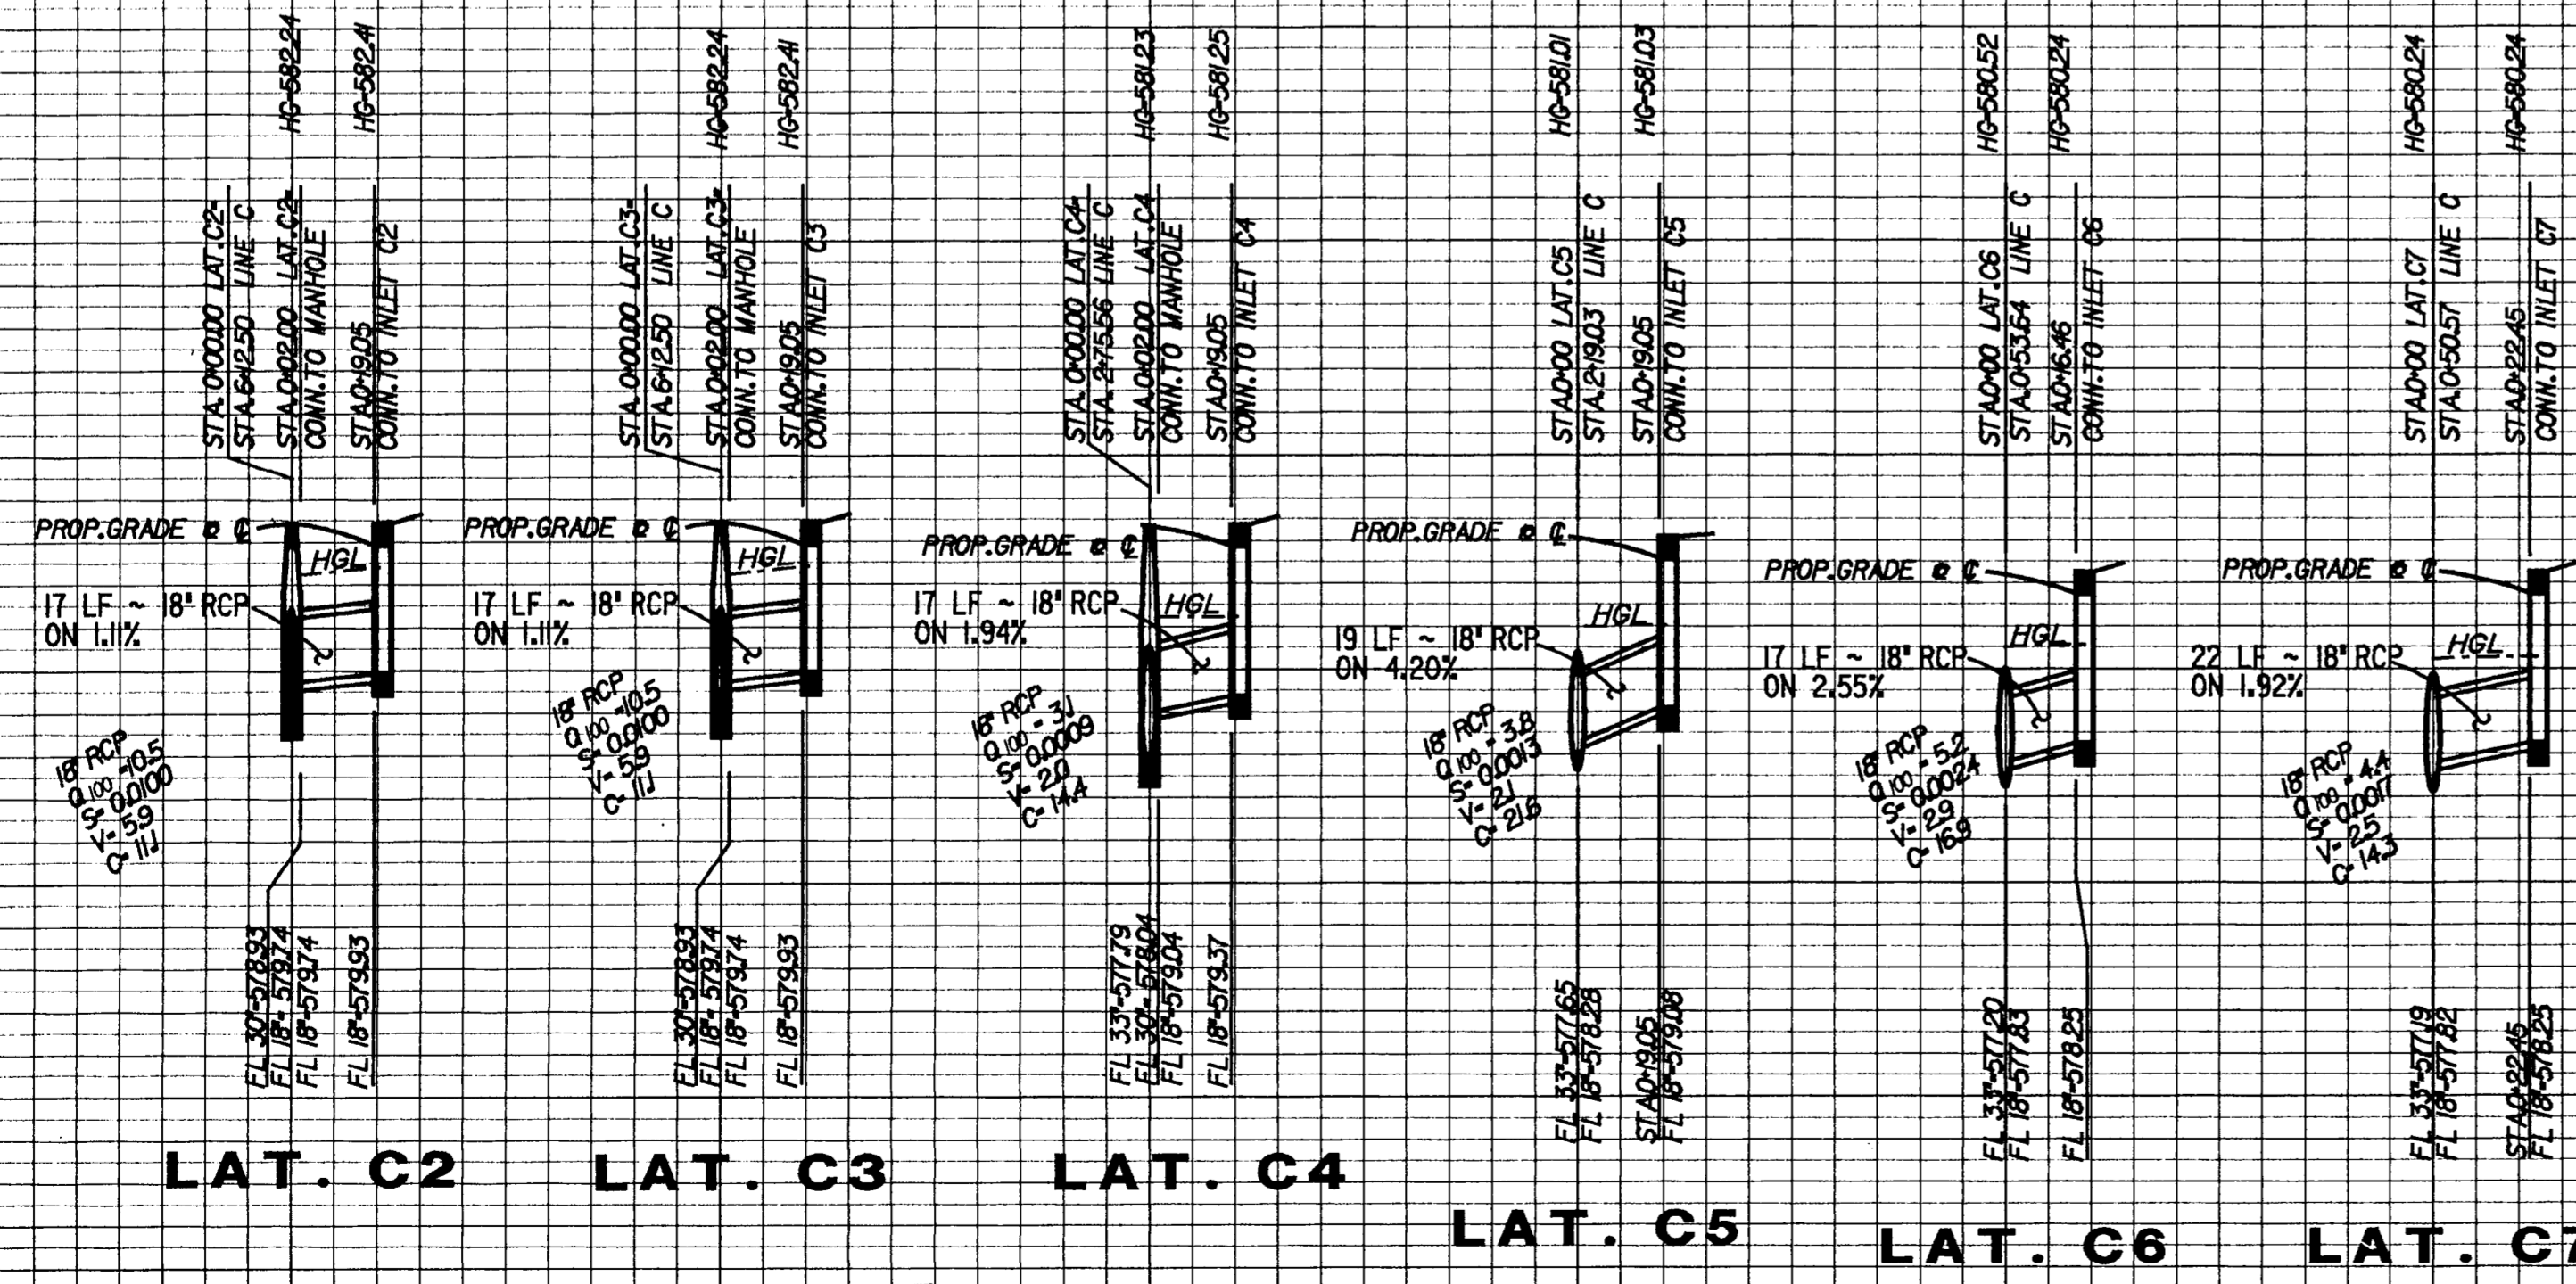


THIS CONSTRUCTION IS INTENDED TO MEET THE TOWN OF ADDISON STANDARDS AND FUNCTION AS DESIGNED

RECORD DRAWING

I CERTIFY THAT THIS DRAWING REFLECTS THE IMPROVEMENTS CONSTRUCTED AS TO SIZE, LOCATION, AND GRADE AND THAT THE CONSTRUCTION WAS IN FULL COMPLIANCE WITH THE CONTRACT DOCUMENTS.

BY Kevin B. Hendrick DATE 9-16-94

TITLE Project Engineer

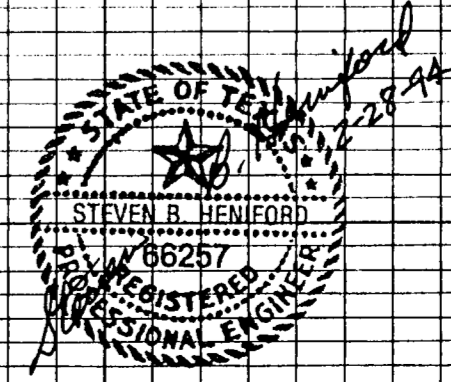

GRAND ADDISON III
PLAN & PROFILE
STORM SEWER LATERALS
 TOWN OF ADDISON, TEXAS

Lichliter/Jameson & Associates, Inc.
 CONSULTING ENGINEERING PLANNING SURVEYING
 1420 W. DUCKINGBIRD LANE, SUITE 1400, DALLAS, TEXAS 75247, 214/630-8867

JOB NO. 1108950001-0007	DATE 2-25-94	DRAWN BY APT	CHECKED BY SBH
CAD FILE DA-STWLT.DGN	CAD DATE 2-25-94	SCALE 1" = 4' HORIZ. 1" = 4' VERT.	SHEET 8 OF 24