


"THIS CONSTRUCTION IS INTENDED TO MEET THE TOWN OF ADDISON STANDARDS AND FUNCTION AS DESIGNED"

RECORD DRAWING

I CERTIFY THAT THIS DRAWING REFLECTS THE IMPROVEMENTS CONSTRUCTED AS TO SIZE, LOCATION, AND GRADE AND THAT THE CONSTRUCTION WAS IN FULL COMPLIANCE WITH THE CONTRACT DOCUMENTS.

BY Steven B. Jameson DATE 9-16-94
TITLE Project Engineer

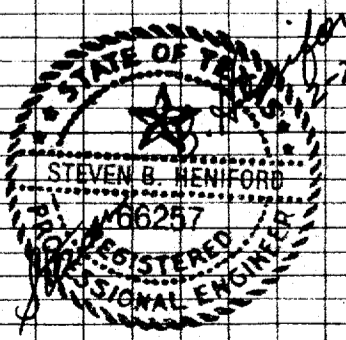

BENCHMARKS:
 * IN CENTERLINE OF LES LACS AVENUE
 325' +/- SOUTH OF PROTON AVENUE
 ELEV. 601.80
 □ ON TOP OF CURB NORTH SIDE OF LES
 LACS AVENUE AT NORTHWEST CORNER
 MEADOWS CREEK CIRCLE
 ELEV. 587.30

**GRAND ADDISON III
 SANITARY SEWER PROFILES
 LINES B, B1, B2, B3, B4, B5 & B6**

TOWN OF ADDISON, TEXAS

Lichtler/Jameson & Associates, Inc. **LJA**
 CONSULTING ENGINEERING PLANNING SURVEYING
 1420 W. LOCKINGBARR LANE, SUITE 1400, DALLAS, TEXAS 75247, 214/630-8887
 JOB NO. 1108950001-0007 DATE 2-25-94 DRAWN BY APT CHECKED BY SBH
 CAD FILE GA-SSFPB.DGN DATE 2-25-94 SCALE 1" = 4' HORIZ. SHEET 12 OF 24
 P = 4" VERT.