


"THIS CONSTRUCTION IS INTENDED TO MEET THE TOWN OF ADDISON STANDARDS AND FUNCTION AS DESIGNED"

RECORD DRAWING

I CERTIFY THAT THIS DRAWING REFLECTS THE IMPROVEMENTS CONSTRUCTED AS TO SIZE, LOCATION, AND GRADE AND THAT THE CONSTRUCTION WAS IN FULL COMPLIANCE WITH THE CONTRACT DOCUMENTS.

BY *Steven B. Heniford* DATE *9-16-94*
TITLE *Project Engineer*

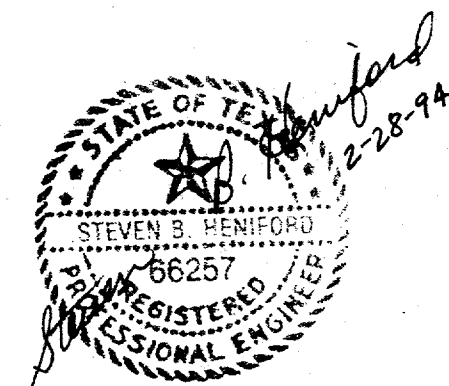

GRAND ADDISON III GRADING PLAN

TOWN OF ADDISON, TEXAS

Lichliter/Jameson & Associates, Inc. CONSULTING ENGINEERING & PLANNING SURVEYING
1420 W. ROCKWELL LANE, SUITE 1400, DALLAS, TEXAS 75247, 214/630-8887

| | | | |
|-------------------------|------------------|----------------|-------------------|
| JOB NO. 1108950001-0007 | DATE 2-25-94 | DRAWN BY | CHECKED BY S.B.H. |
| CAD FILE GA-GRAD.DGN | CAD DATE 2-25-94 | SCALE 1" = 40' | SHEET 13 OF 24 |