


AS BUILT PLANS
 THE INTENT OF THE OWNER WAS TO CONSTRUCT
 THE IMPROVEMENTS ACCORDING TO THESE PLANS
 AS APPROVED BY THE CITY. THE LINES AND
 GRADES WERE SET ON THE GROUND FOR CON-
 STRUCTION ACCORDING TO SAID PLANS. THE
 OWNER OR ENGINEER DID NOT VERIFY LINES OR
 GRADES AFTER CONSTRUCTION. WE ARE NOT
 AWARE OF ANY CHANGES OR REVISIONS TO THESE
 PLANS DURING CONSTRUCTION OTHER THAN
 THOSE SHOWN
 BY
 FERGUSON-DEERE, INC.
 DATE 1/21/86

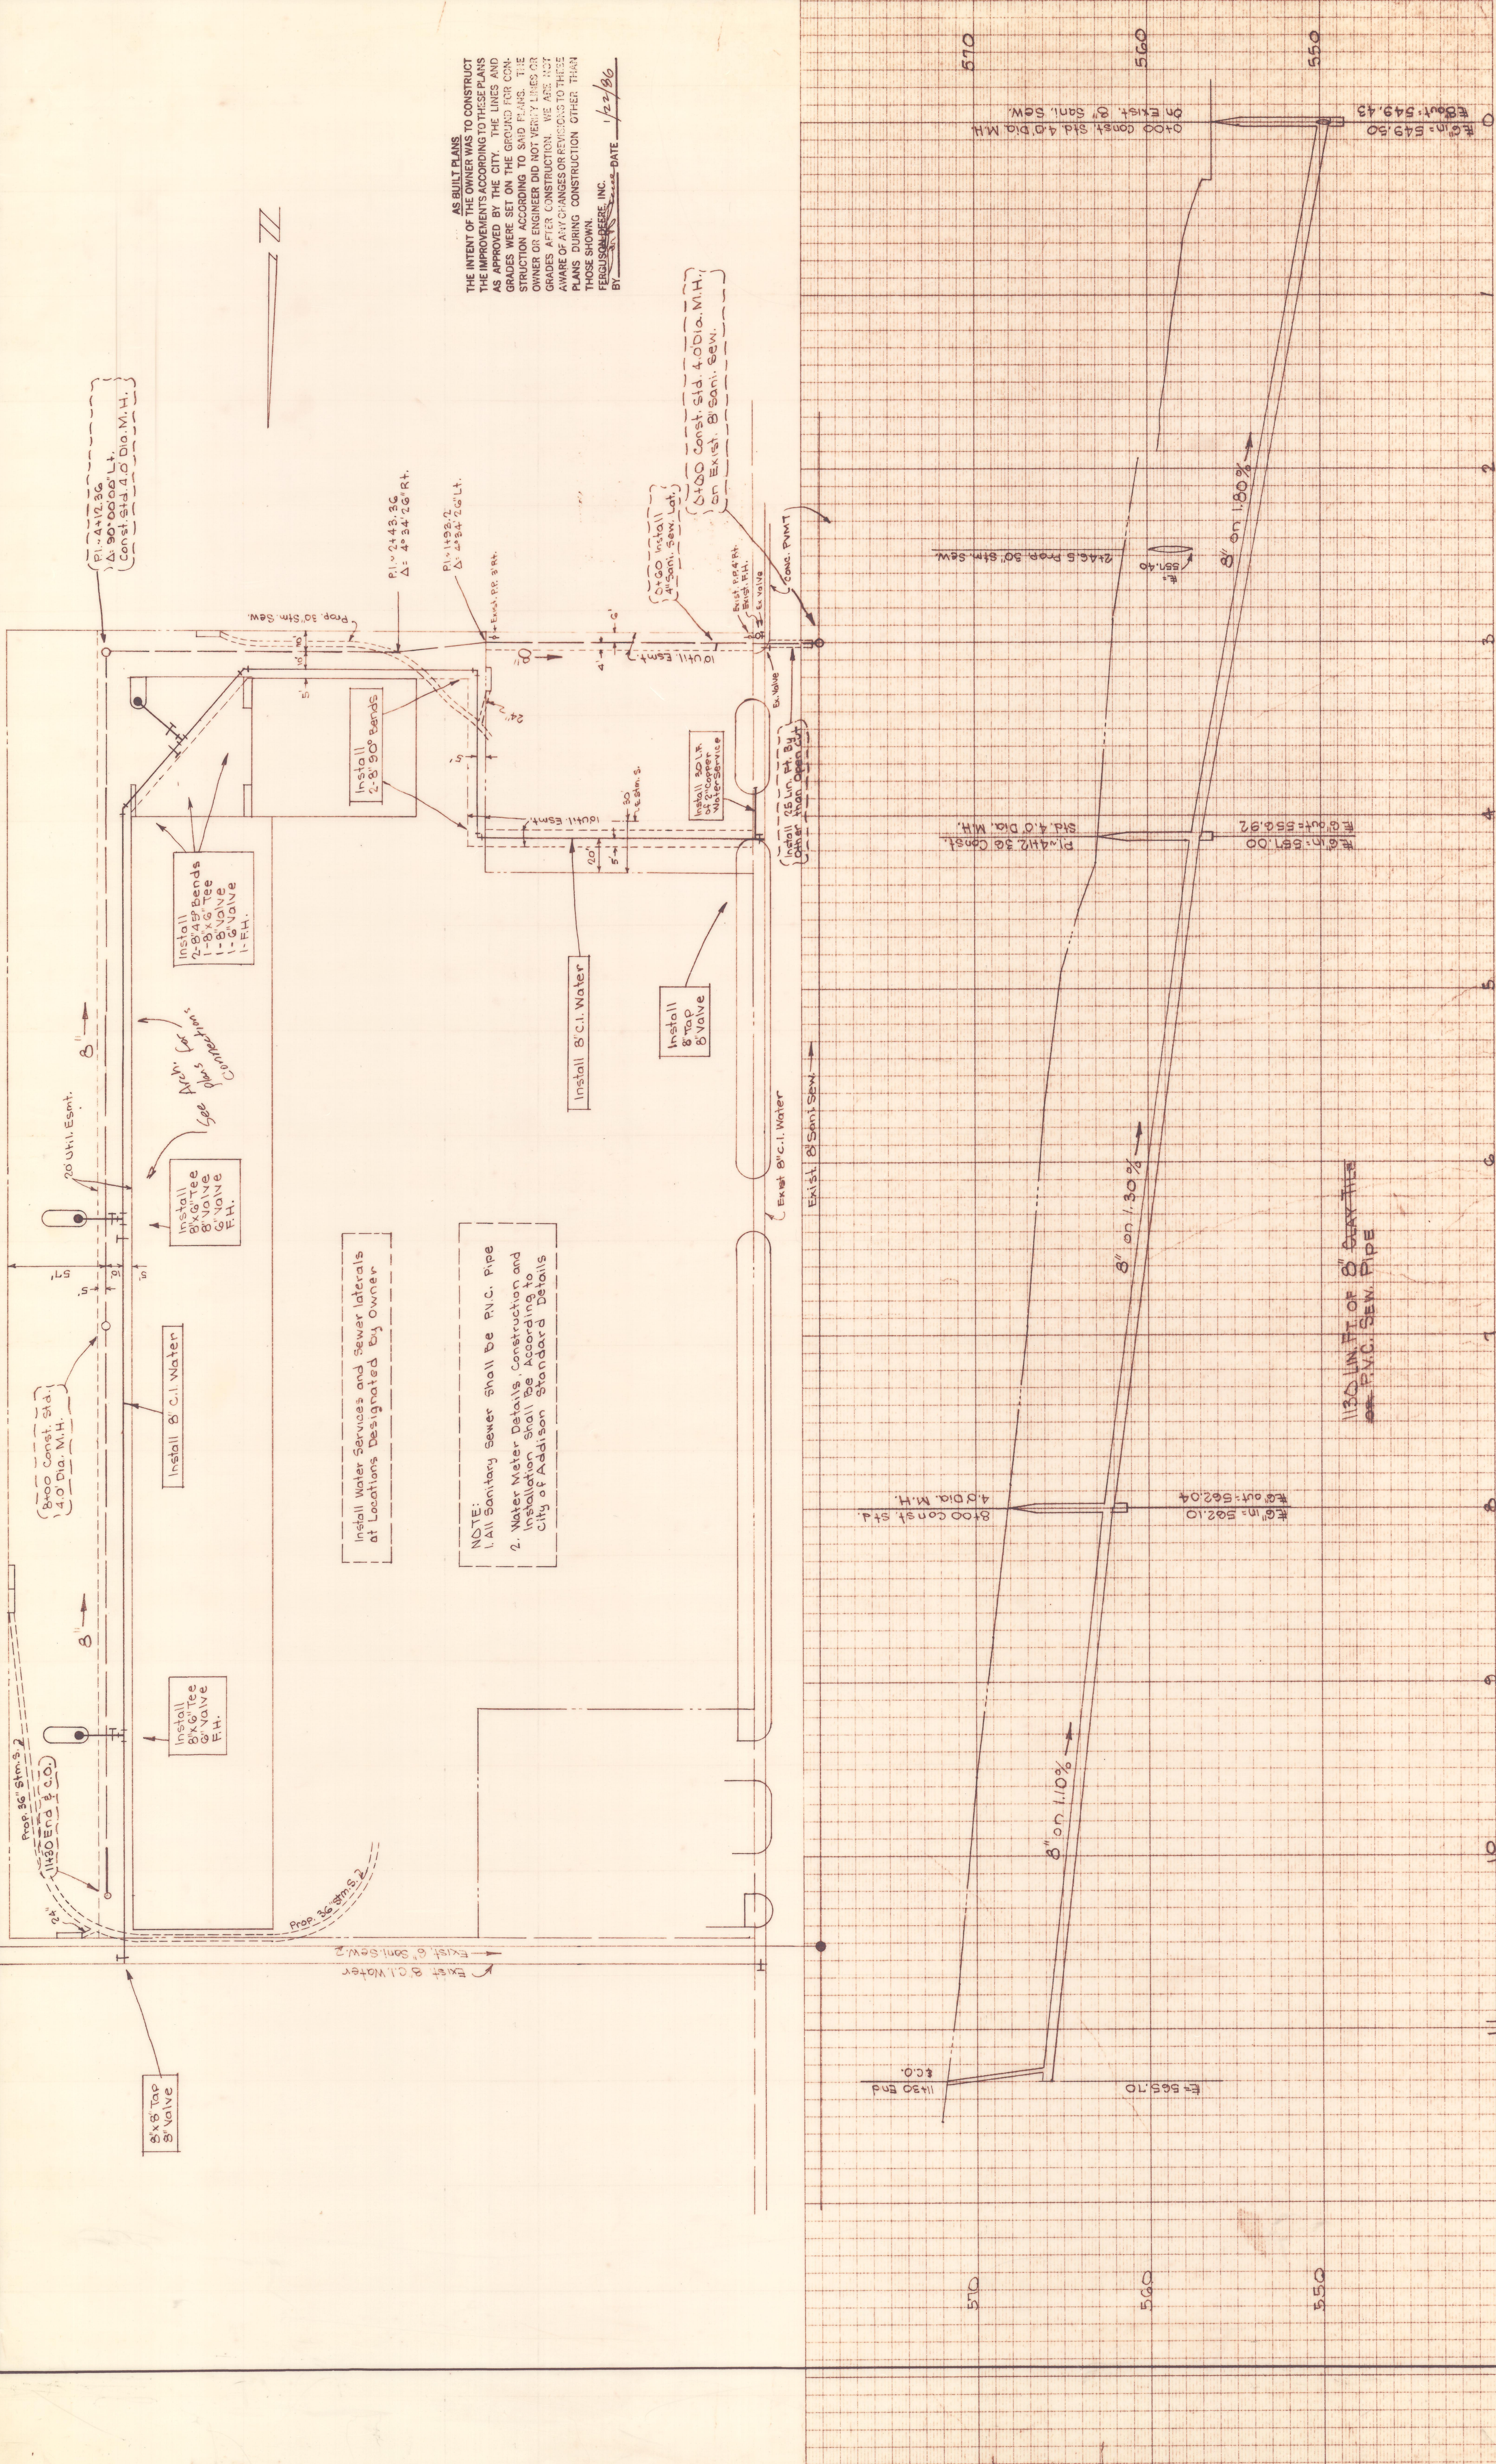

NOTE:
 1. All Sanitary Sewer shall be P.V.C. Pipe
 2. Water Meter Details, Construction and
 Installation shall be according to
 City of Addison Standard Details

Install Water Services and Sewer laterals
 at Locations Designated by Owner

NO. 1245-PAN PROFILE PLATE A "CLEARPRINT PAPER CO." MADE IN U.S.A.		REVISION BY B.C. DATE 5/20/85	COMMENT P.V.C. PIPE & WATER METER NOTE ADDED
FERGUSON-DEERE, INC. CONSULTING ENGINEERS 9801 W. LAKELAND DALLAS, TEXAS 75238 PHONE 348-2821 DATE OCT. 18, 1984		SCALE H-1"=40' V-1"=6' SHEET NO. CE/1	WATER & SEWER MAINS GREENHAVEN VILLAGE SHOPPING CTR. ADDITION