

LES LECS VILLAGE PHASE I
V. 83183, P. 4319


832.63'

PROTON PLAZA
V. 81001, P. 2042

- BM #2: Top nut of FH near west line of site 675ft north of southwest corner of site. Elev. 601.31
- BM #3: Cut "x" in walk on outside of curved drive near southeast corner of lower school. Elev. 586.06
- BM #4: "x" cut - west end conc. headwall, north side Spring Valley, at southeast corner campus. Elev. 578.47
- BM #5: "x" cut in walk at southeast corner intersection of drive along south side of preschool building and north-south drive into site from Spring Valley. Elev. 588.20
- BM #6: "x" cut at southwest corner basketball courts, southeast of gymnasium. Elev. 597.48
- BM #7: "x" cut, southwest corner transformer pad, northeast of tennis courts. Elev. 601.42
- BM #8: Top nut of FH at west end of drive along north side of campus. Elev. 609.80
- BM #9: "x" cut at NEC of electric MH on north side cafeteria, south side of drive along north side of campus. Elev. 602.80
- BM #10: "x" cut on conc. step near northwest corner of upper school. Elev. 598.85
- BM #11: "x" cut on conc step on walk exiting west side of library. Elev. 596.44
- BM #12: "x" cut at intersection of walk along west side lower school and walk along south side lower school. Elev. 587.78

- LEGEND**
- PH ○ FIRE HYDRANT
 - MH ○ MANHOLE
 - GI ○ GRATE INLET
 - CV ○ CONTROL VALVE
 - WV ○ WATER VALVE
 - WM ○ WATER METER
 - LS ○ LIGHT STANDARD
 - CO ○ CLEAN OUT
 - PP ○ POWER POLE
 - HO ○ HOSE BIB
 - WF ○ WATER FOUNTAIN
 - GM ○ GAS METER
 - CM ○ 4" CONC. MONUMENT
 - PL ○ PROPERTY LINE

TOPOGRAPHIC SURVEY
OF
A PORTION OF GREENHILL SCHOOL
THOMAS L. CHENOWETH SURVEY, ABSTRACT 273
CITY OF ADDISON, DALLAS COUNTY, TEXAS

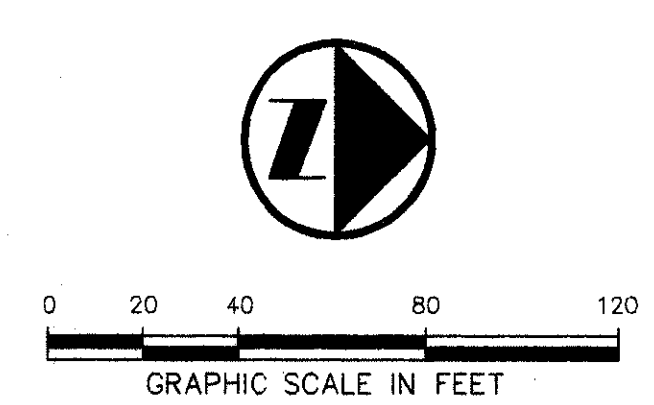

LOCATIONS AND SIZES OF UNDERGROUND UTILITIES HAVE BEEN REPRODUCED FROM RECORD INFORMATION ON FILE AT THE CITY OF ADDISON AND GREENHILL SCHOOL.

PACHECO KOCH Consulting Engineers, Inc.		9401 LBJ Freeway, Suite 800 Dallas, Texas 75243 (214) 235-3031	
DRAWN BY CAH	CHECKED BY JAK	SCALE 1"=40'	DATE JULY 1993
		JOB NUMBER 1082-93.121	UPDATED JULY 26, 1993

FIRE LANE EASEMENT
VOL. 85167, PG. 4650