


LES LECS VILLAGE (MONTE VNA)
V. 83038, P. 328

LES LECS VILLAGE PHASE I
V. 83183, P. 4319

- BM #2: Top nut of FH near west line of site 675± north of southwest corner of site. Elev. 601.31
- BM #3: Cut "x" in walk on outside of curved drive near southeast corner of lower school. Elev. 586.06
- BM #4: "□" cut in west end conc. headwall, north side Spring Valley, at southeast corner campus. Elev. 578.47
- BM #5: "□" cut in walk at southeast corner intersection of drive along south side of preschool building and north-south drive into site from Spring Valley. Elev. 588.20
- BM #6: "□" cut at southwest corner basketball courts, southeast of gymnasium. Elev. 597.48
- BM #7: "□" cut, southeast corner transformer pad, northeast of tennis courts. Elev. 601.42
- BM #8: Top nut of FH at west end of drive along north side of campus. Elev. 609.80
- BM #9: "□" cut at NEC of electric MH on north side cafeteria, south side of drive along north side of campus. Elev. 602.80
- BM #10: "□" cut on conc. step near northwest corner of upper school. Elev. 598.85
- BM #11: "□" cut on conc. step on walk exiting west side of library. Elev. 596.44
- BM #12: "□" cut at intersection of walk along west side lower school and walk along south side lower school. Elev. 587.78

- LEGEND**
- ⊙ FIRE HYDRANT
 - ⊕ MANHOLE
 - ⊙ GRATE INLET
 - ⊕ CONTROL VALVE
 - ⊕ WATER VALVE
 - ⊕ WATER METER
 - ⊕ LIGHT STANDARD
 - ⊕ CLEAN OUT
 - ⊕ POWER POLE
 - ⊕ HOSE BIB
 - ⊕ WATER FOUNTAIN
 - ⊕ CONC. MONUMENT
 - ⊕ GAS METER
 - PROPERTY LINE

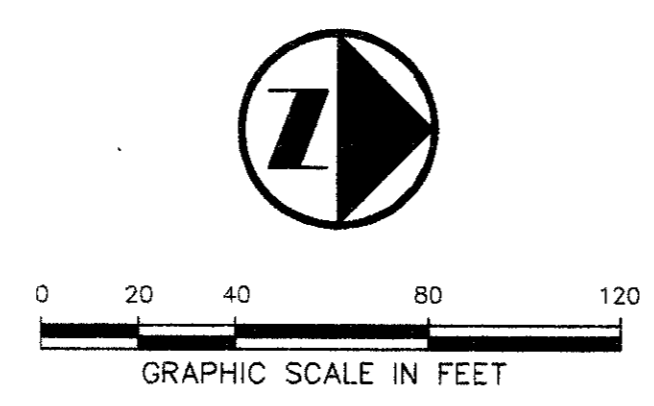

NOTE
LOCATIONS AND SIZES OF UNDERGROUND UTILITIES SHOWN ARE BASED ON INFORMATION ON FILE AT GREENHILL, CITY OF ADDISON AND VERBAL DISCUSSION WITH GREENHILL PERSONNEL.

TOPOGRAPHIC SURVEY
OF
A PORTION OF GREENHILL SCHOOL
THOMAS L. CHENOWETH SURVEY, ABSTRACT 273
CITY OF ADDISON, DALLAS COUNTY, TEXAS

PACHECO KOCH Consulting Engineers, Inc. 9401 LBJ Freeway, Suite 800 Dallas, Texas 75248 (214) 286-9081

DRAWN BY CAH/NDC	CHECKED BY JAK	SCALE 1"=40'	DATE AUG 1993	JOB NUMBER 1082-93.121
---------------------	-------------------	-----------------	------------------	---------------------------

UPDATED JULY 26, 1993