

# CONSTRUCTION PLANS FOR **GREENHILL SCHOOL DEASON FAMILY TENNIS CENTER**

**FOR**


**HIDELL ASSOCIATES**  
3033 Kellway Drive, Suite 120  
Carrollton, Texas 75006  
Ph. (972) 416-4666

**OWNER/DEVELOPER**

**GREENHILL SCHOOL**  
14255 Midway Road  
Dallas, Texas 75224  
Ph. (972) 661-1211

**PREPARED BY**

 **Pacheco Koch Consulting Engineers**  
9401 LBJ FREEWAY SUITE 300 DALLAS, TEXAS 75243 972.235.3031

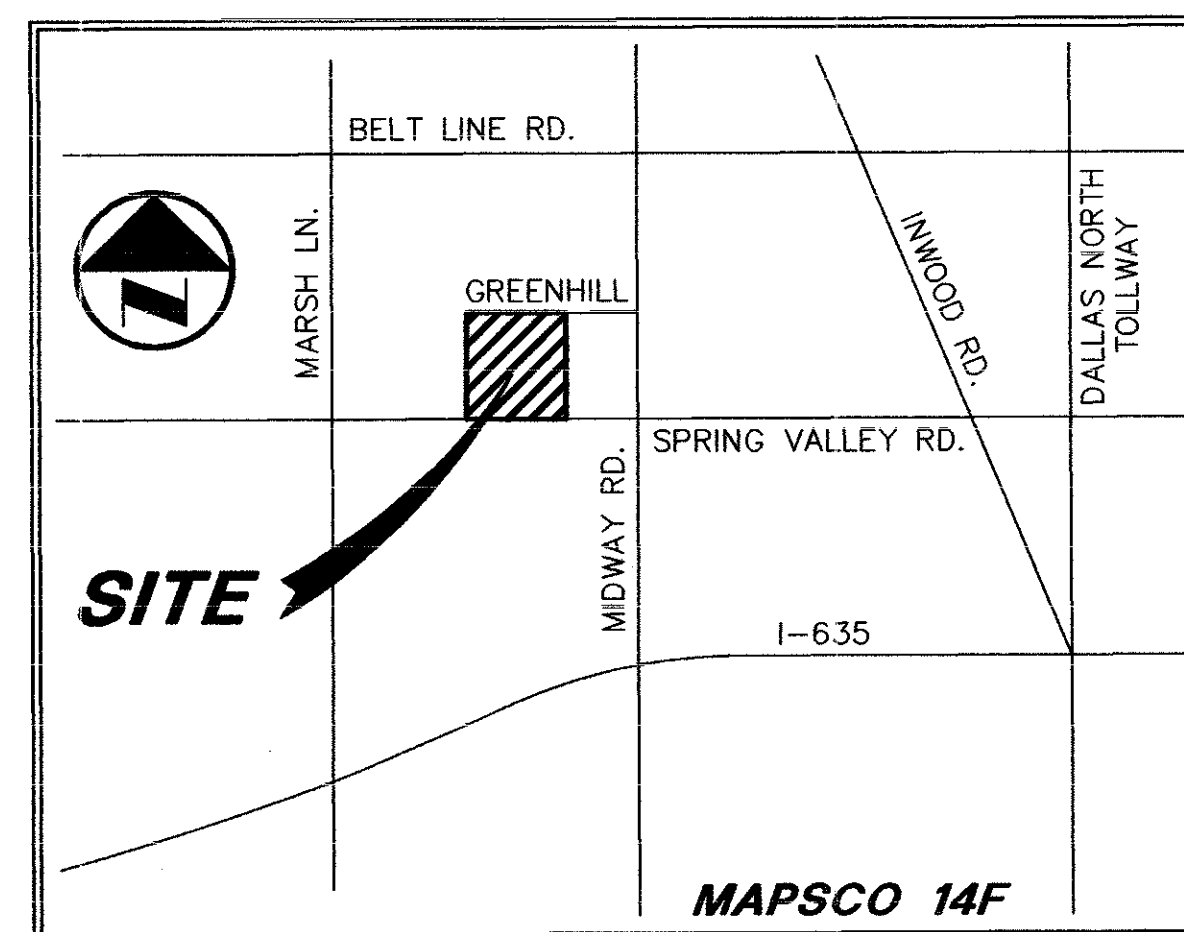

**VICINITY MAP**

**DRAWING SHEET INDEX**

SHEET	DESCRIPTION
<b>C1.0</b>	<b>DIMENSIONAL CONTROL PLAN</b>
<b>C2.0</b>	<b>GRADING PLAN</b>
<b>C3.0</b>	<b>DRAINAGE PLAN</b>
<b>C4.0</b>	<b>WATER RELOCATION PLAN</b>
<b>C5.0</b>	<b>EROSION CONTROL PLAN</b>

**RECORD DRAWING**

THIS DRAWING HAS BEEN REVISED TO REFLECT CONSTRUCTION RECORDS MAINTAINED AND PROVIDED BY THE CONTRACTOR FOR THIS PROJECT.

CONTRACTOR: *Australian Courtworks, Inc.*  
DATE REVISED: 03/20/2001



THE SEAL APPEARING ON THIS DOCUMENT WAS AUTHORIZED BY STEVEN A. MARKUSSEN P.E. 70090 ON 06/26/00 ALTERATION OF A SEALED DOCUMENT WITHOUT PROPER NOTIFICATION TO THE RESPONSIBLE ENGINEER IS AN OFFENSE UNDER THE TEXAS ENGINEERING PRACTICE ACT.

△ REVISED 03/22/2001