

CONSTRUCTION PLANS FOR GREENHILL SCHOOL DEASON FAMILY TENNIS CENTER

FOR


HIDELL ASSOCIATES
3033 Kellway Drive, Suite 120
Carrollton, Texas 75006
Ph. (972) 416-4666

OWNER/DEVELOPER

GREENHILL SCHOOL
14255 Midway Road
Dallas, Texas 75224
Ph. (972) 661-1211

PREPARED BY

 **Pacheco Koch Consulting Engineers**
9401 LBJ FREEWAY SUITE 300 DALLAS, TEXAS 75243 972.235.3031

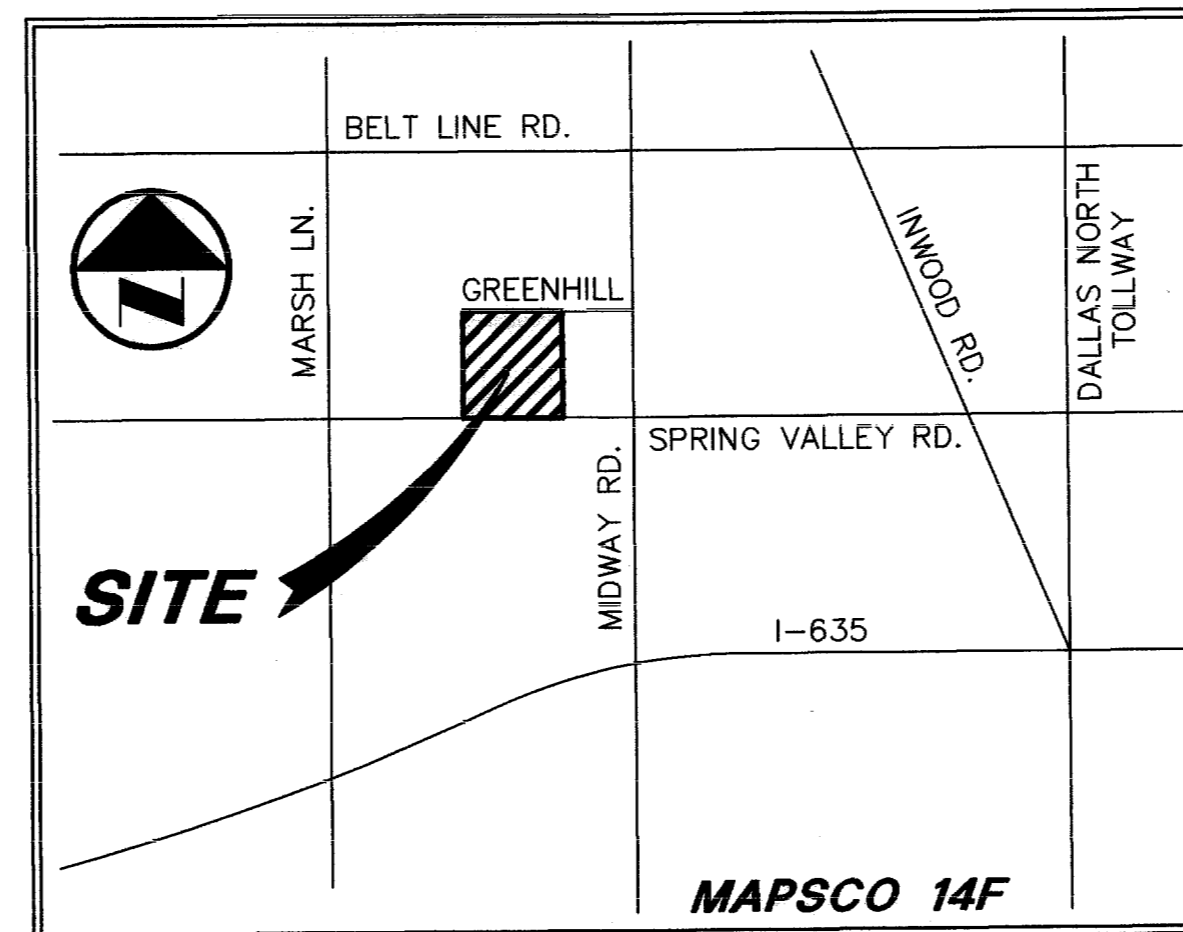

VICINITY MAP

DRAWING SHEET INDEX

SHEET	DESCRIPTION
C1.0	DIMENSIONAL CONTROL PLAN
C2.0	GRADING PLAN
C3.0	DRAINAGE PLAN
C4.0	WATER RELOCATION PLAN
C5.0	EROSION CONTROL PLAN

RECORD DRAWING

THIS DRAWING HAS BEEN REVISED TO REFLECT CONSTRUCTION RECORDS MAINTAINED AND PROVIDED BY THE CONTRACTOR FOR THIS PROJECT.

CONTRACTOR: *Australian Courtworks, Inc.*
DATE REVISED: 03/20/2001



THE SEAL APPEARING ON THIS DOCUMENT WAS AUTHORIZED BY STEVEN A. MARKUSSEN P.E. 70090 ON 06/28/00. ALTERATION OF A SEALED DOCUMENT WITHOUT PROPER NOTIFICATION TO THE RESPONSIBLE ENGINEER IS AN OFFENSE UNDER THE TEXAS ENGINEERING PRACTICE ACT.

△ REVISED 03/22/2001