

CONSTRUCTION PLANS


FOR

WESTFIELD COURT

TOWN OF ADDISON, TEXAS

GENERAL NOTES


- A. Prior to final acceptance by the Town of Addison.
- 1) A Texas Registered Professional engineer shall certify that the project was constructed in accordance with the plans and specifications approved by the Town of Addison.
 - The owner shall provide 1 reproducible set of as-builts (sealed and certified by a Texas Registered Engineer) and 2 blue line sets.
 - 2) A five foot sidewalk shall be installed along Proton Drive and Les Lacs Avenue. See attached detail.
 - 4) A one year maintenance bond is required for the internal subdivision infrastructure.
 - 5) Contractor shall demonstrate that the water and sanitary sewer systems meet the proper pressure, bacteria, and mandrel tests. In addition, the owner shall provide a VHS format video tape of the sanitary sewer.
- B. Prior to starting construction, the contractor shall contract the utility companies to locate existing facilities. These include but may not be limited to the following:
- 1) Town of Addison
 - 2) Lone Star Gas
 - 4) Southwestern Bell
 - 5) Storer Cable
 - 6) Planned Cable Systems
 - 7) TU Electric
- C. Prior to beginning construction, the owner or his authorized representative shall convene a Pre-Construction Conference between the Town of Addison, Consulting Engineer, Contractor(s), utility companies and any other affected parties. Notify Bruce Ellis 450-2847 at least 48-hours prior to the time of the conference and 48-hours prior to beginning of construction.
- D. Any existing pavement, curbs, and/or sidewalks damaged or removed will be repaired by the contractor at their expense.
- E. Lot pins shall be in place during construction and prior to final acceptance. Concrete monuments shall be placed as shown on the final plat and iron pins shall be placed at block corners, curve points and angle points in public right-of-way. Concrete monuments shall be six (6) inches in diameter and twenty-four (24) inches long. An iron rod one-half inch in diameter embedded at least three (3) inches in the monument at the exact intersection point of the monument. The monuments shall be set at such an elevation that after construction, the top of the monument will be not less than twelve (12) inches below the ground surface.
- F. The contractor shall stamp a 2-inch "S" in the curb at the location of the sewer service line.
- G. At intersections that have valley drainage, the crown of the intersecting streets will culminate in a distance of 40 feet from the intersecting curb line unless otherwise noted.
- H. Temporary or permanent street barricades shall remain at all points of ingress and egress to prevent public use until such street received final acceptance.
- I. Contractor shall obtain a right-of-way permit by the Town of Addison for working within the public right-of-way.
- J. During construction, the owner shall provide a qualified geotechnical lab to perform materials testing during the construction, at the request of the Town of Addison.
- K. The contractor shall submit material sheets to the Town of Addison for approval prior to incorporating materials into the job.
- L. The utility contractor shall submit to the Town of Addison for approval a trench safety plan sealed by a registered professional engineer for the installation of utilities greater than five (5) feet in depth.

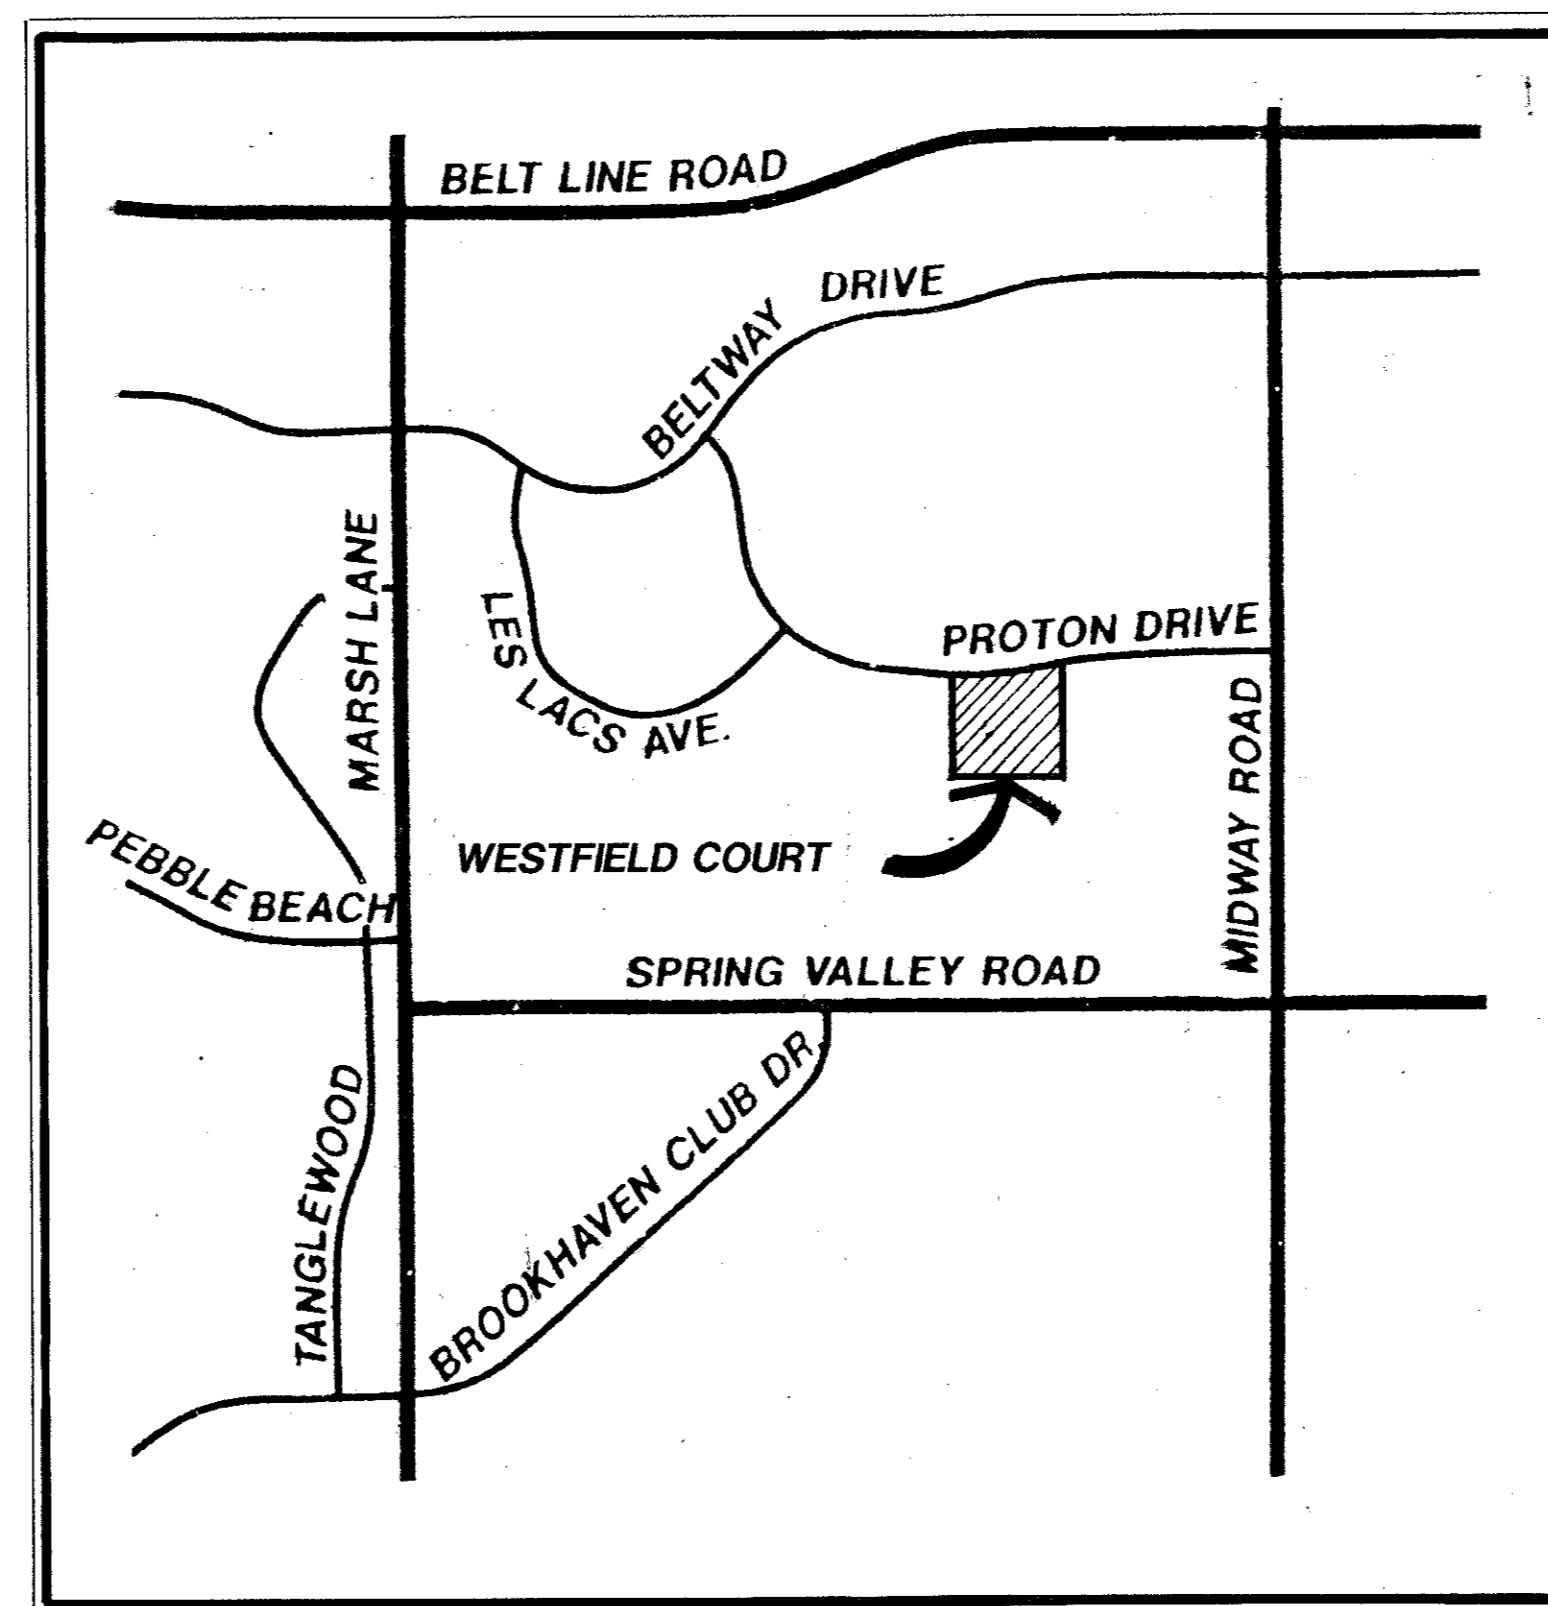

LOCATION MAP
NOT TO SCALE

SHEET NO.	DESCRIPTION
FP-1	FINAL PLAT
PAVING PLAN AND PROFILE	
P-1	PAVING PLAN AND PROFILE
P-2	PAVING PLAN AND PROFILE
WATER & SANITARY SEWER	
WS-1	WATER & SANITARY SEWER PLAN
WS-2	SANITARY SEWER PROFILES
DRAINAGE PLAN AND PROFILES	
DA-1	DRAINAGE AREA MAP
DR-1	DRAINAGE PLAN & PROFILE
GR-1	GRADING PLAN
CONSTRUCTION PLANS	
D-1 THRU D-10	CONSTRUCTION DETAILS

AS BUILT

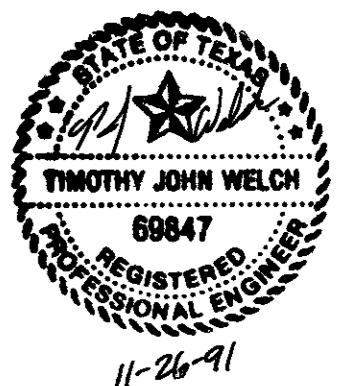

ENGINEER

THE NELSON CORPORATION
5999 SUMMERSIDE DR., SUITE 202
DALLAS, TEXAS 75252
(214) 380-2605

APPLICANT

ARCADIA REALTY CORP.
415 W. WALL, SUITE 2018
MIDLAND, TEXAS 79702
(915) 683-3386

OWNER

WARWICK INVESTMENTS, INC.
2777 STEMMONS FREEWAY
DALLAS, TEXAS 75207
(214) 689-2206