


5-7-91
 Plz contact 450-2821 Re: removal of grass trap + installation of underground fuel tanks
 5-9-91 - ok after conversation with Mark Sullivan
 Neil

Demolition Plan
 SCALE: 1"=20.0'

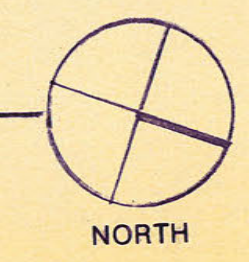

REVISIONS	DATE

**RENOVATION AND ADDITION TO
 QUORUM VINEYARD RETAIL CENTER
 ADDISON, TEXAS**


**SULLIVAN
 KEY
 MERRILL**

Architects and Planners, Inc.
 1530 Main Street, Fourth Floor
 Dallas, Texas 75201
 214-761-0505


REGISTERED ARCHITECT
 STATE OF TEXAS
 4-1991

CHECKED
DRAWN
DATE 4/1/91
PRINT DATE



PROJECT NO. 8922
SHEET TITLE DEMOLITION PLAN
SHEET NO. A 02

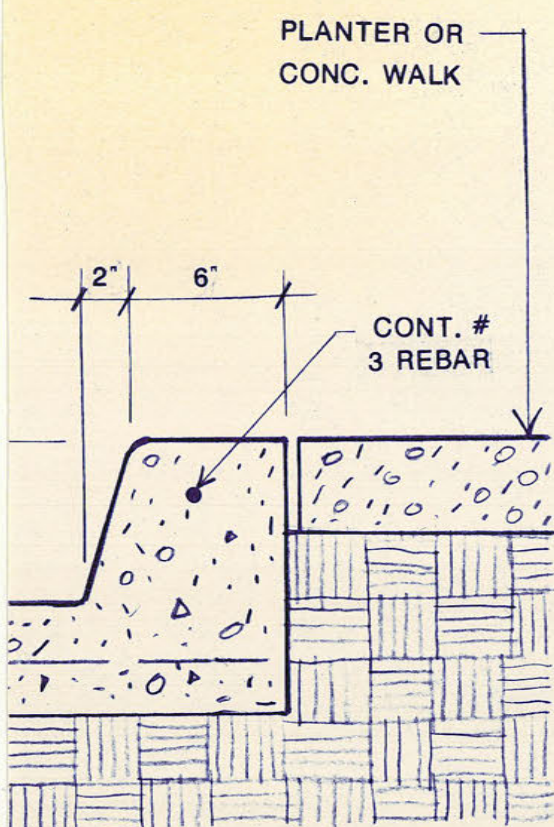


03 Paving Detail
NOT TO SCALE

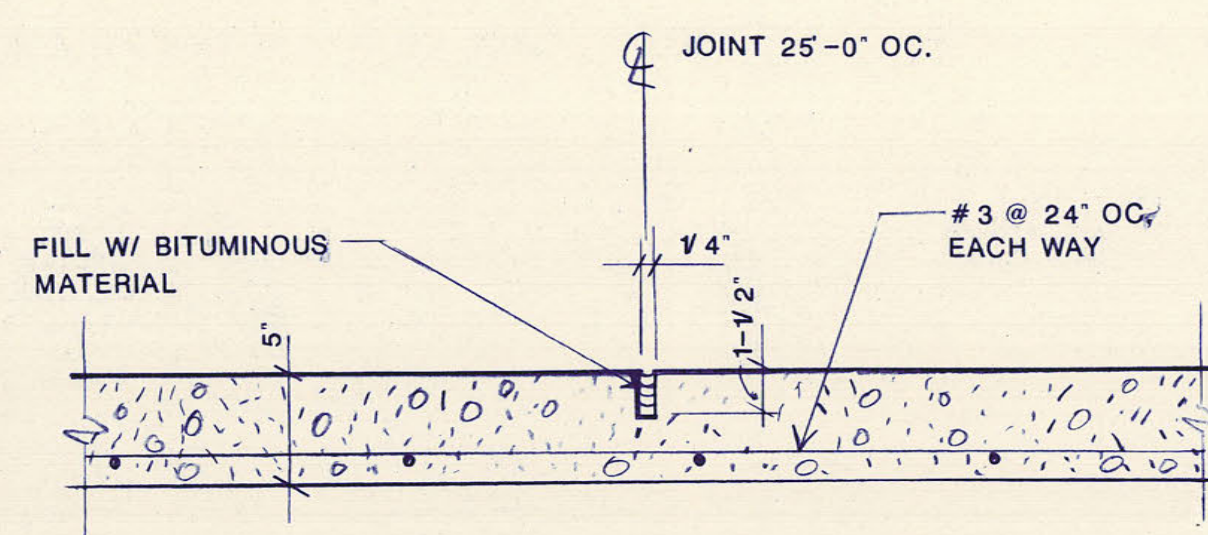

04 Paving Detail
NOT TO SCALE

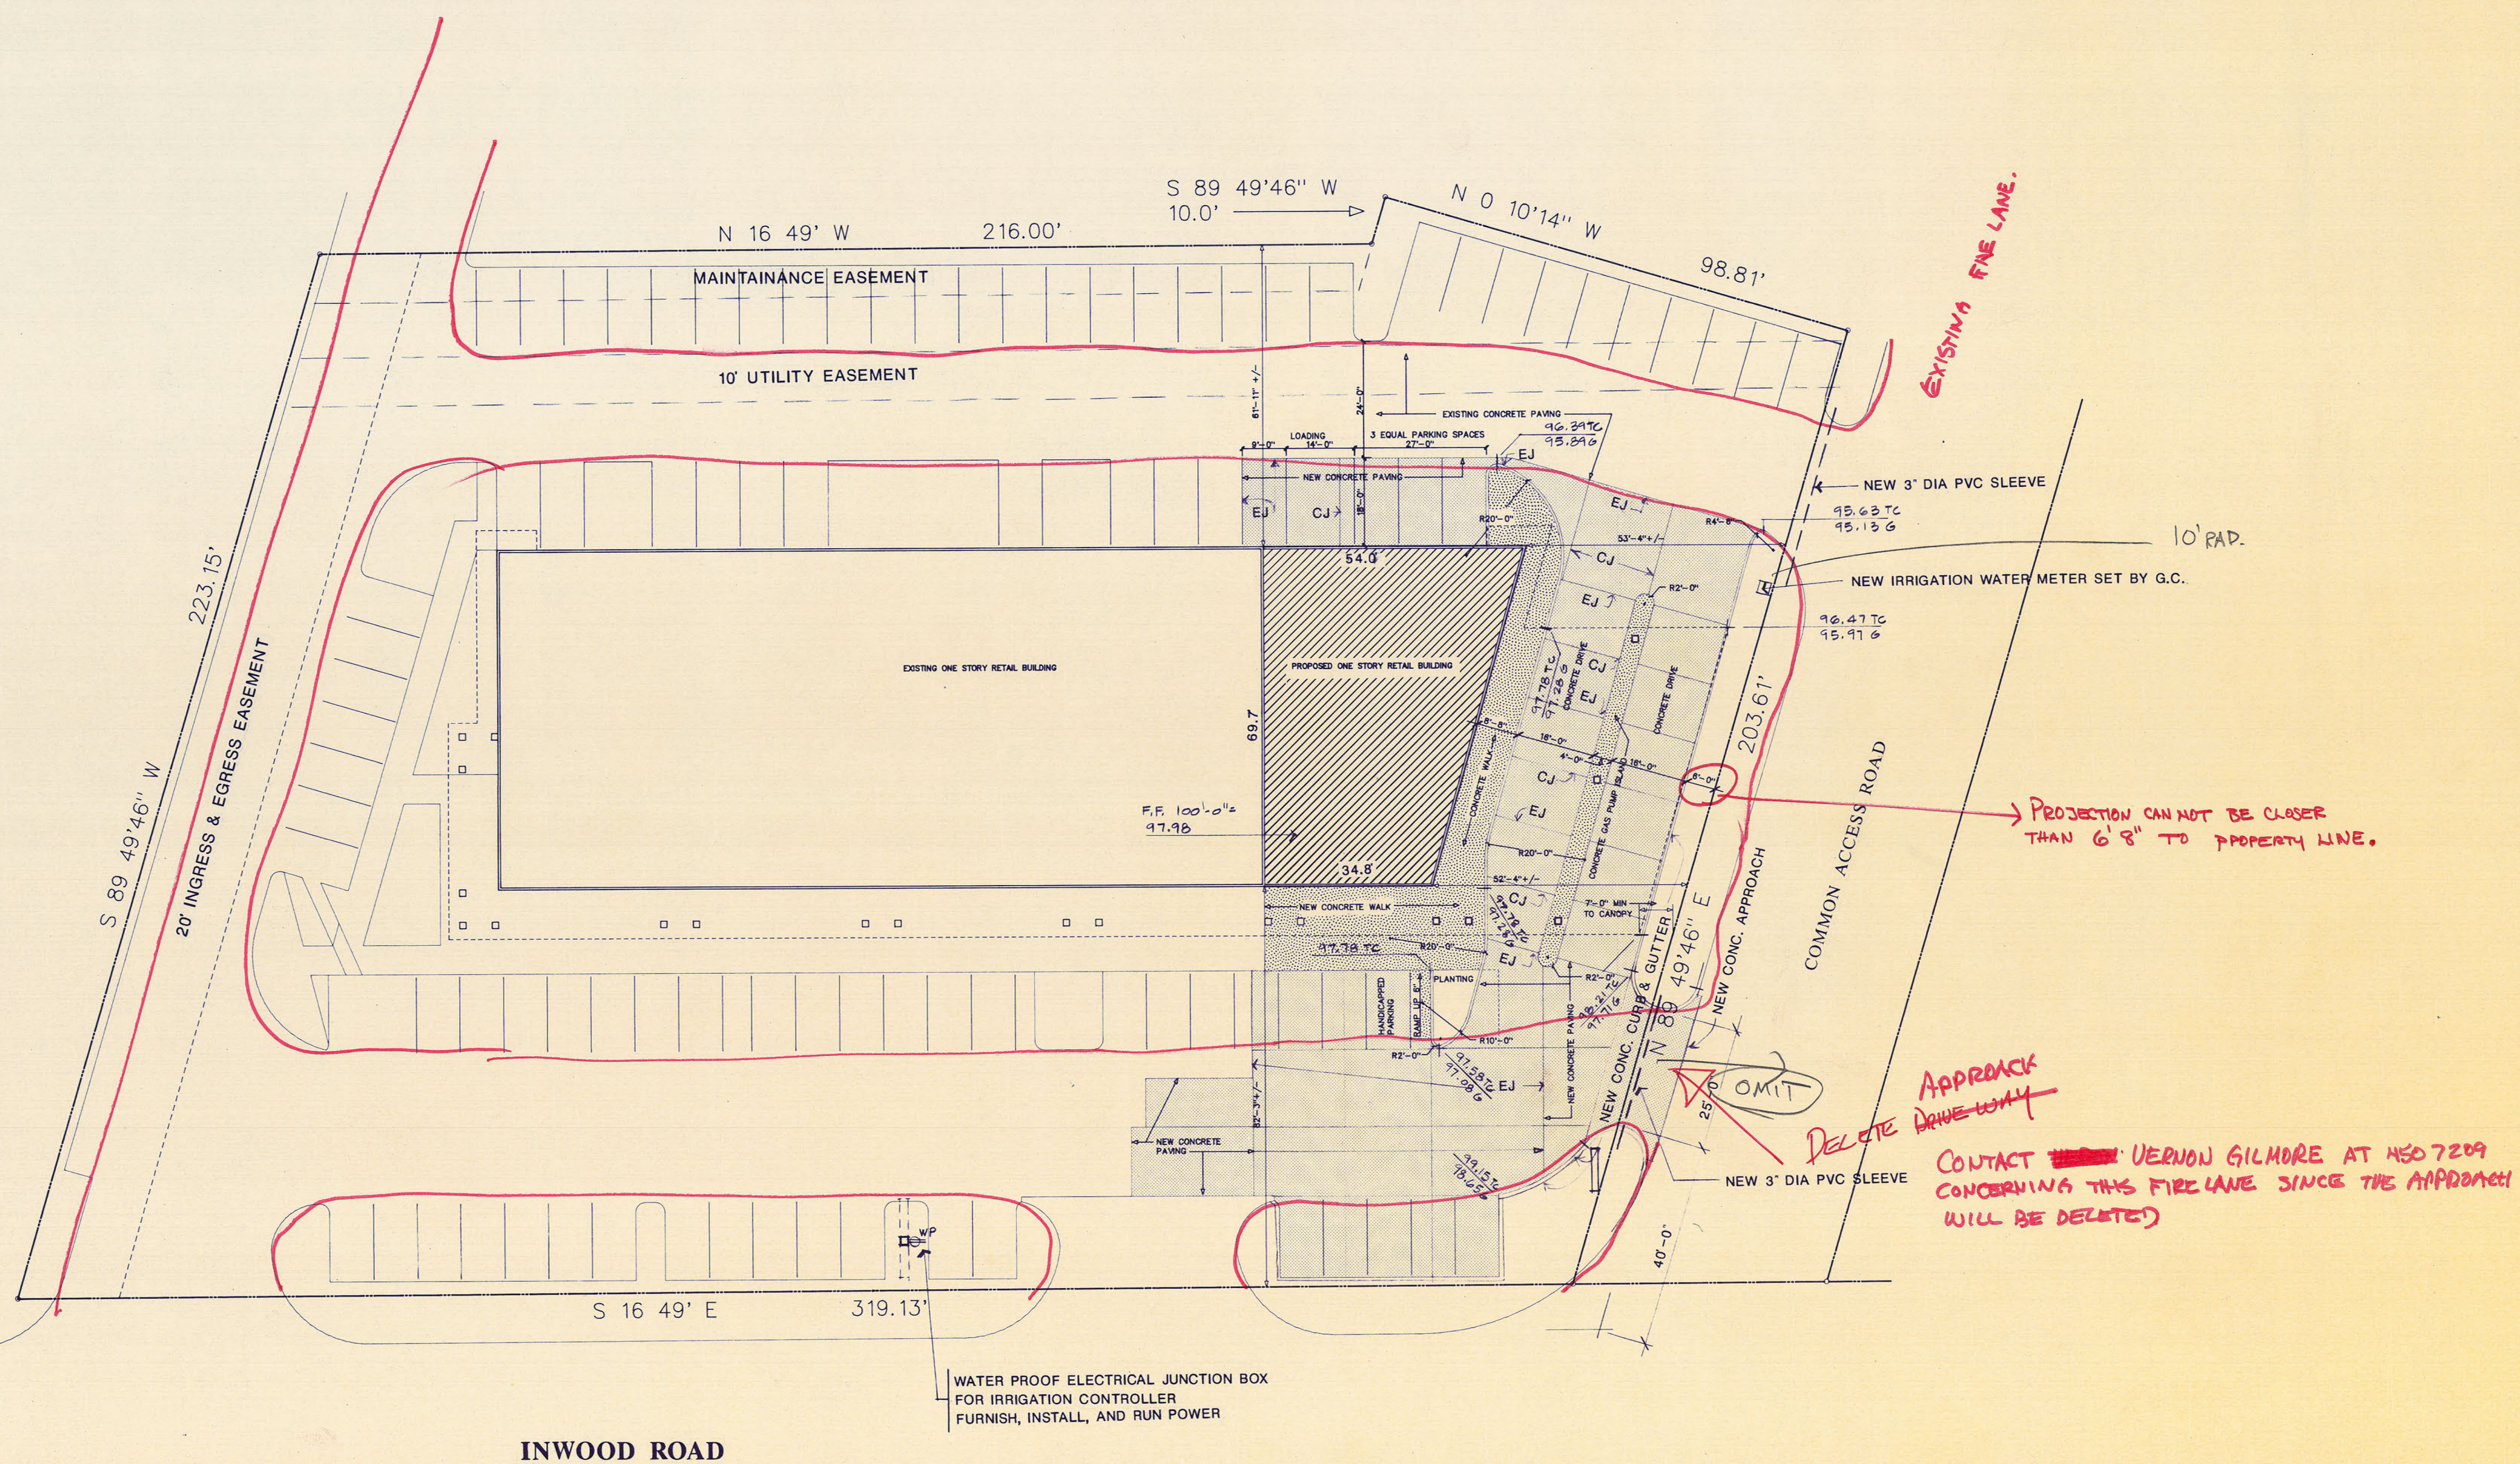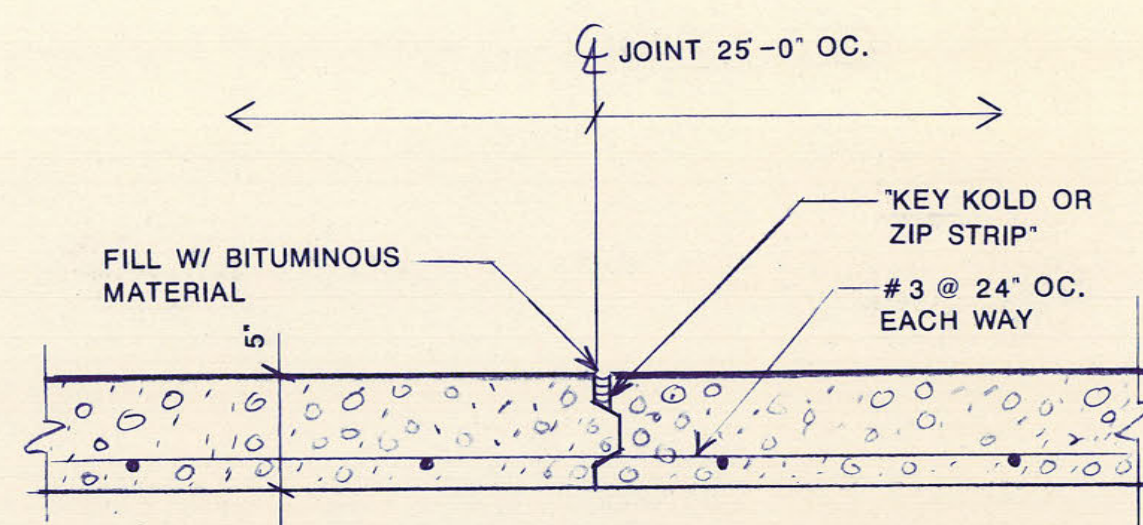

01 Site Plan
SCALE: 1"=20.0'

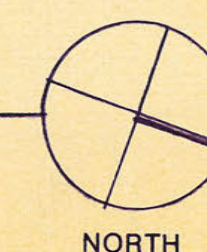

REVISIONS	DATE

RENOVATION AND ADDITION TO
QUORUM VINEYARD RETAIL CENTER
ADDISON, TEXAS

**SULLIVAN
KEY
MERRILL**

Architects and Planners, Inc.
1510 Main Street, 10th Floor
Dallas, Texas 75201
214-761-0505

CHECKED	
DRAWN	
DATE	4/1/91
PRINT DATE	4-19

PROJECT NO.	8922
SHEET TITLE	SITE PLAN
SHEET NO.	A 03