


DATE	
BY	
SURVEY	
NOTED	
NOTE BOOK	
ALIGNMENT CHECKED	
RT. OF WAY CHECKED	
No.	

DATE	
BY	
SURVEY	
NOTED	
NOTE BOOK	
ALIGNMENT CHECKED	
STRUCTURE NOTATIONS CHECKED	
No.	

See Sheet
3 of 5

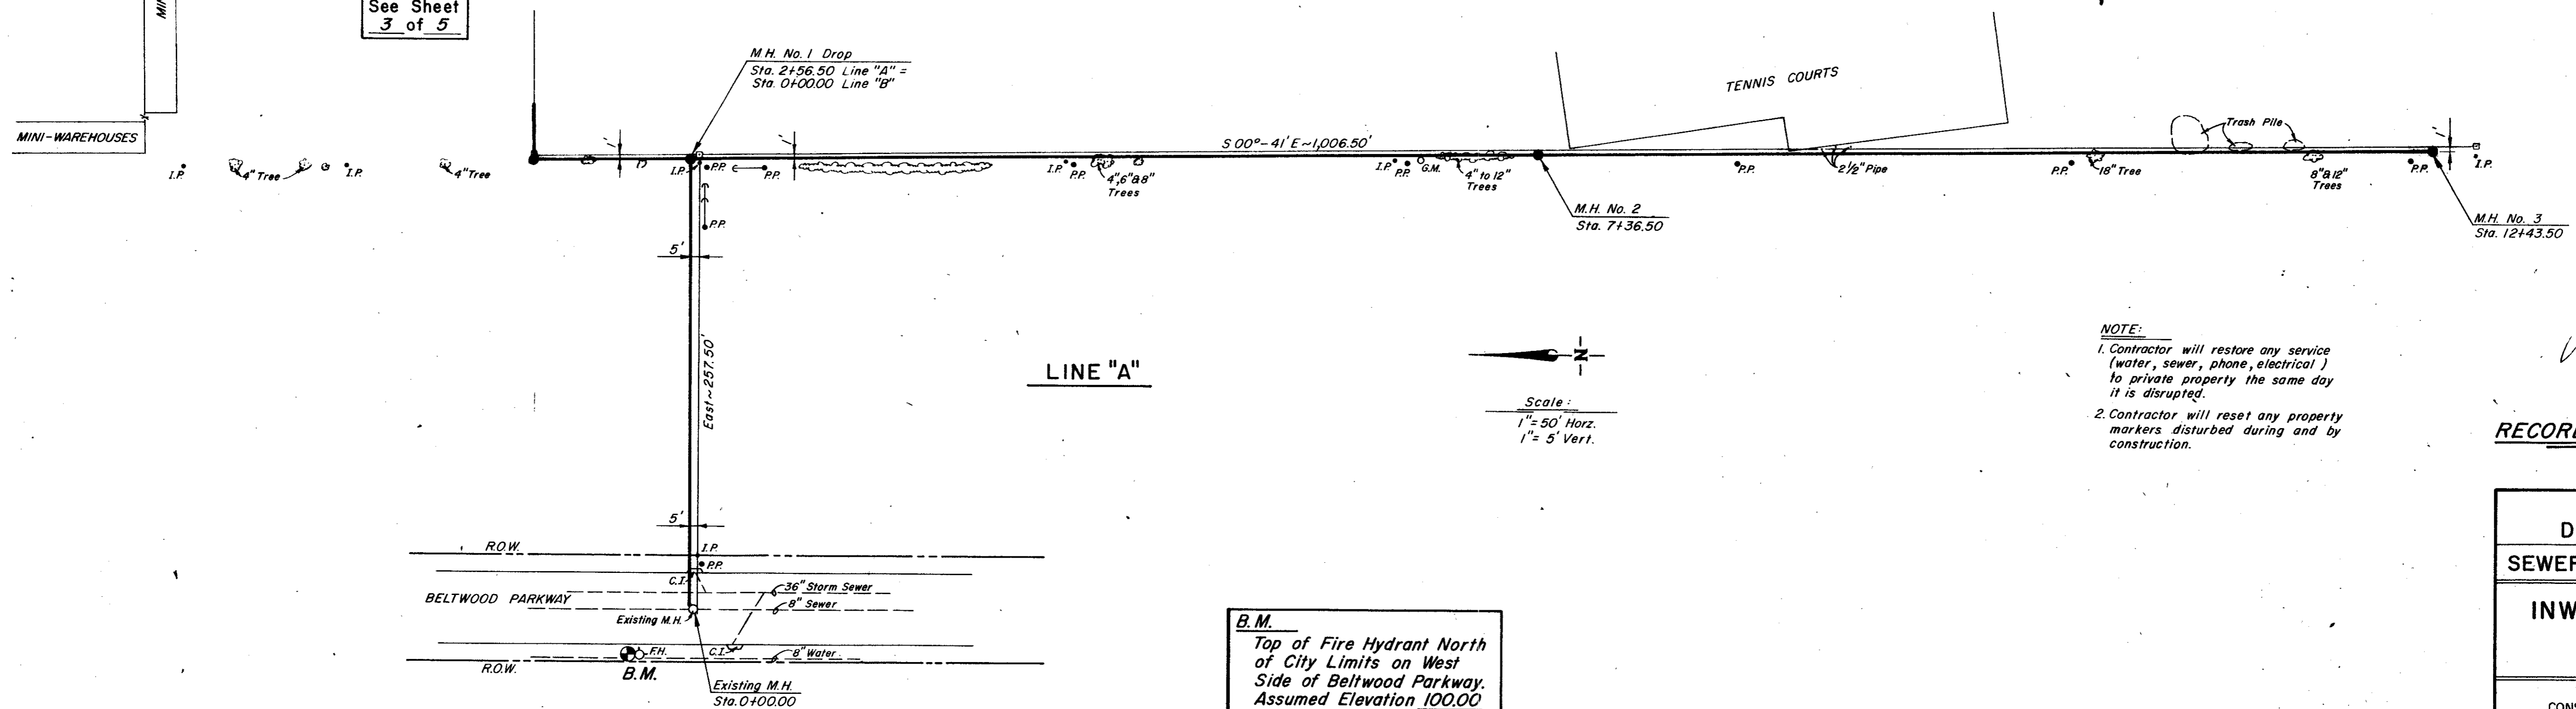

LINE "A"

Scale:
1" = 50' Horz.
1" = 5' Vert.

B.M.
Top of Fire Hydrant North
of City Limits on West
Side of Beltwood Parkway.
Assumed Elevation 100.00

NOTE:
1. Contractor will restore any service (water, sewer, phone, electrical) to private property the same day it is disrupted.
2. Contractor will reset any property markers disturbed during and by construction.



RECORD DRAWINGS

CITY OF ADDISON
DALLAS COUNTY, TEXAS
SEWER AND WATER IMPROVEMENTS
INWOOD ROAD SEWER LINE
LINE "A"

GINN & STACY, INC.
CONSULTING ENGINEERS - DALLAS, TEXAS
Designed By: J.O.S. Scale: As Shown
Drawn By: J.D.M. Date: 1976 Sheet 2 of 5

