



DATE _____
 BY _____
 SURVEYOR _____
 CHECKED _____
 NO. _____

DATE _____
 BY _____
 SURVEYOR _____
 CHECKED _____
 NO. _____

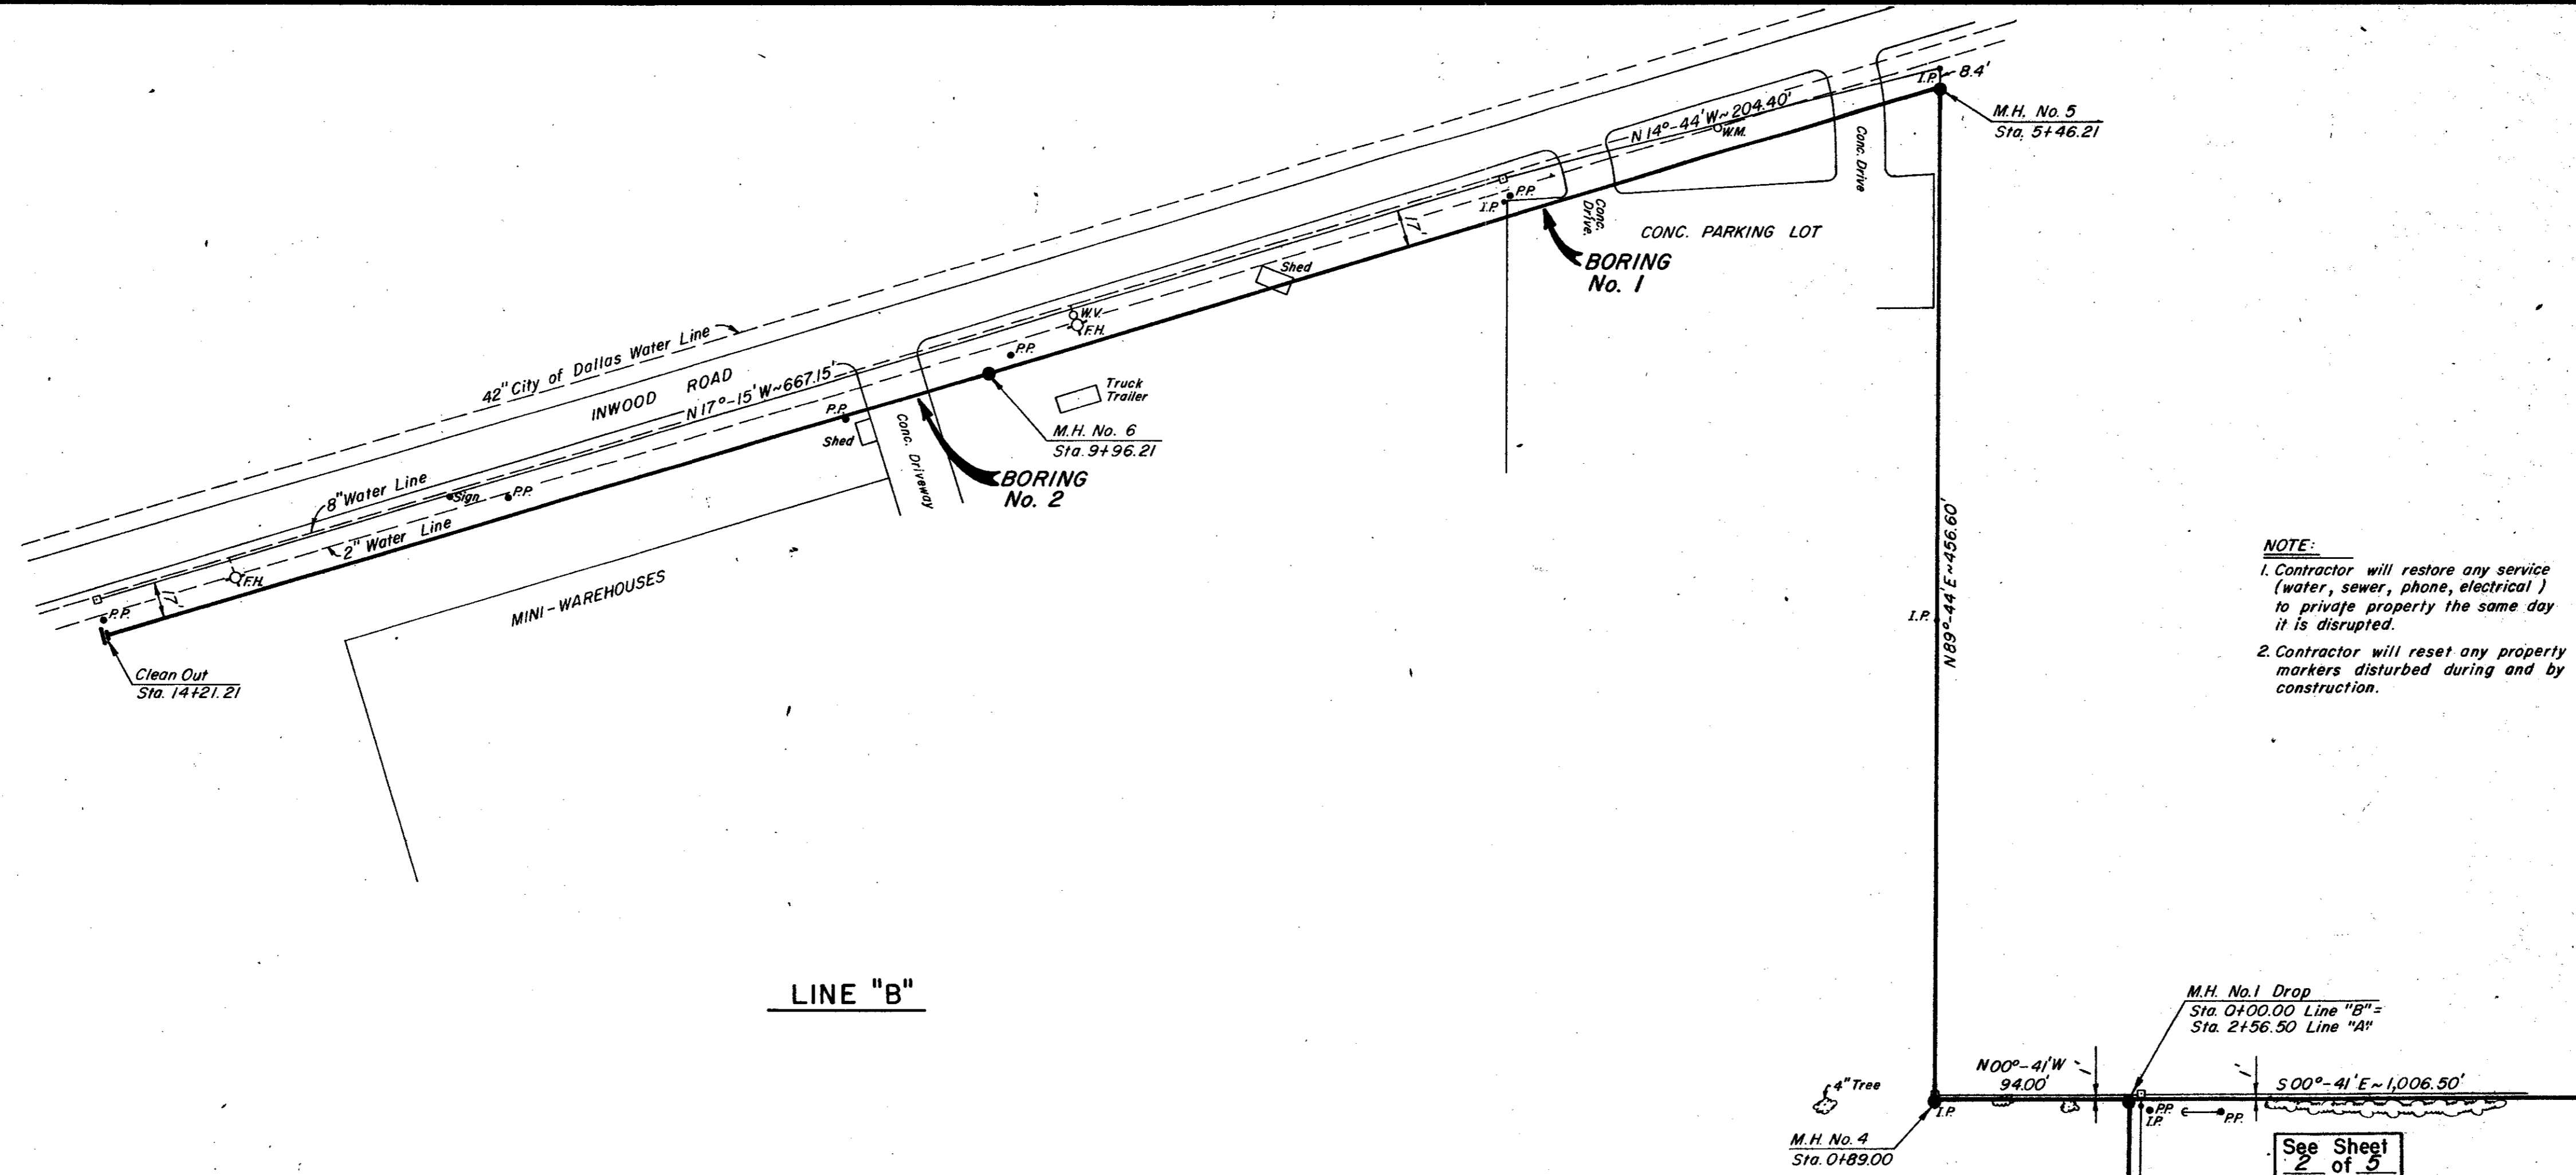

Scale:
 1" = 50' Horiz.
 1" = 5' Vert.

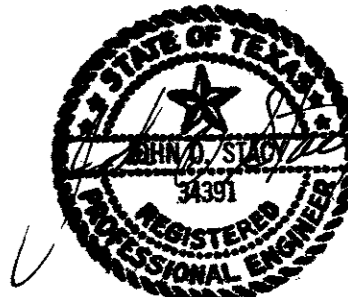

NOTE:
 1. Contractor will restore any service (water, sewer, phone, electrical) to private property the same day it is disrupted.
 2. Contractor will reset any property markers disturbed during and by construction.

RECORD DRAWINGS

CITY OF ADDISON DALLAS COUNTY, TEXAS	
SEWER AND WATER IMPROVEMENTS	
INWOOD ROAD SEWER LINE LINE "B"	
GINN & STACY, INC. CONSULTING ENGINEERS DALLAS, TEXAS	
Designed By: J.O.S.	Scale: As Shown
Drawn By: J.D.M.	Date: 1976
Sheet 3 of 5	

