



DATE: \_\_\_\_\_ BY: \_\_\_\_\_  
 PLAN  
 CHECKED: \_\_\_\_\_  
 NOTE BOOK: \_\_\_\_\_  
 NO. \_\_\_\_\_

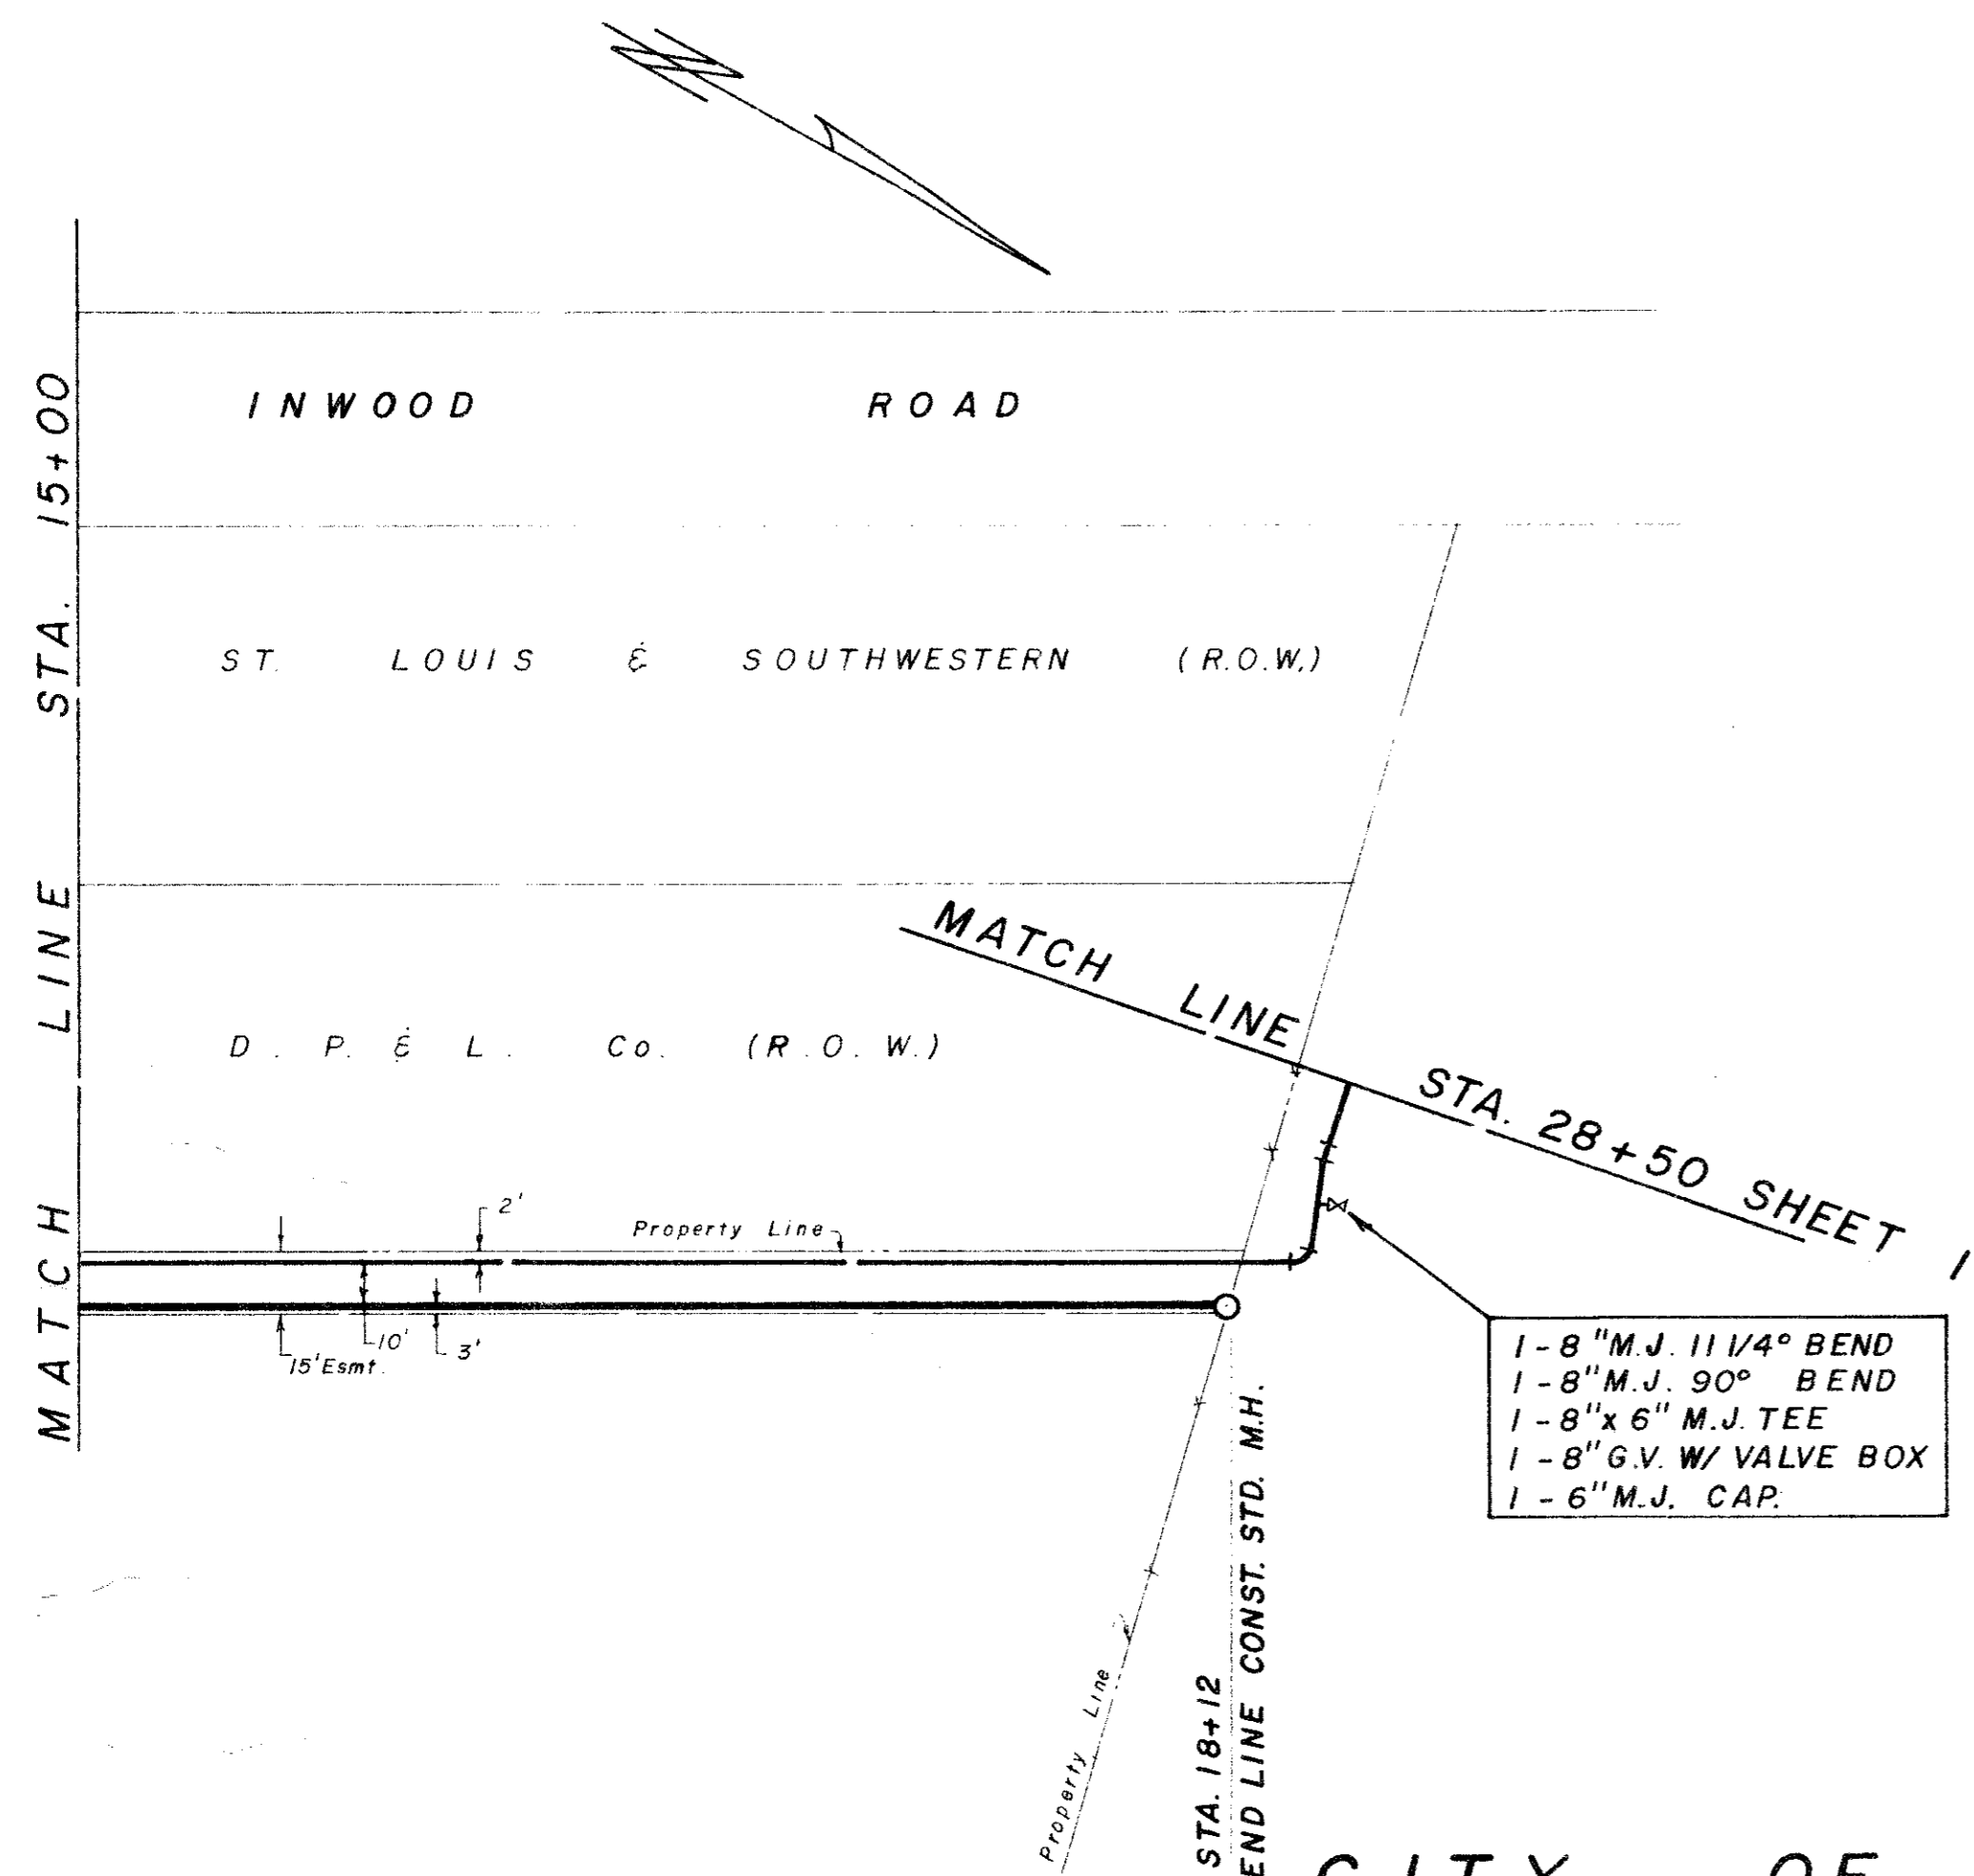

CITY OF ADDISON, TEXAS — SANITARY SEWER IMPROVEMENTS

CHANGE ORDER # 1

DATE: \_\_\_\_\_ BY: \_\_\_\_\_  
 PROFILE  
 CHECKED: \_\_\_\_\_  
 NOTE BOOK: \_\_\_\_\_  
 NO. \_\_\_\_\_

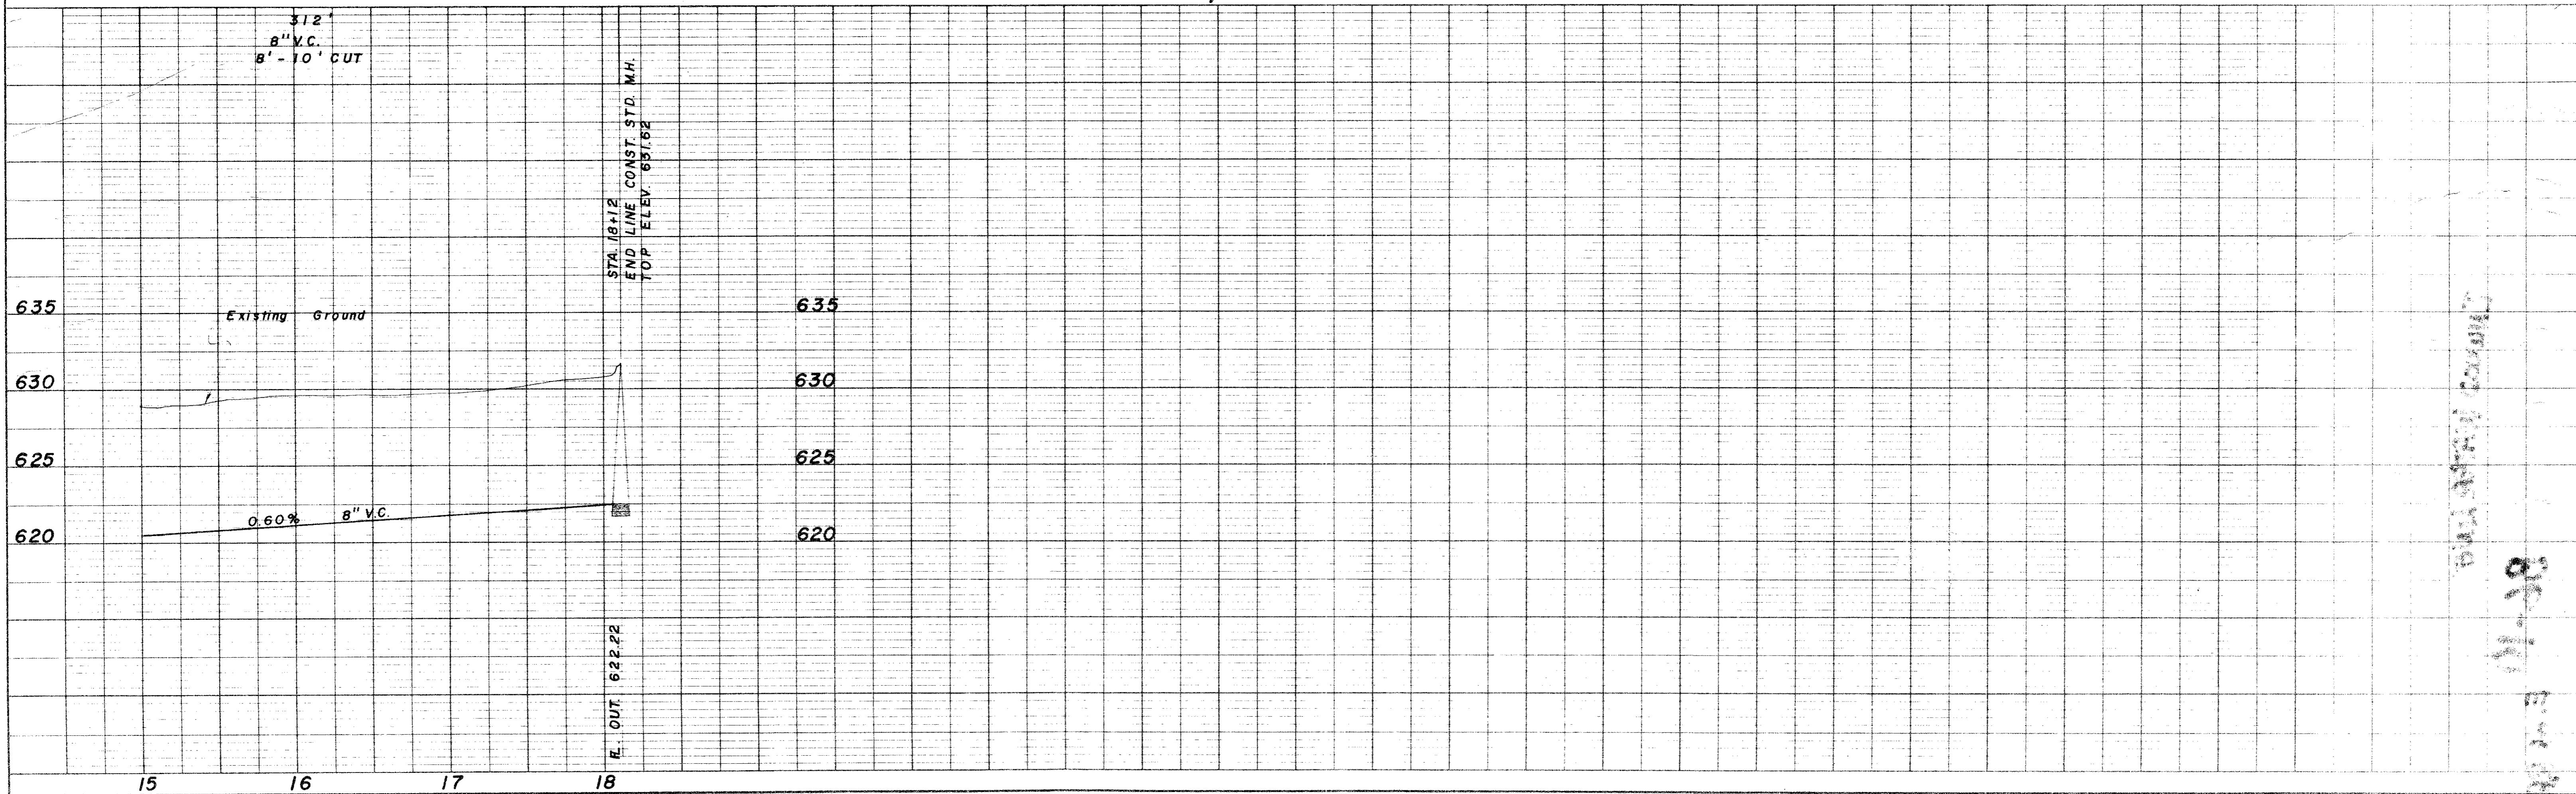

11-19  
 84-11-19  
 11-19