


**PLAN**  
 SURVEYED BY: \_\_\_\_\_ DATE: \_\_\_\_\_  
 PLOTTED BY: \_\_\_\_\_  
 NOTE BOOK NO. \_\_\_\_\_  
 ALIGNMENT CHECKED BY: \_\_\_\_\_  
 REVISIONS CHECKED BY: \_\_\_\_\_

**PROFILE**  
 SURVEYED BY: \_\_\_\_\_ DATE: \_\_\_\_\_  
 PLOTTED BY: \_\_\_\_\_  
 NOTE BOOK NO. \_\_\_\_\_  
 STRUCTURE INDICATIONS CHECKED BY: \_\_\_\_\_

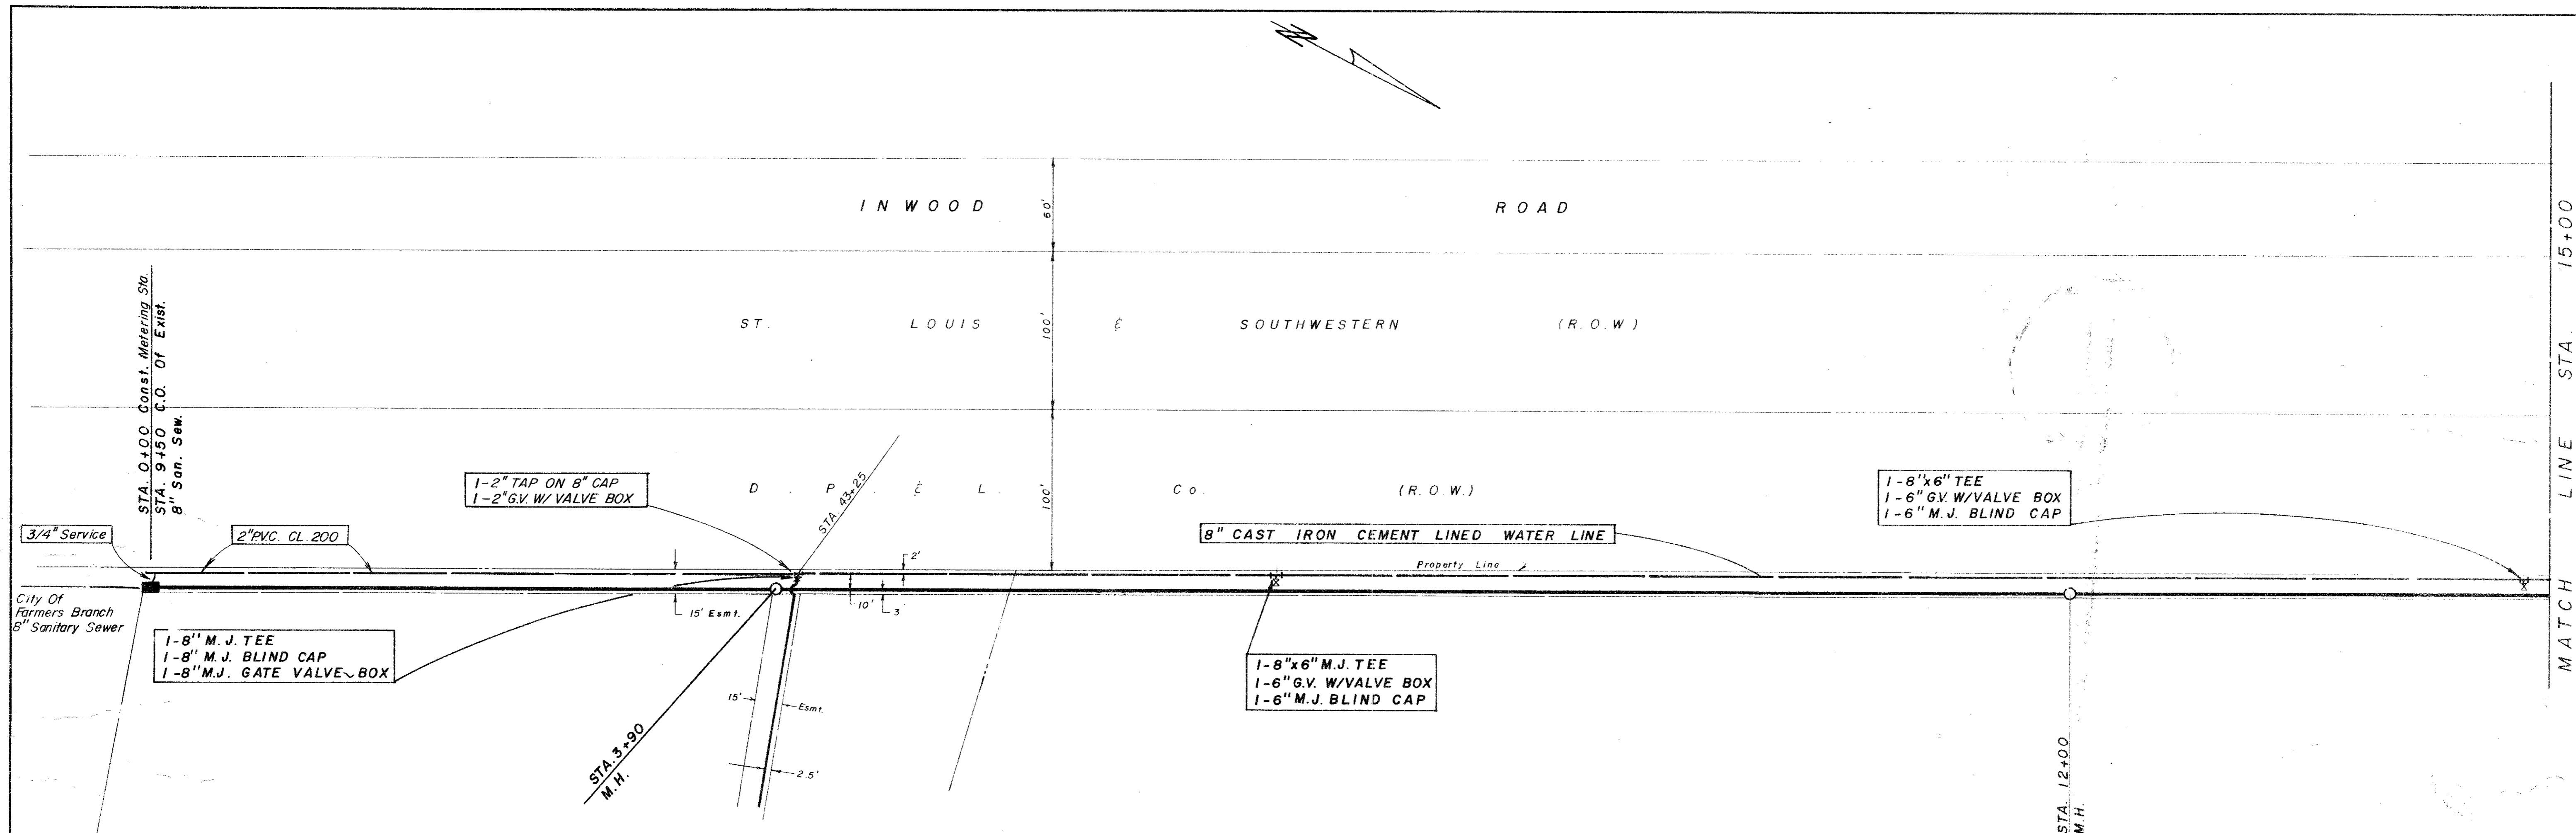

CITY OF ADDISON, TEXAS - SANITARY SEWER IMPROVEMENTS

CHANGE ORDER #1

