


AS BUILT

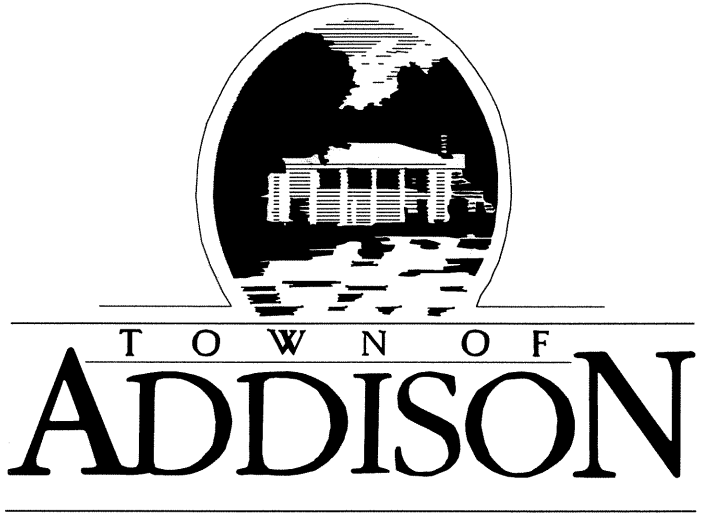

ROADWAY, DRAINAGE AND TRAFFIC SIGNAL DESIGN PLANS  
 INWOOD / SOUTH QUORUM ACCESS - PHASE I  
 LANDMARK EXTENSION


BID No. 00-18

MAYOR  
R. Scott Wheeler

CITY COUNCIL  
 Bob Barrett  
 Frank Klein  
 Diane Mallory  
 Fred Silver  
 Glynda Turner  
 Cathy Ways

CITY MANAGER:  
Ron Whitehead

ACTING DIRECTOR OF PUBLIC WORKS  
Michael E. Murphy, P.E.

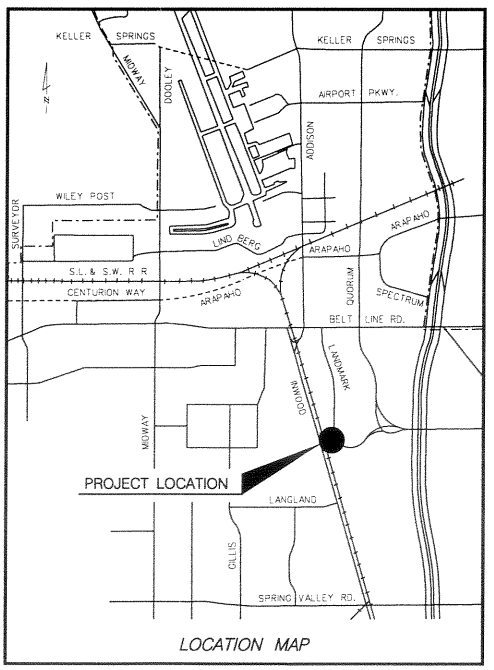

INDEX OF DRAWINGS

| SHEET No. | TITLE   |
|-----------|---|
| 1         | COVER SHEET                                     |
| 2-3       | ROADWAY AND DRAINAGE                            |
| 4         | TYPICAL SECTIONS                                |
| 4         | GENERAL NOTES AND QUANTITY SUMMARY              |
| 5-6       | TRAFFIC CONTROL PLANS                           |
| 7         | RIGHT OF WAY MAP                                |
| 8         | CONTROL DATA                                    |
| 9-14      | PLAN AND PROFILE SHEETS                         |
| 15        | DRAINAGE AREA MAP                               |
| 16-17     | DRAINAGE PROFILES                               |
| 18-19     | PAVEMENT MARKINGS                               |
| 20-21     | MISCELLANEOUS DETAIL SHEET                      |
| 22-23     | JOINT DETAILS                                   |
| 24        | SIDEWALK RAMPS (SRD-FW-99)                      |
| 25        | MANHOLE TYPE M (MH-M)                           |
| 26        | STORM SEWER JUNCTION BOX                        |
| 27        | METAL BEAM GUARD FENCE (MBGF-94)                |
| 28        | SINGLE GUARDRAIL TERMINAL (SGT(5)-97)           |
| 29        | CHAIN LINK BARRIER FENCE (CLF-96)               |
| 30        | PAVEMENT MARKINGS (PM-WA(FTW))                  |
| 31        | TEMPORARY EROSION CONTROL (EC-(1)-93)           |
| 32-38     | CROSS SECTIONS                                  |
| 39        | TRAFFIC SIGNALS                                 |
| 39        | SIGNAL LAYOUT PLANS                             |
| 40        | SIGNAL LAYOUT TABLES                            |
| 41        | TRAFFIC SIGNAL HEAD DETAILS                     |
| 42        | TRAFFIC SIGNAL POLE FOUNDATIONS                 |
| 43        | CONTROLLER FOUNDATION / GROUND BOX INSTALLATION |
| 44        | TRAFFIC CONTROL PLAN DETAILS                    |
| 45        | TRAFFIC CONTROL PLAN DETAILS                    |
| 46        | TRANSFORMER BASE DETAILS                        |
| 47        | SERVICE POLE AND GROUNDING DETAILS              |

7-20-01

**PARSONS TRANSPORTATION GROUP, INC.**  
 5485 BELT LINE ROAD, SUITE 199 • DALLAS, TEXAS 75240  
 (972) 991-1900 • FAX: (972) 490-9261

FF-9