


- LEGEND :
- EXPANSION JOINT
 - LONGITUDINAL JOINT
 - - - SAWED JOINT

- NOTE :
1. 36' PAVEMENT ON LANDMARK BLVD. SHALL HAVE ONE LONGITUDINAL JOINT, ON THE CENTER LINE.
 2. SEE JOINT DETAILS SHEET 2 OF 2 FOR JOINT DETAILS.

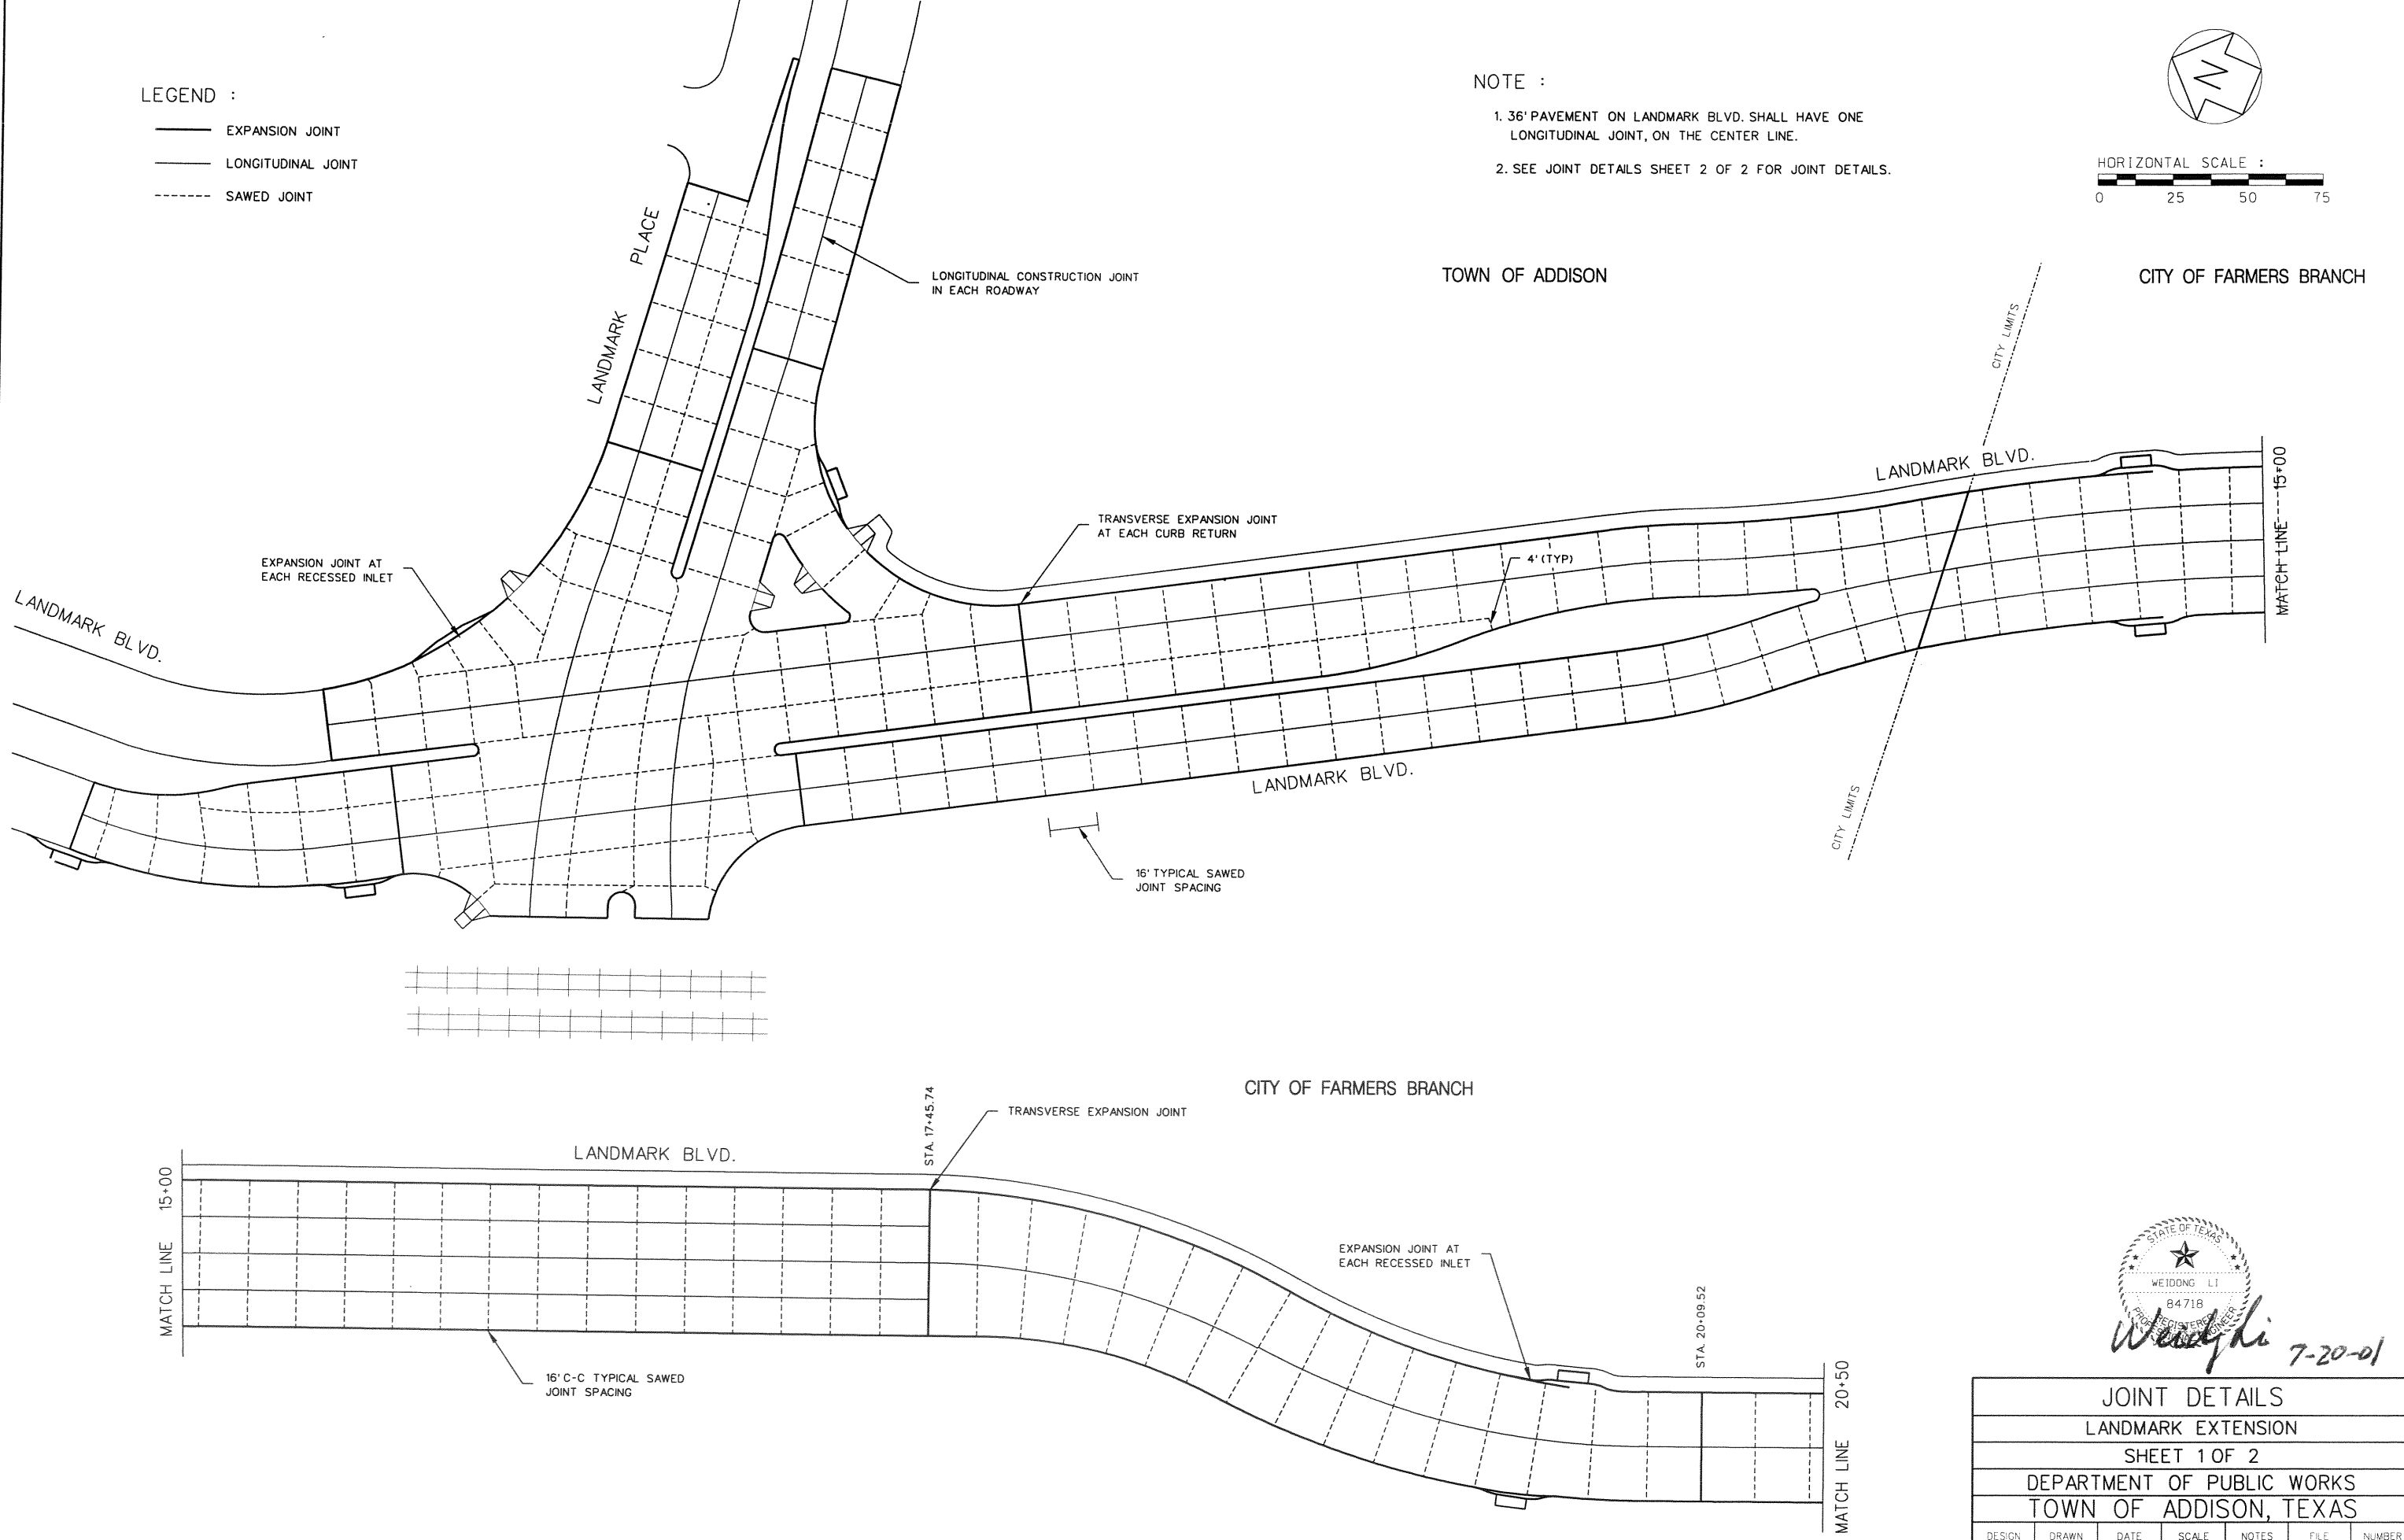

Weidong Li 7-20-01

| | | | | | | |
|----------------------------|--------|------|-------|-----------------|------|-----------|
| JOINT DETAILS | | | | | | |
| LANDMARK EXTENSION | | | | | | |
| SHEET 1 OF 2 | | | | | | |
| DEPARTMENT OF PUBLIC WORKS | | | | | | |
| TOWN OF ADDISON, TEXAS | | | | | | |
| DESIGN | DRAWN | DATE | SCALE | NOTES | FILE | NUMBER |
| P.G.W. | C.W.W. | 2/00 | | AS BUILT | | 22 |