



NOTE:


1. POLYETHYLENE FOAM BACKER ROD SHALL NOT RESET ON BOTTOM OF SAWCUT JOINT
2. SILICONE HAS GENERAL WIDTH TO DEPTH RATIO OF 2:1

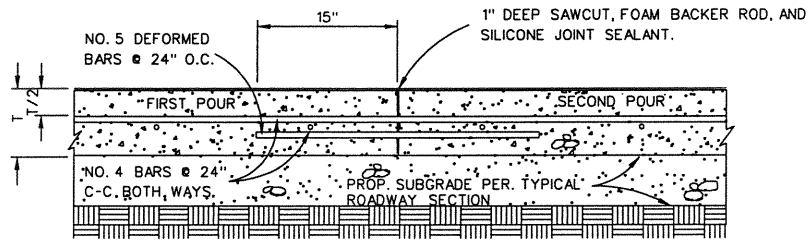


TRANSVERSE CONSTRUCTION JOINT
NOT TO SCALE

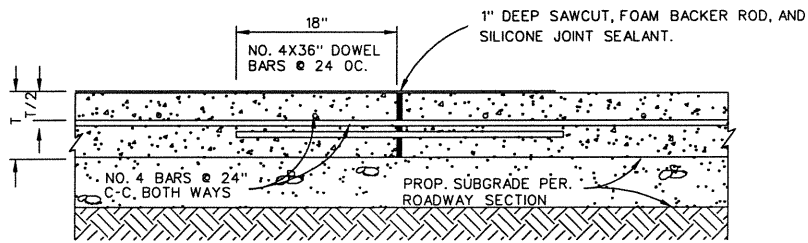



LONGITUDINAL CONSTRUCTION JOINT
NOT TO SCALE

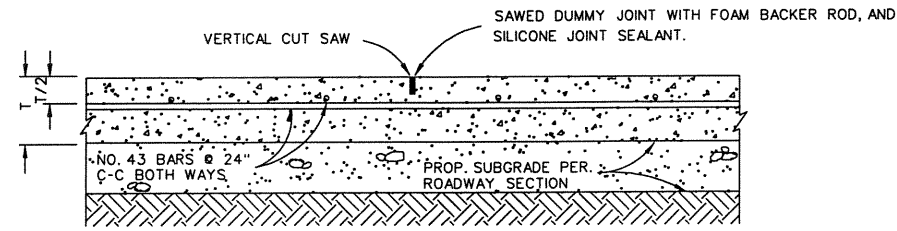

SAWED DUMMY JOINT
NOT TO SCALE


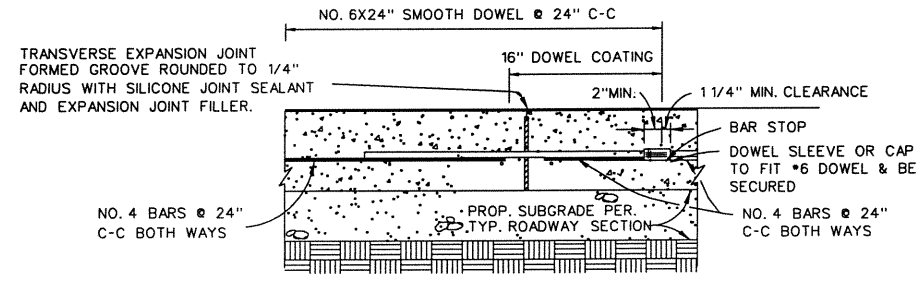


TRANSVERSE EXPANSION JOINT
NOT TO SCALE

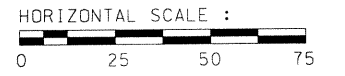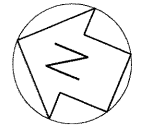

- LEGEND :**
- EXPANSION JOINT
 - LONGITUDINAL JOINT
 - - - - SAWED JOINT

- NOTE :**
1. 36' PAVEMENT ON LANDMARK BLVD. SHALL HAVE ONE LONGITUDINAL JOINT, ON THE CENTER LINE.

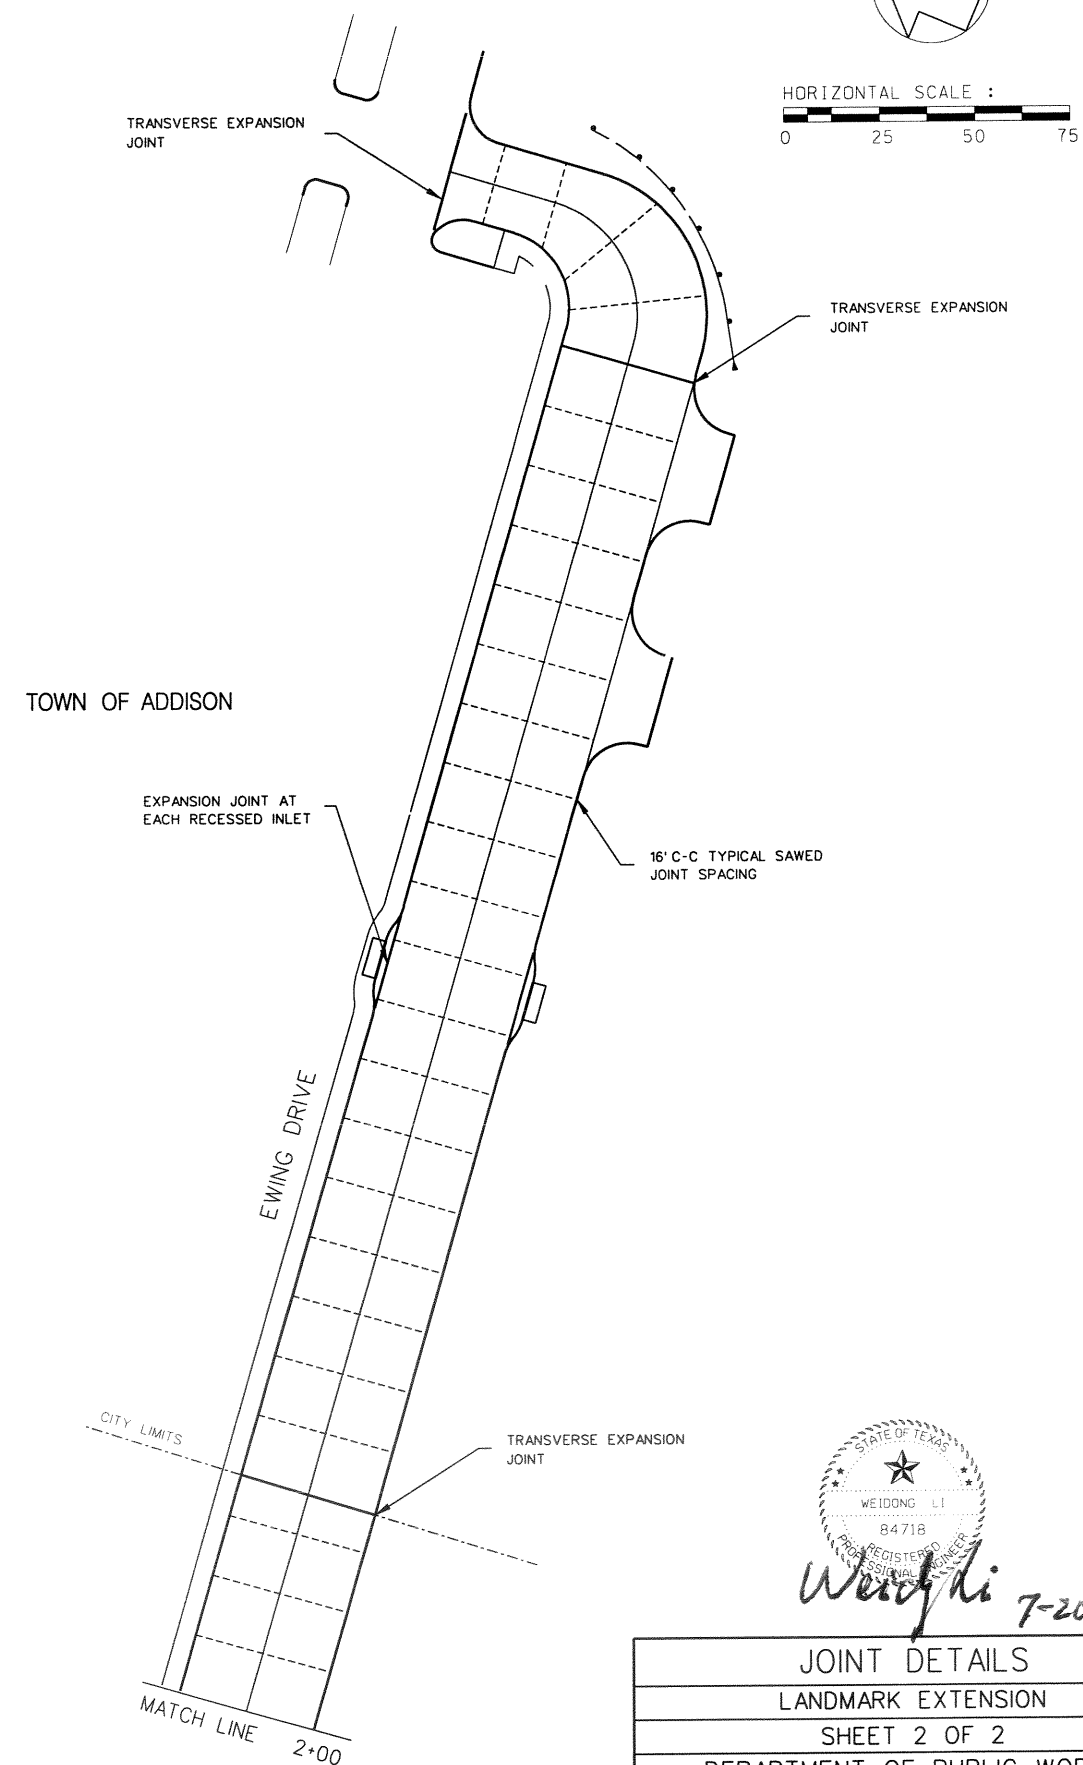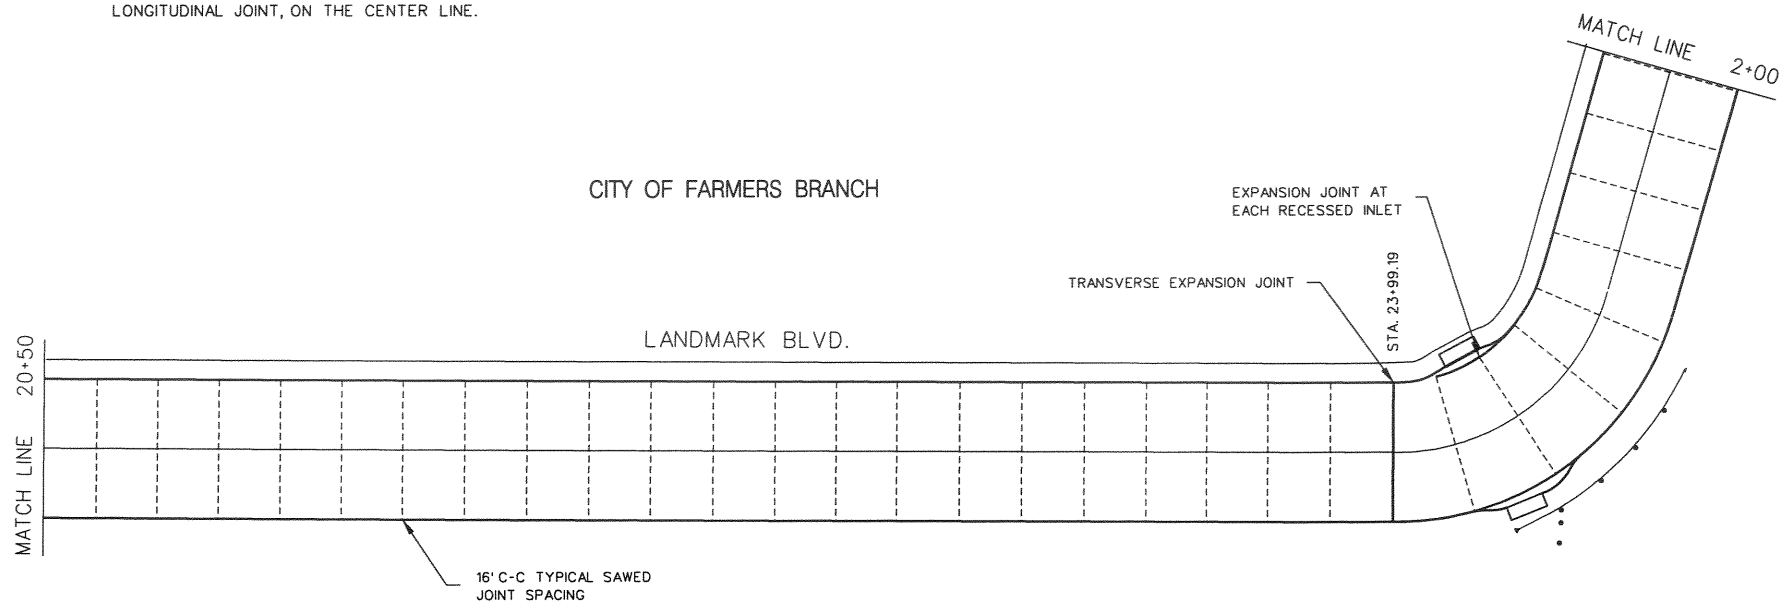

Weidong Li 7-20-01

JOINT DETAILS						
LANDMARK EXTENSION						
SHEET 2 OF 2						
DEPARTMENT OF PUBLIC WORKS						
TOWN OF ADDISON, TEXAS						
DESIGN	DRAWN	DATE	SCALE	NOTES	FILE	NUMBER
P.G.W.	C.W.W.	2/00		AS BUILT		23