




LANDMARK BOULEVARD - STA. 19+89.13 TO STA. 24+43.64
(CITY OF FARMERS BRANCH)

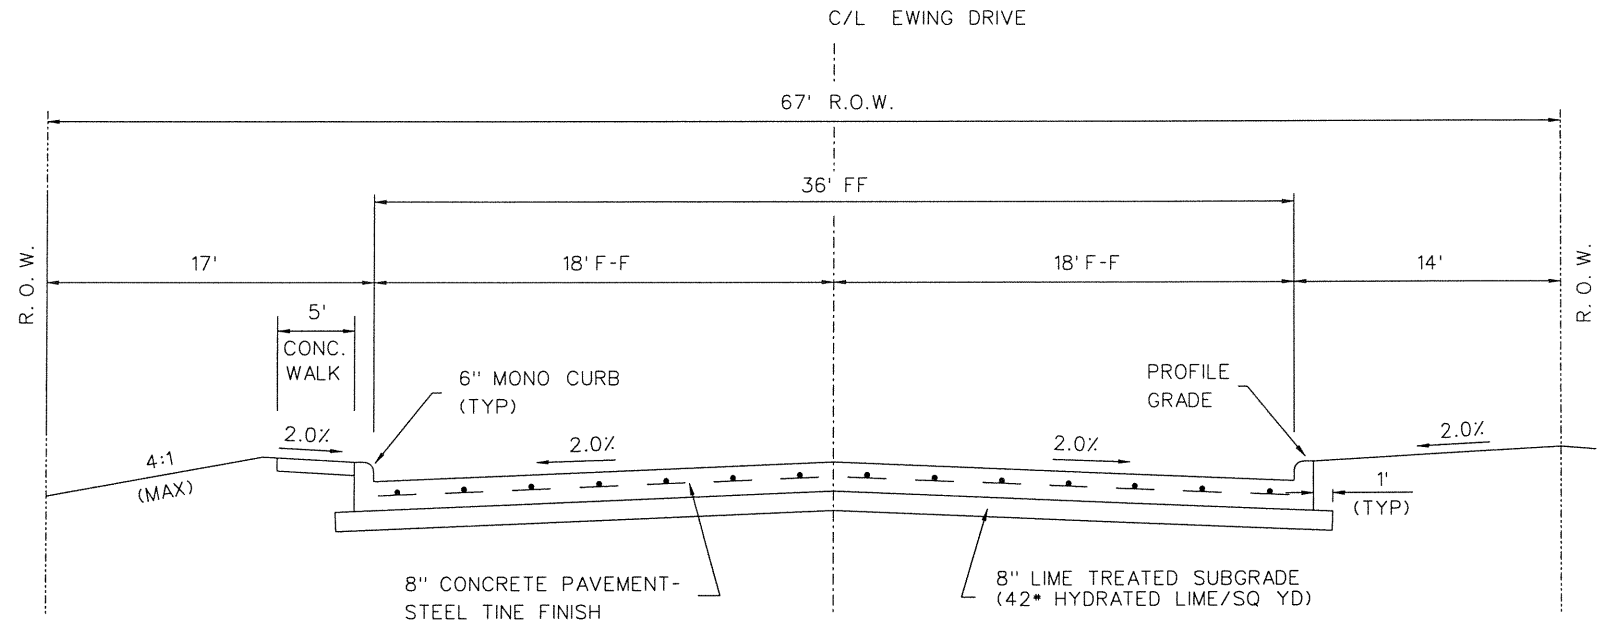

EWING DRIVE - STA. 2+58.00 TO STA. 6+39.26

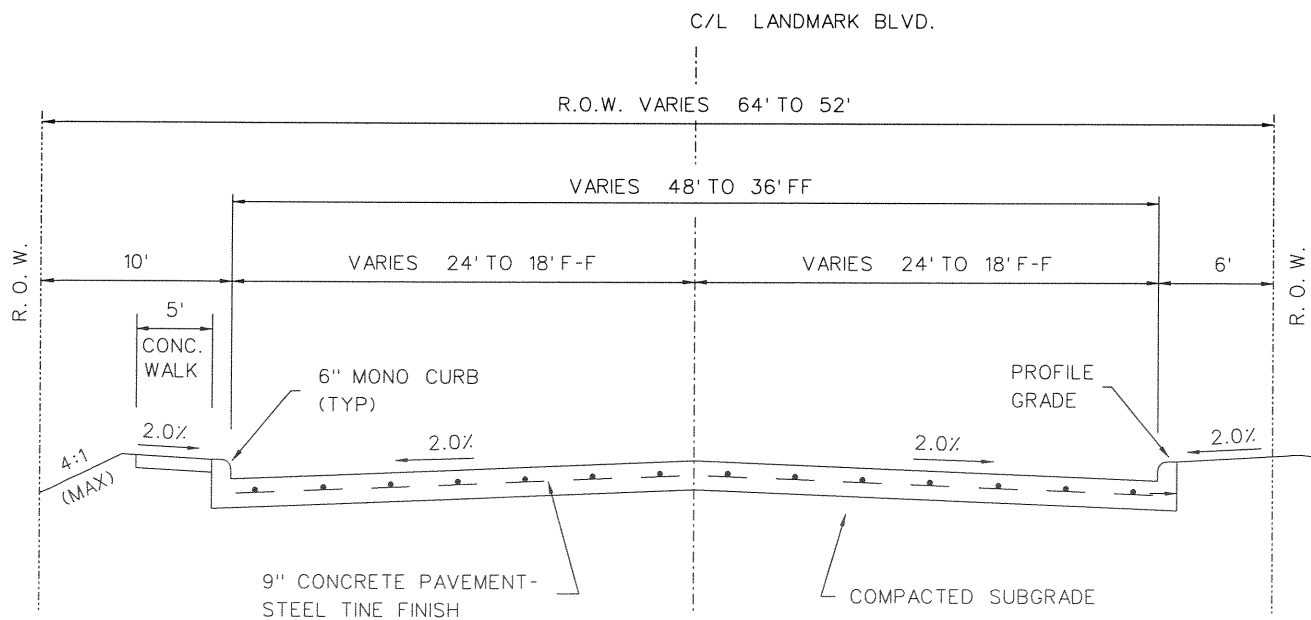

LANDMARK BOULEVARD - STA. 17+50.00 TO STA. 19+89.13
(CITY OF FARMERS BRANCH)

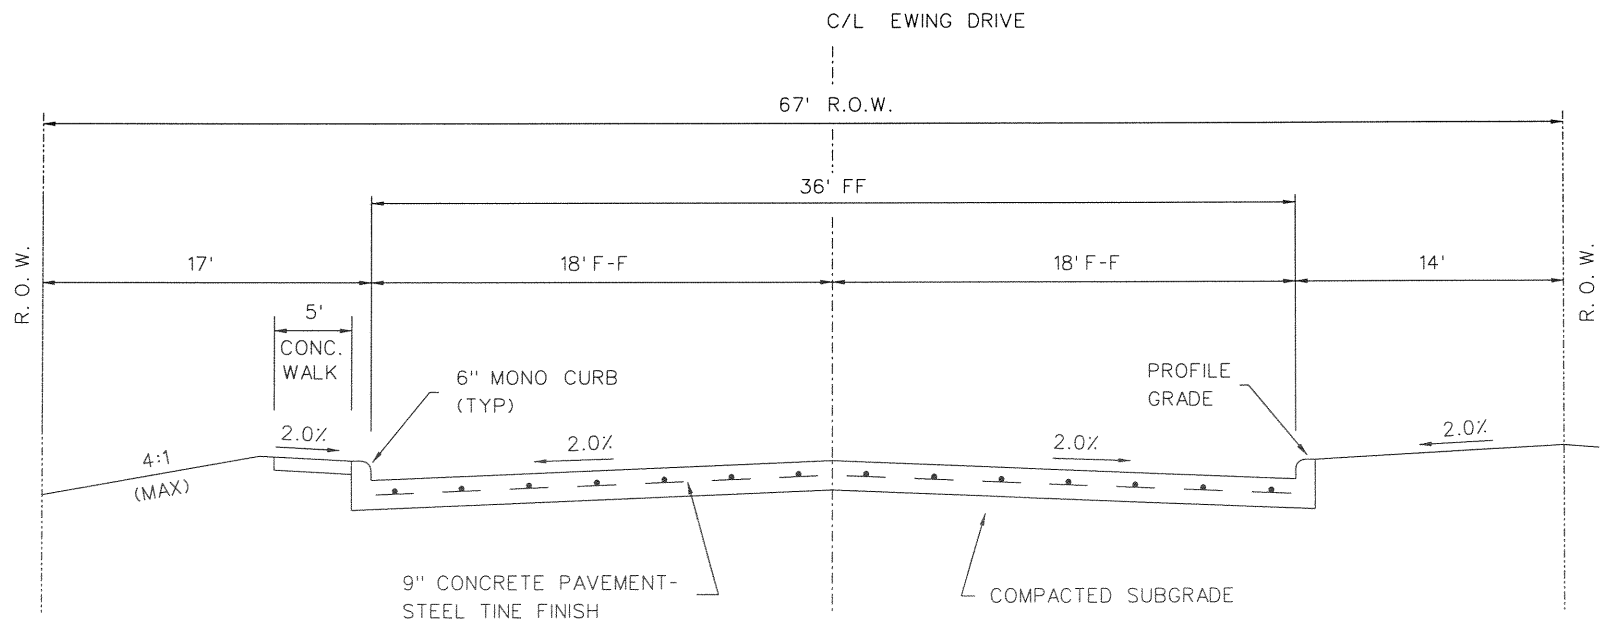

EWING DRIVE - STA. 1+00.00 TO STA. 2+58.00
(CITY OF FARMERS BRANCH)

NOTE :

1. FOR MONO CURB, SEE DETAIL "A", SHEET 1 OF 2.
2. ALL CONCRETE PAVEMENT SHALL HAVE A MINIMUM 28-DAY FLEXURAL STRENGTH OF 650 P.S.I., PER ASTM C-78.



Weidong Li
7-20-00

1	MISC. REVISIONS	5/19/00
TYPICAL SECTIONS		
LANDMARK EXTENSION		
SHEET 2 OF 2		
DEPARTMENT OF PUBLIC WORKS		
TOWN OF ADDISON, TEXAS		
DESIGN	DRAWN	DATE
P.G.W.	C.W.W.	2/00
SCALE	NOTES	FILE
N. T. S.	AS BUILT	3