
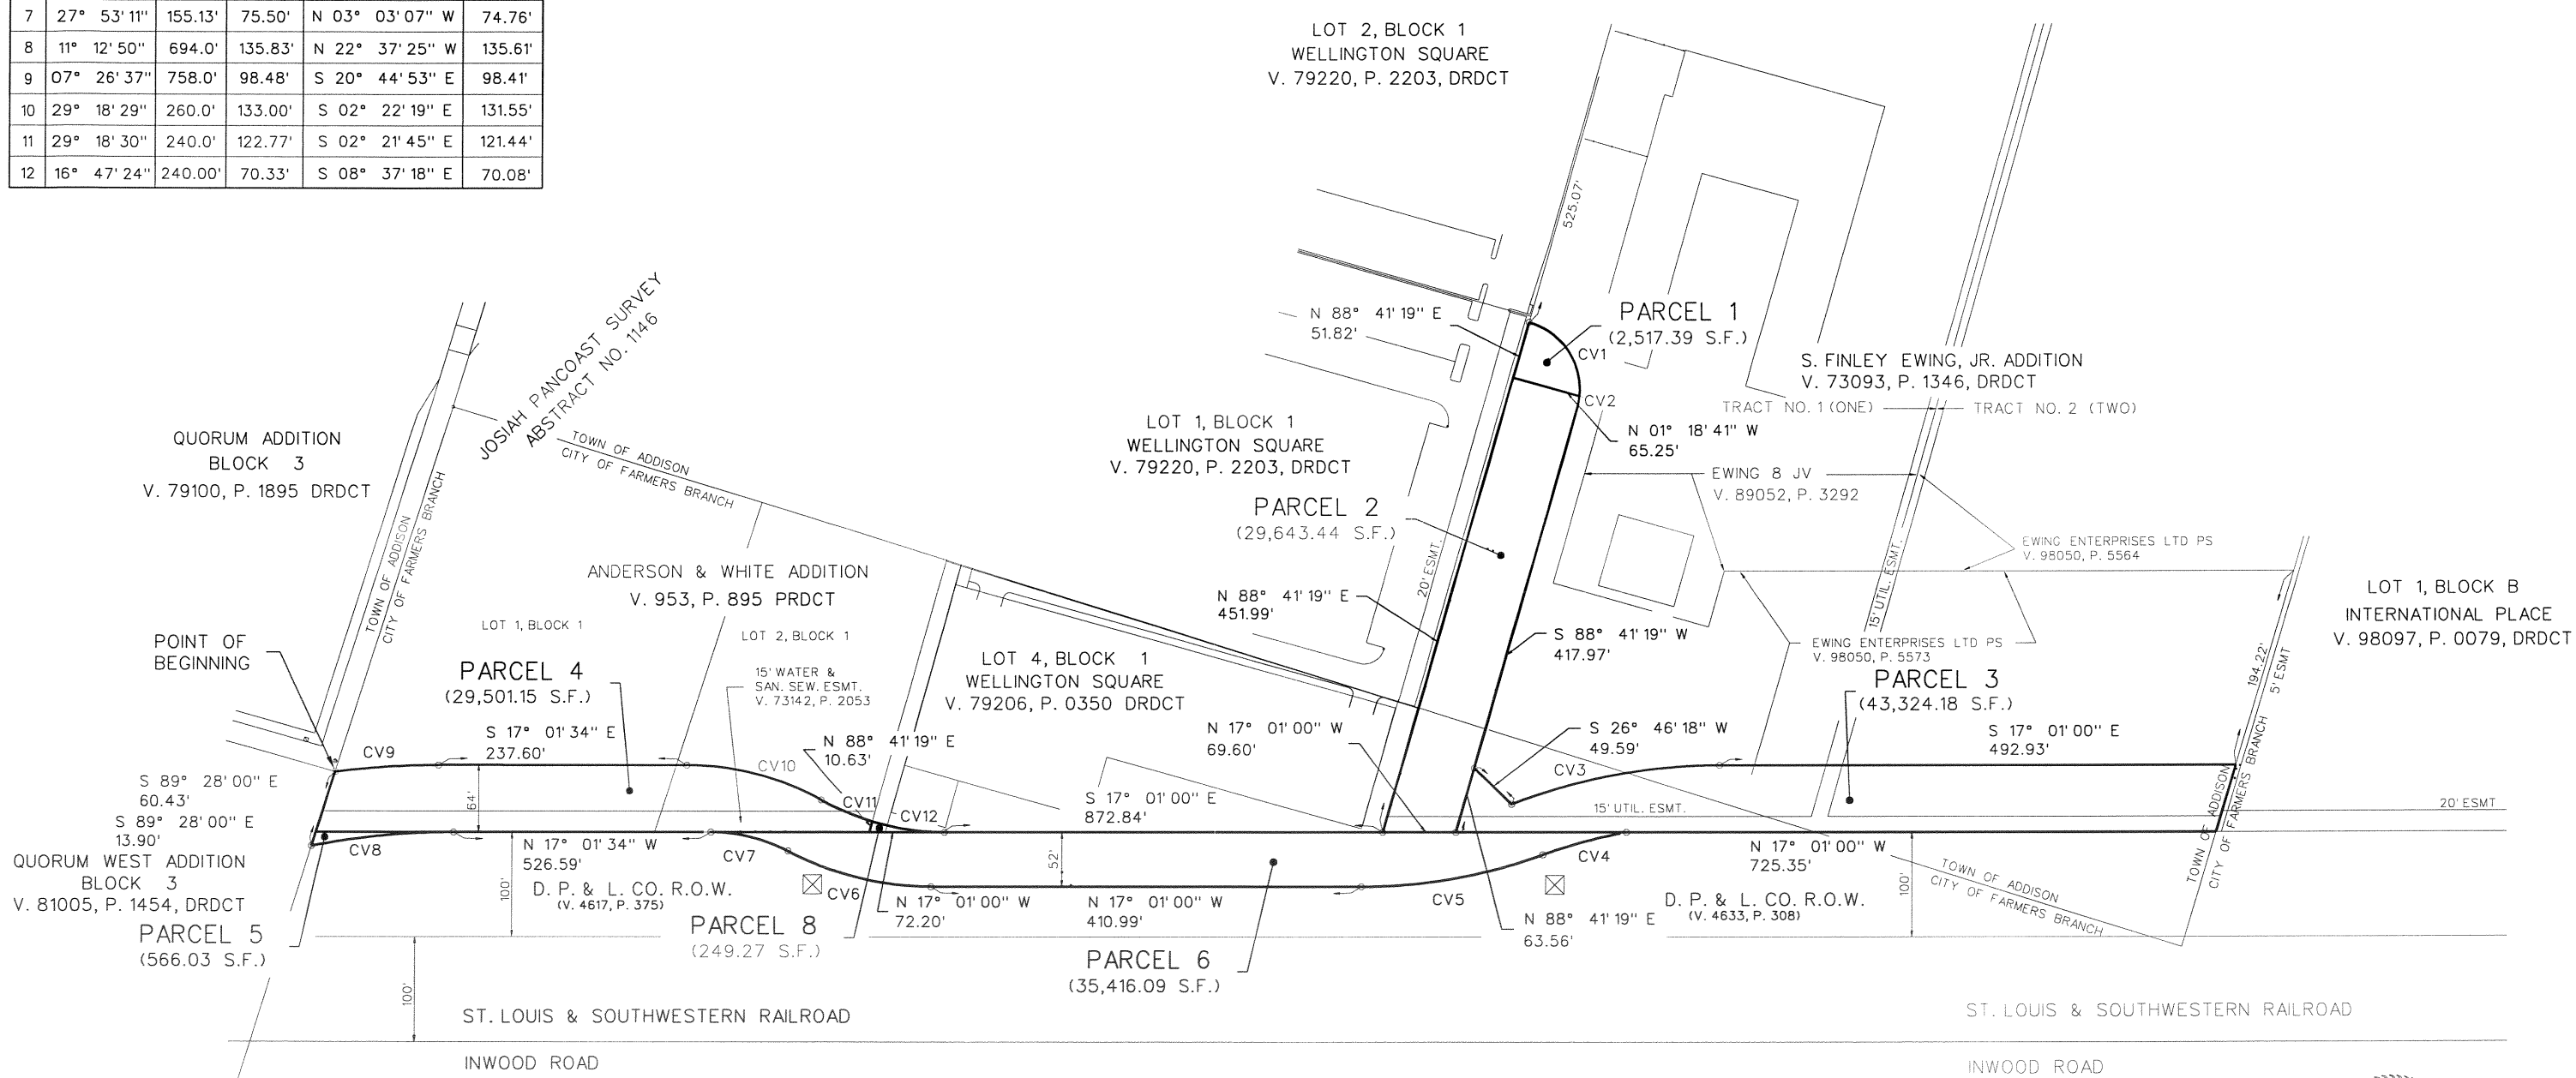
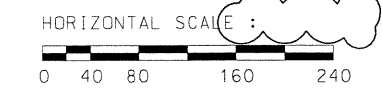


CURVE TABLE

CV NO.	DELTA	RADIUS	LENGTH	CHORD BEARING	CHORD LENGTH
1	76° 54' 19"	67.0'	89.93'	S 37° 08' 29" W	83.33'
2	13° 05' 41"	67.0'	15.31'	S 82° 08' 29" W	15.28'
3	21° 10' 23"	550.0'	203.25'	S 27° 36' 11" E	202.09'
4	09° 37' 23"	494.0'	82.97'	N 32° 09' 13" W	82.87'
5	19° 56' 54"	506.0'	176.17'	N 26° 59' 27" W	175.28'
6	27° 54' 28"	292.0'	142.23'	N 03° 03' 46" W	140.83'
7	27° 53' 11"	155.13'	75.50'	N 03° 03' 07" W	74.76'
8	11° 12' 50"	694.0'	135.83'	N 22° 37' 25" W	135.61'
9	07° 26' 37"	758.0'	98.48'	S 20° 44' 53" E	98.41'
10	29° 18' 29"	260.0'	133.00'	S 02° 22' 19" E	131.55'
11	29° 18' 30"	240.0'	122.77'	S 02° 21' 45" E	121.44'
12	16° 47' 24"	240.00'	70.33'	S 08° 37' 18" E	70.08'

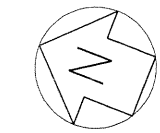

STATE OF TEXAS  
 WEIDONG LI  
 64718  
*Weidong Li*  
 7-20-01

RIGHT OF WAY MAP					
LANDMARK EXTENSION					
DEPARTMENT OF PUBLIC WORKS					
TOWN OF ADDISON, TEXAS					
DESIGN	DRAWN	DATE	SCALE	NOTES	FILE NUMBER
P.G.W.	C.W.W.	2/00	1"=160'	AS BUILT	7

1	MISC. REVISIONS	5/19/00
---	-----------------	---------