


PLAN
 SURVEYED BY
 DATE
 NOTE BOOK No.
 ALUMINUM CHECKED BY
 REVISIONS CHECKED BY

PROFILE
 SURVEYED BY
 DATE
 NOTE BOOK No.
 ALUMINUM CHECKED BY
 REVISIONS CHECKED BY

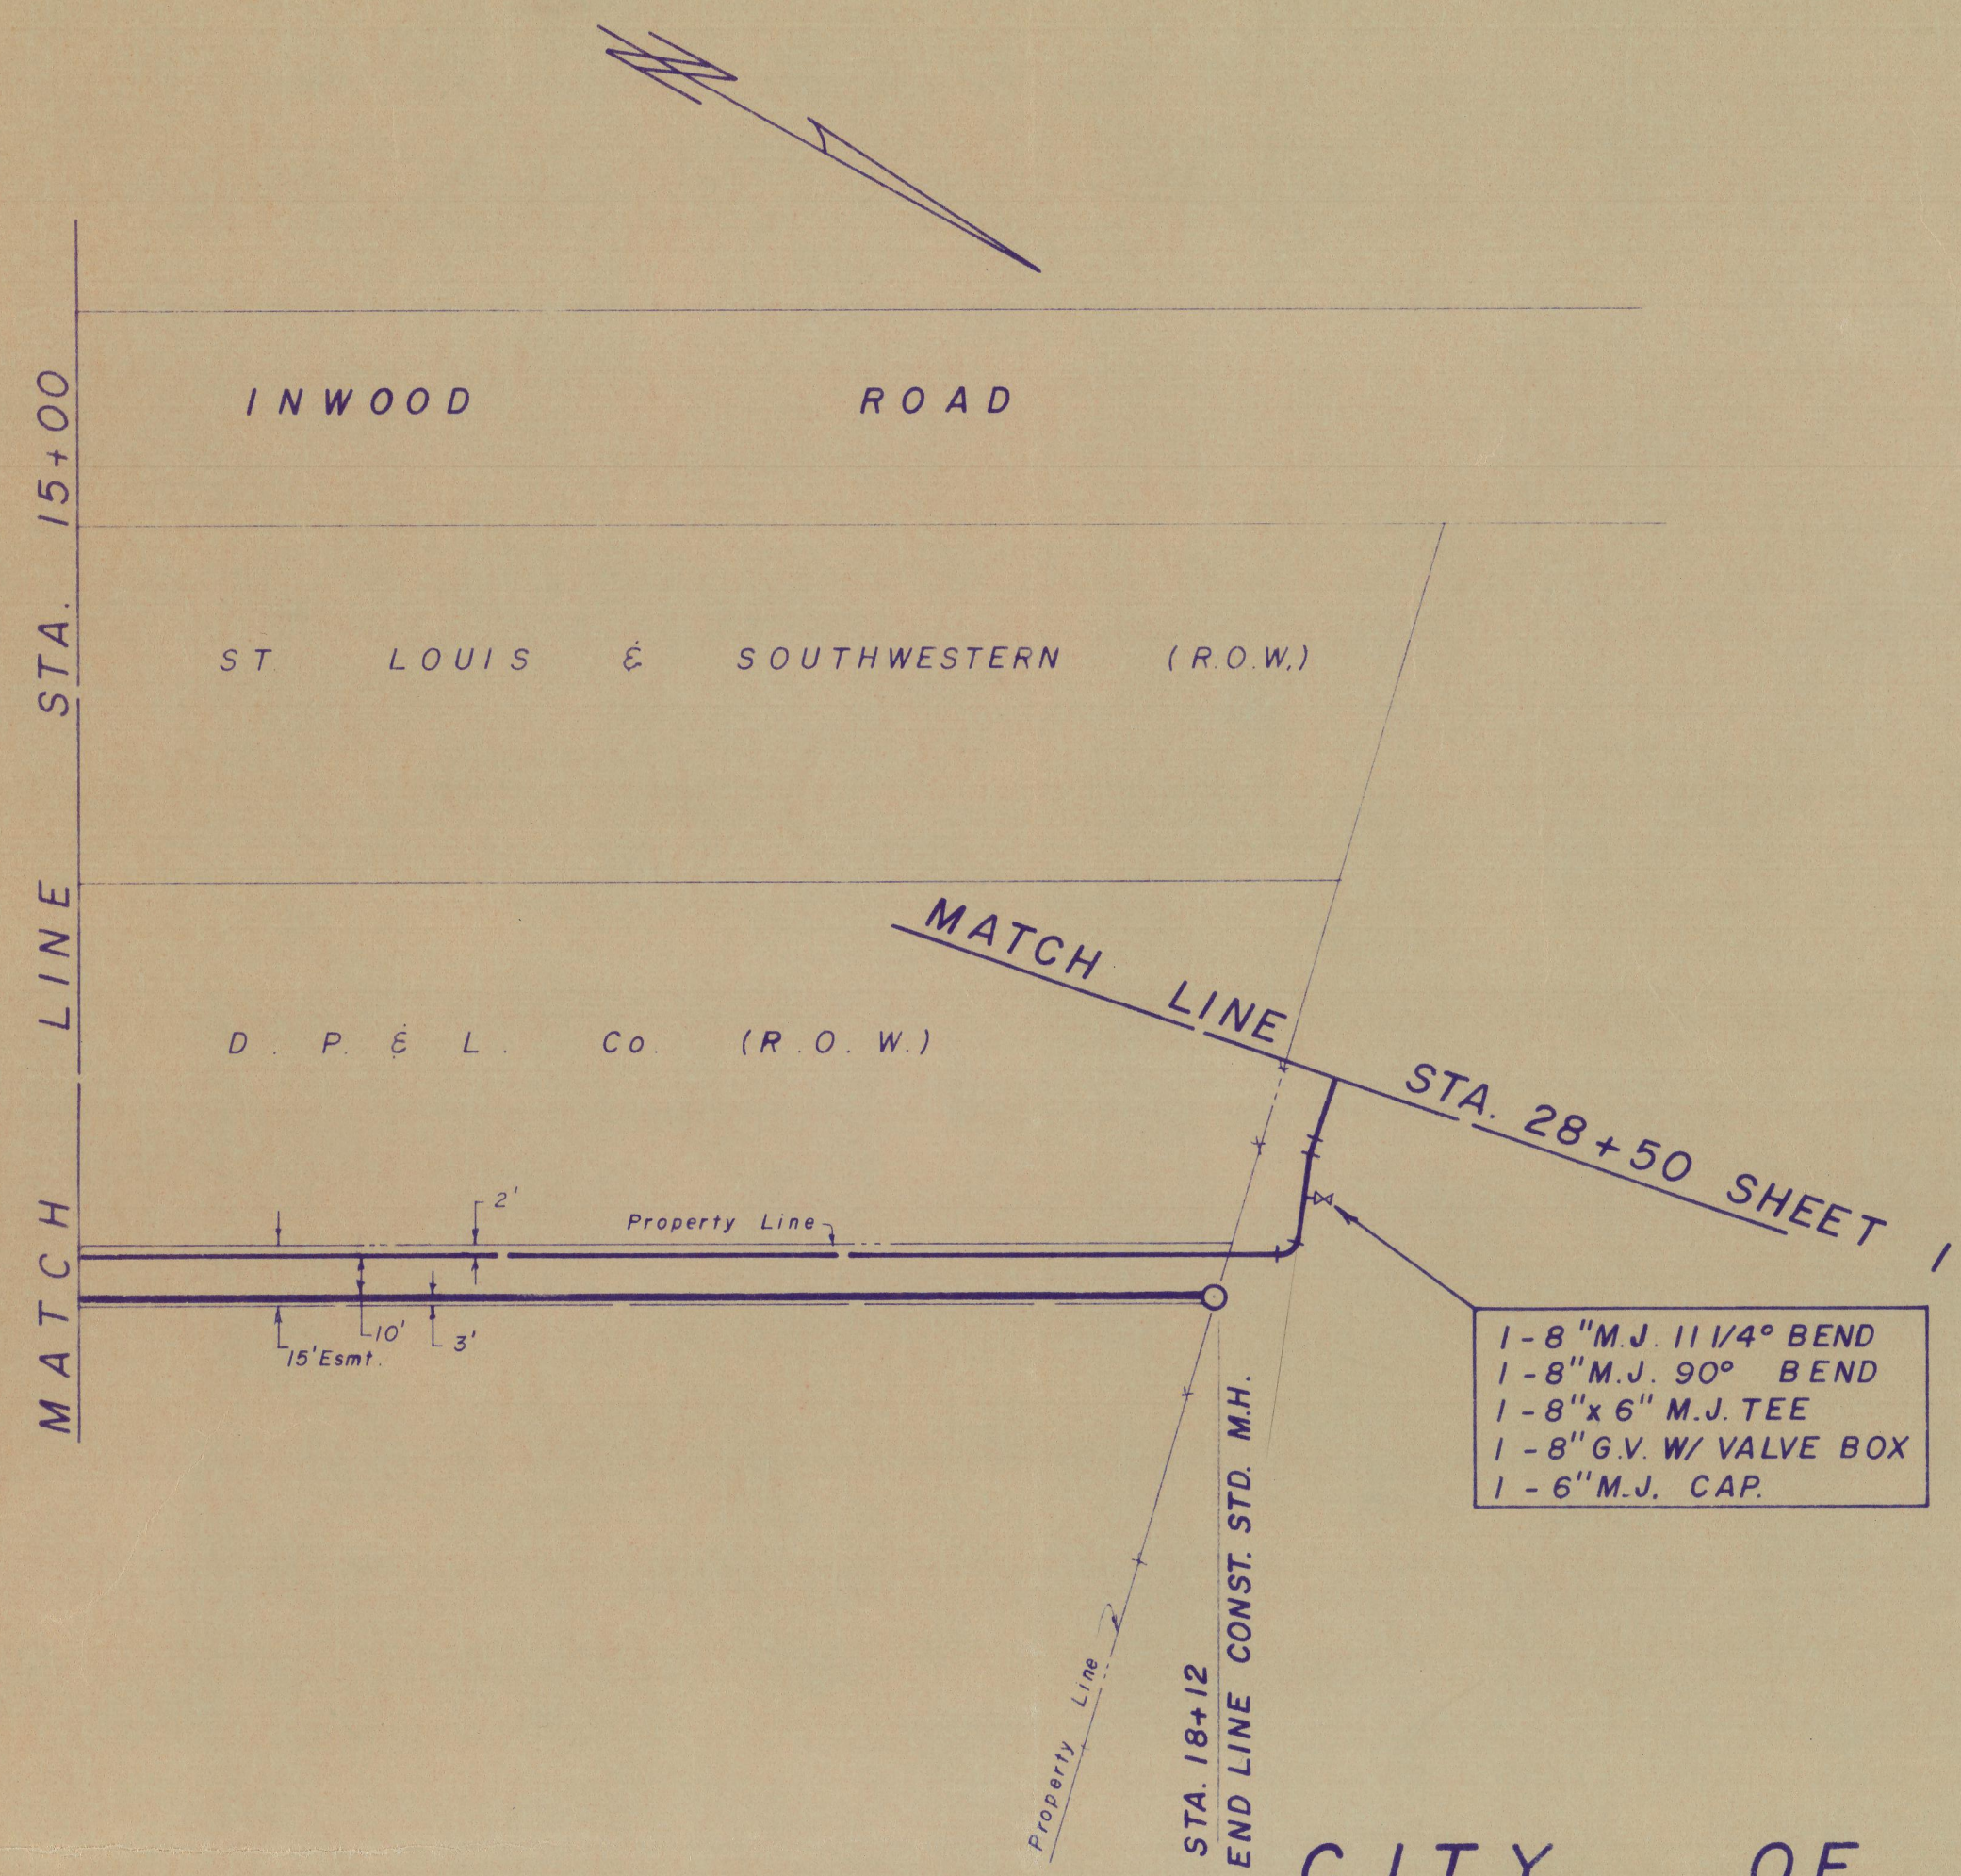

CITY OF ADDISON, TEXAS — SANITARY SEWER IMPROVEMENTS

CHANGE ORDER # 1

