


CONSTRUCTION PLANS  
for  
TURBINE AIR EXPANSION  
Addison Airport, Bldg. A-5  
2.404 Acres - Zoned I-3  
4550 Jimmy Doolittle Drive  
Town of Addison  
Dallas County, Texas  
December 2009

PW#:2009-03



THE CONTRACTOR SHALL CONTACT  
DIG-TESS AT 1-800-344-8377 A  
MINIMUM OF 48 HOURS PRIOR TO THE  
COMMENCEMENT OF ANY  
CONSTRUCTION ACTIVITIES

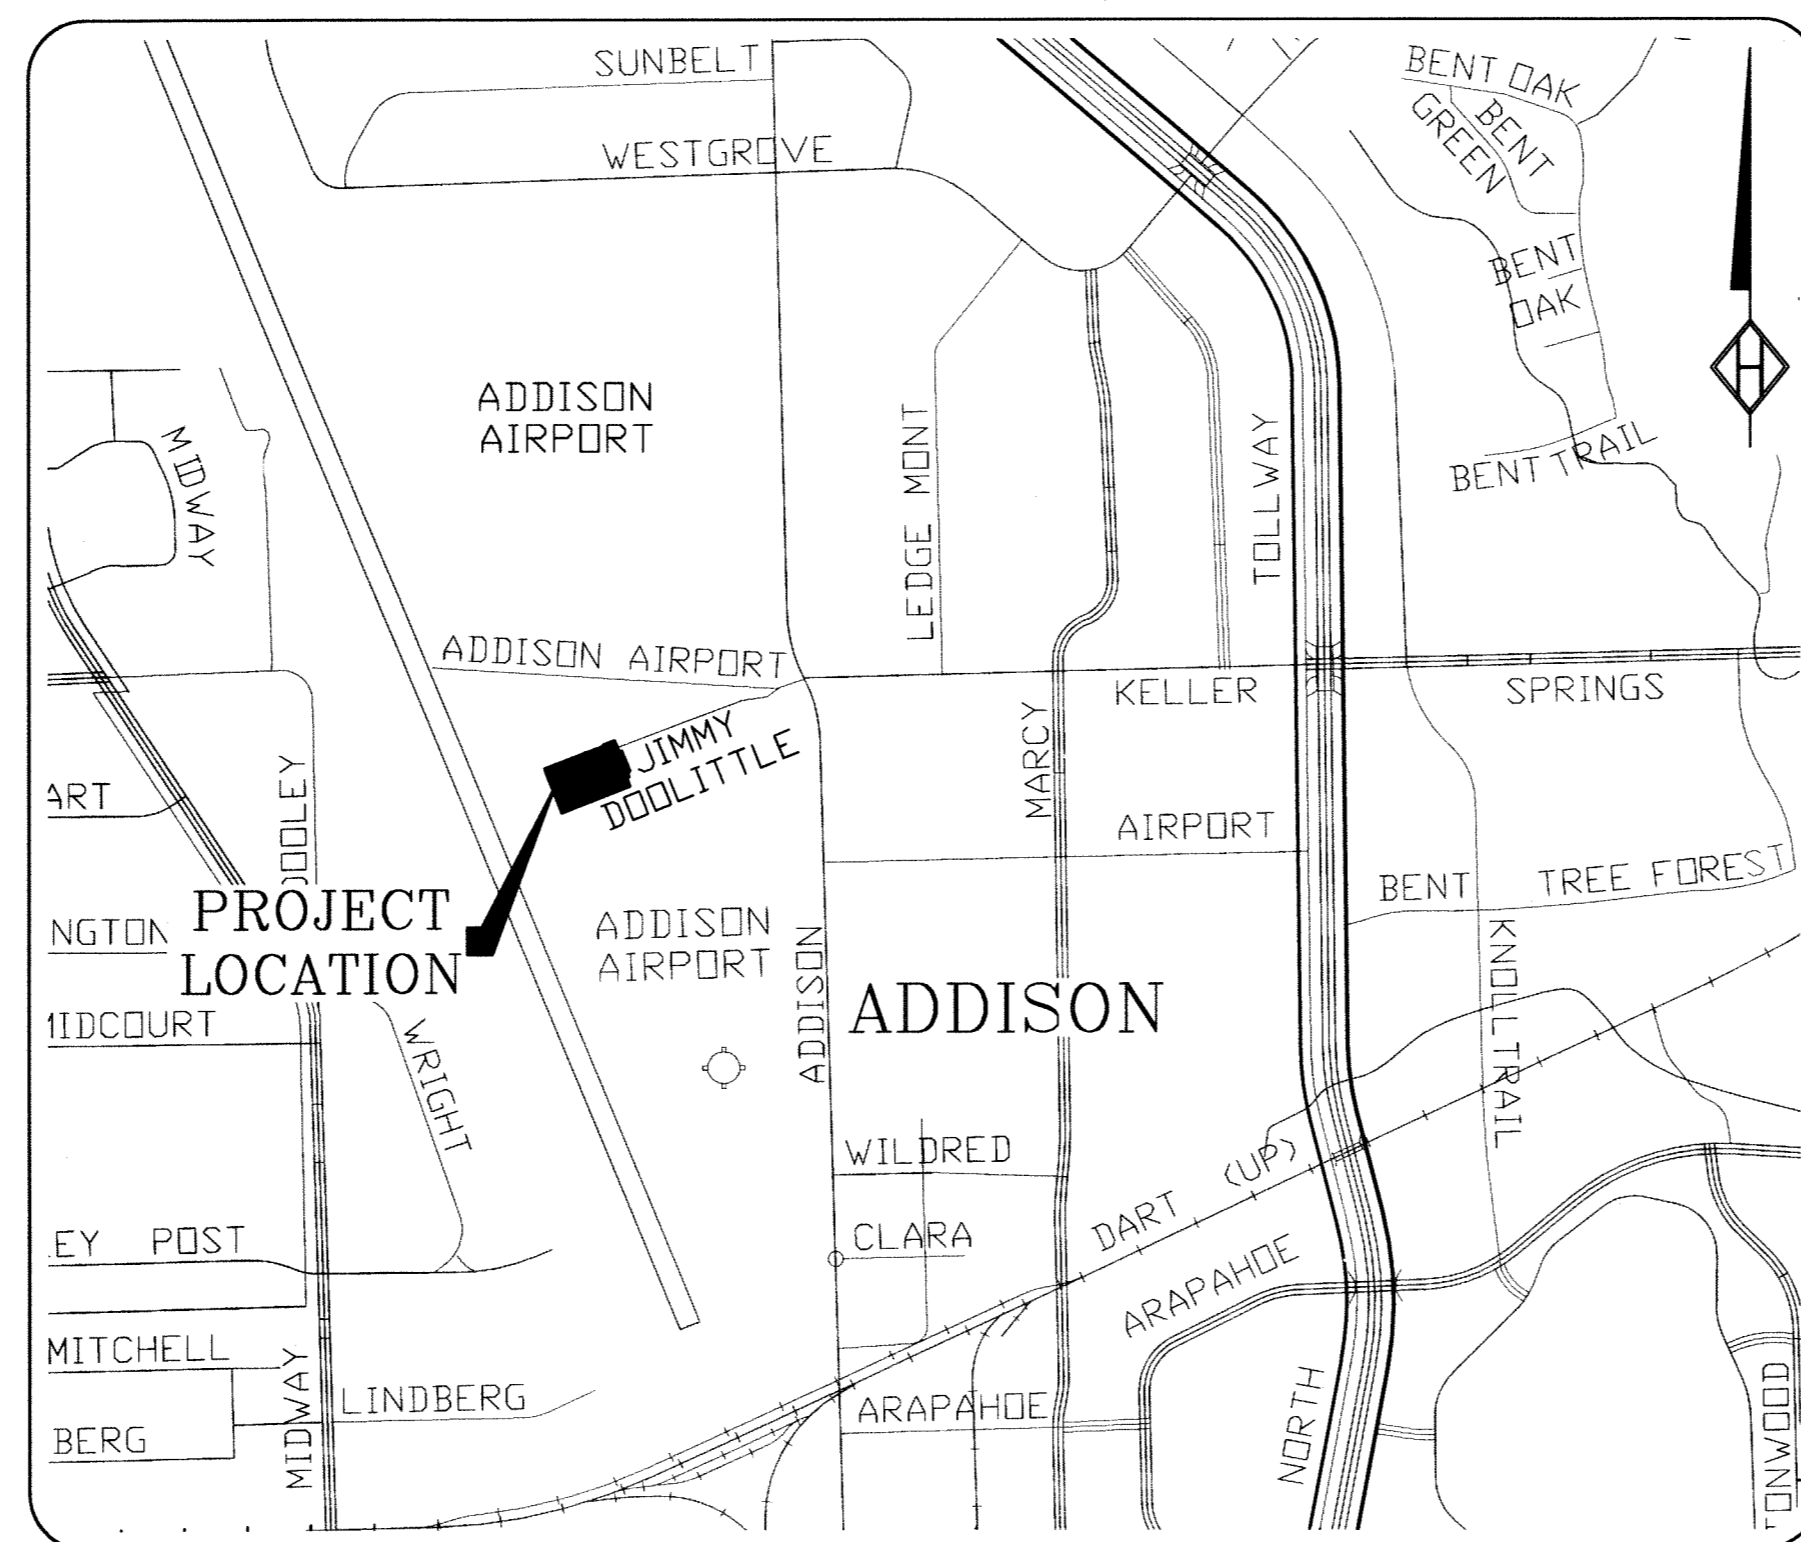

Vicinity Map 1"=1000'

SHEET INDEX


- Cover
- C1 General Notes
- C2 Demolition Plan
- C3 Site Plan
- C4 Grading Plan
- C5 Erosion Control Plan
- C6 Drainage Area Map
- C7 Details
- C8 Details
- C9 Details

THIS PLAN SET DATED  
DECEMBER 29, 2009 SHALL  
SUPERCEDE ALL PREVIOUSLY  
ISSUED PLAN SETS DUE TO  
BUILDING LAYOUT, FIRE LANE,  
AND GRADING CHANGES.

**ENGINEER**  
Homeyer Engineering, Inc.  
P.O. Box 294527  
Lewisville, Texas 75029  
Contact: Steven R. Homeyer, PE  
Phone: 972-906-9985

**OWNER/DEVELOPER**  
Turbine Aircraft Services, Inc.  
4550 Jimmy Doolittle Dr.  
Addison, Texas 75001  
Contact: Pat Cannon  
Phone: 214-649-2286

**RECORD DRAWING**  
The record drawing herein reflects to the best of the design engineer's knowledge, the approximate location of the constructed improvements using information provided by the contractor.  
*[Signature]*  
Steven R. Homeyer, P.E. #86942  
Date: 4-15-11

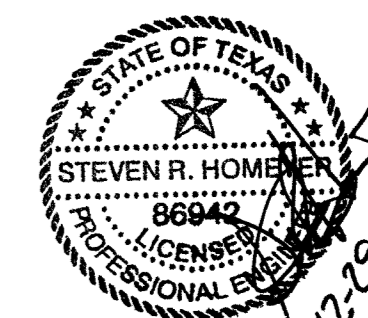

DRAWN: HEI  
DATE: 12/18/08  
HEI #: 08-152



TURBINE AIR EXPANSION  
ADDISON AIRPORT, BLDG. A-5  
2.404 ACRES, ZONED I-3  
4550 JIMMY DOOLITTLE DRIVE  
TOWN OF ADDISON  
DALLAS COUNTY, TEXAS

COVER SHEET

CONSTRUCTION PLANS

TURBINE AIR EXPANSION