


Texas Department of Transportation
Design Division (Roadway)

PEDESTRIAN HANDRAIL DETAILS

PRD-05 SHEET 1 of 2

NO.	DATE	BY	CHK.	REV.	DESCRIPTION
1	12/01/08	HEI	HEI	1	ISSUED

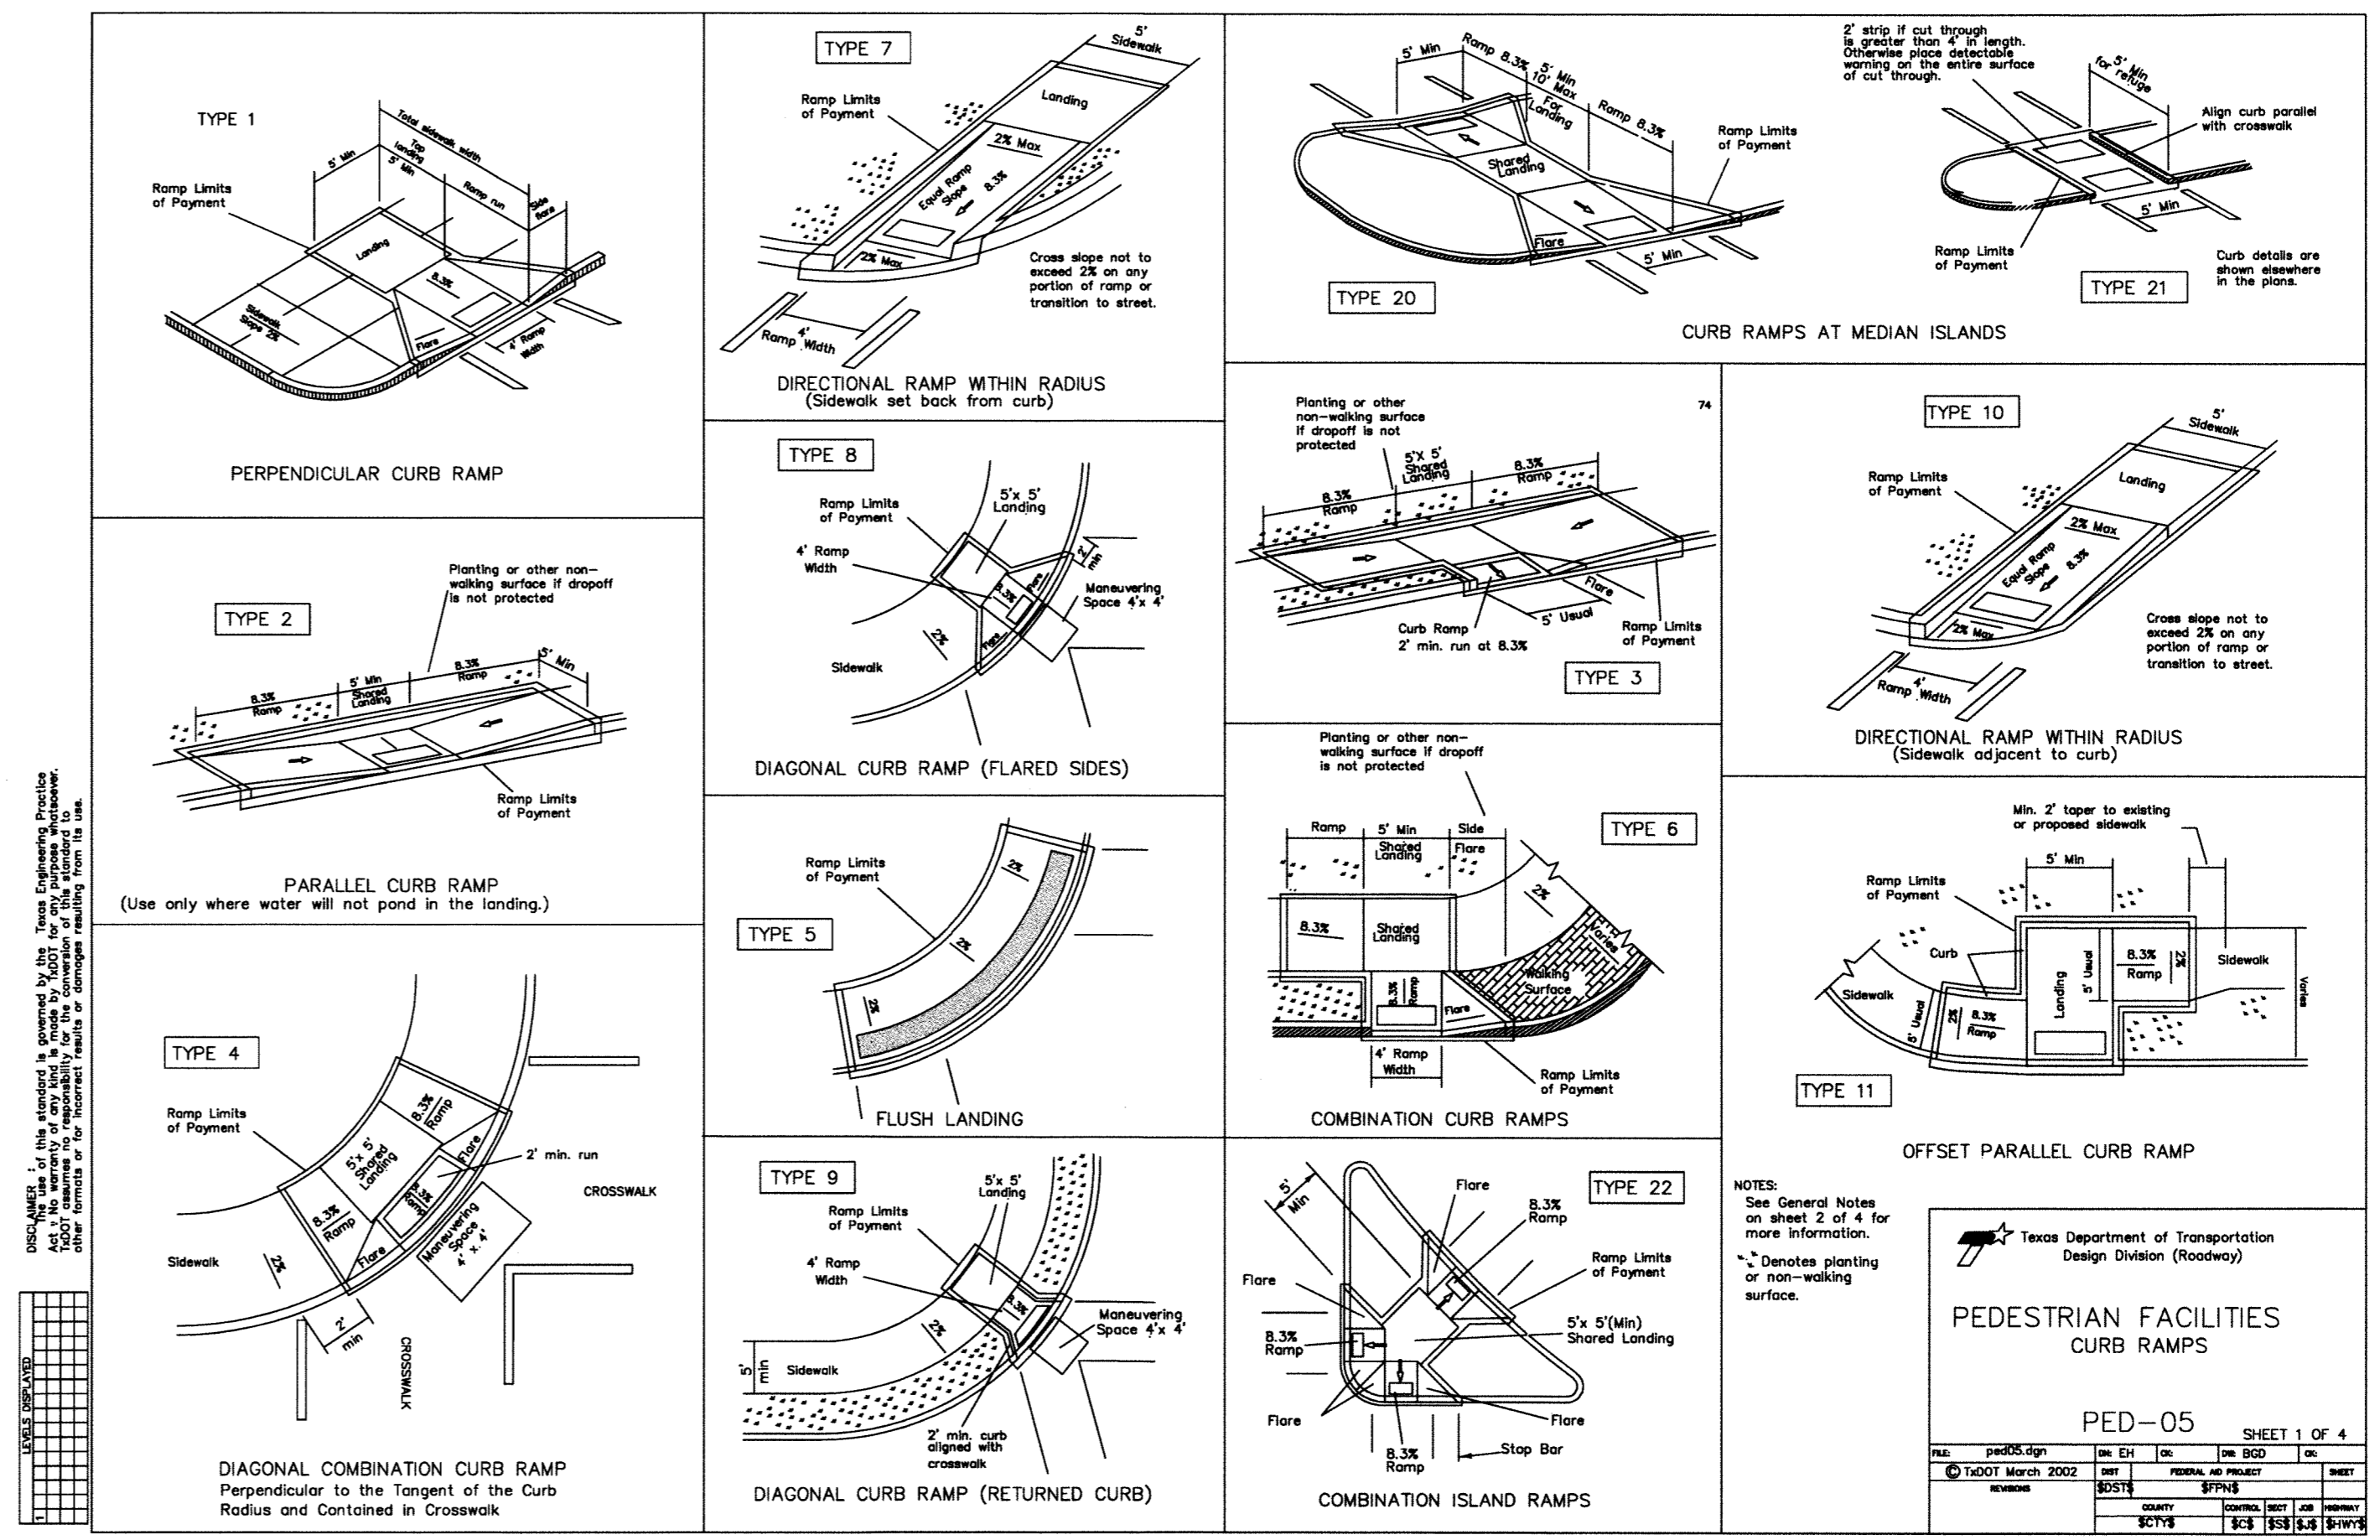


Texas Department of Transportation
Design Division (Roadway)

PEDESTRIAN FACILITIES CURB RAMP DETAILS

PED-05 SHEET 1 of 4

NO.	DATE	BY	CHK.	REV.	DESCRIPTION
1	12/01/08	HEI	HEI	1	ISSUED

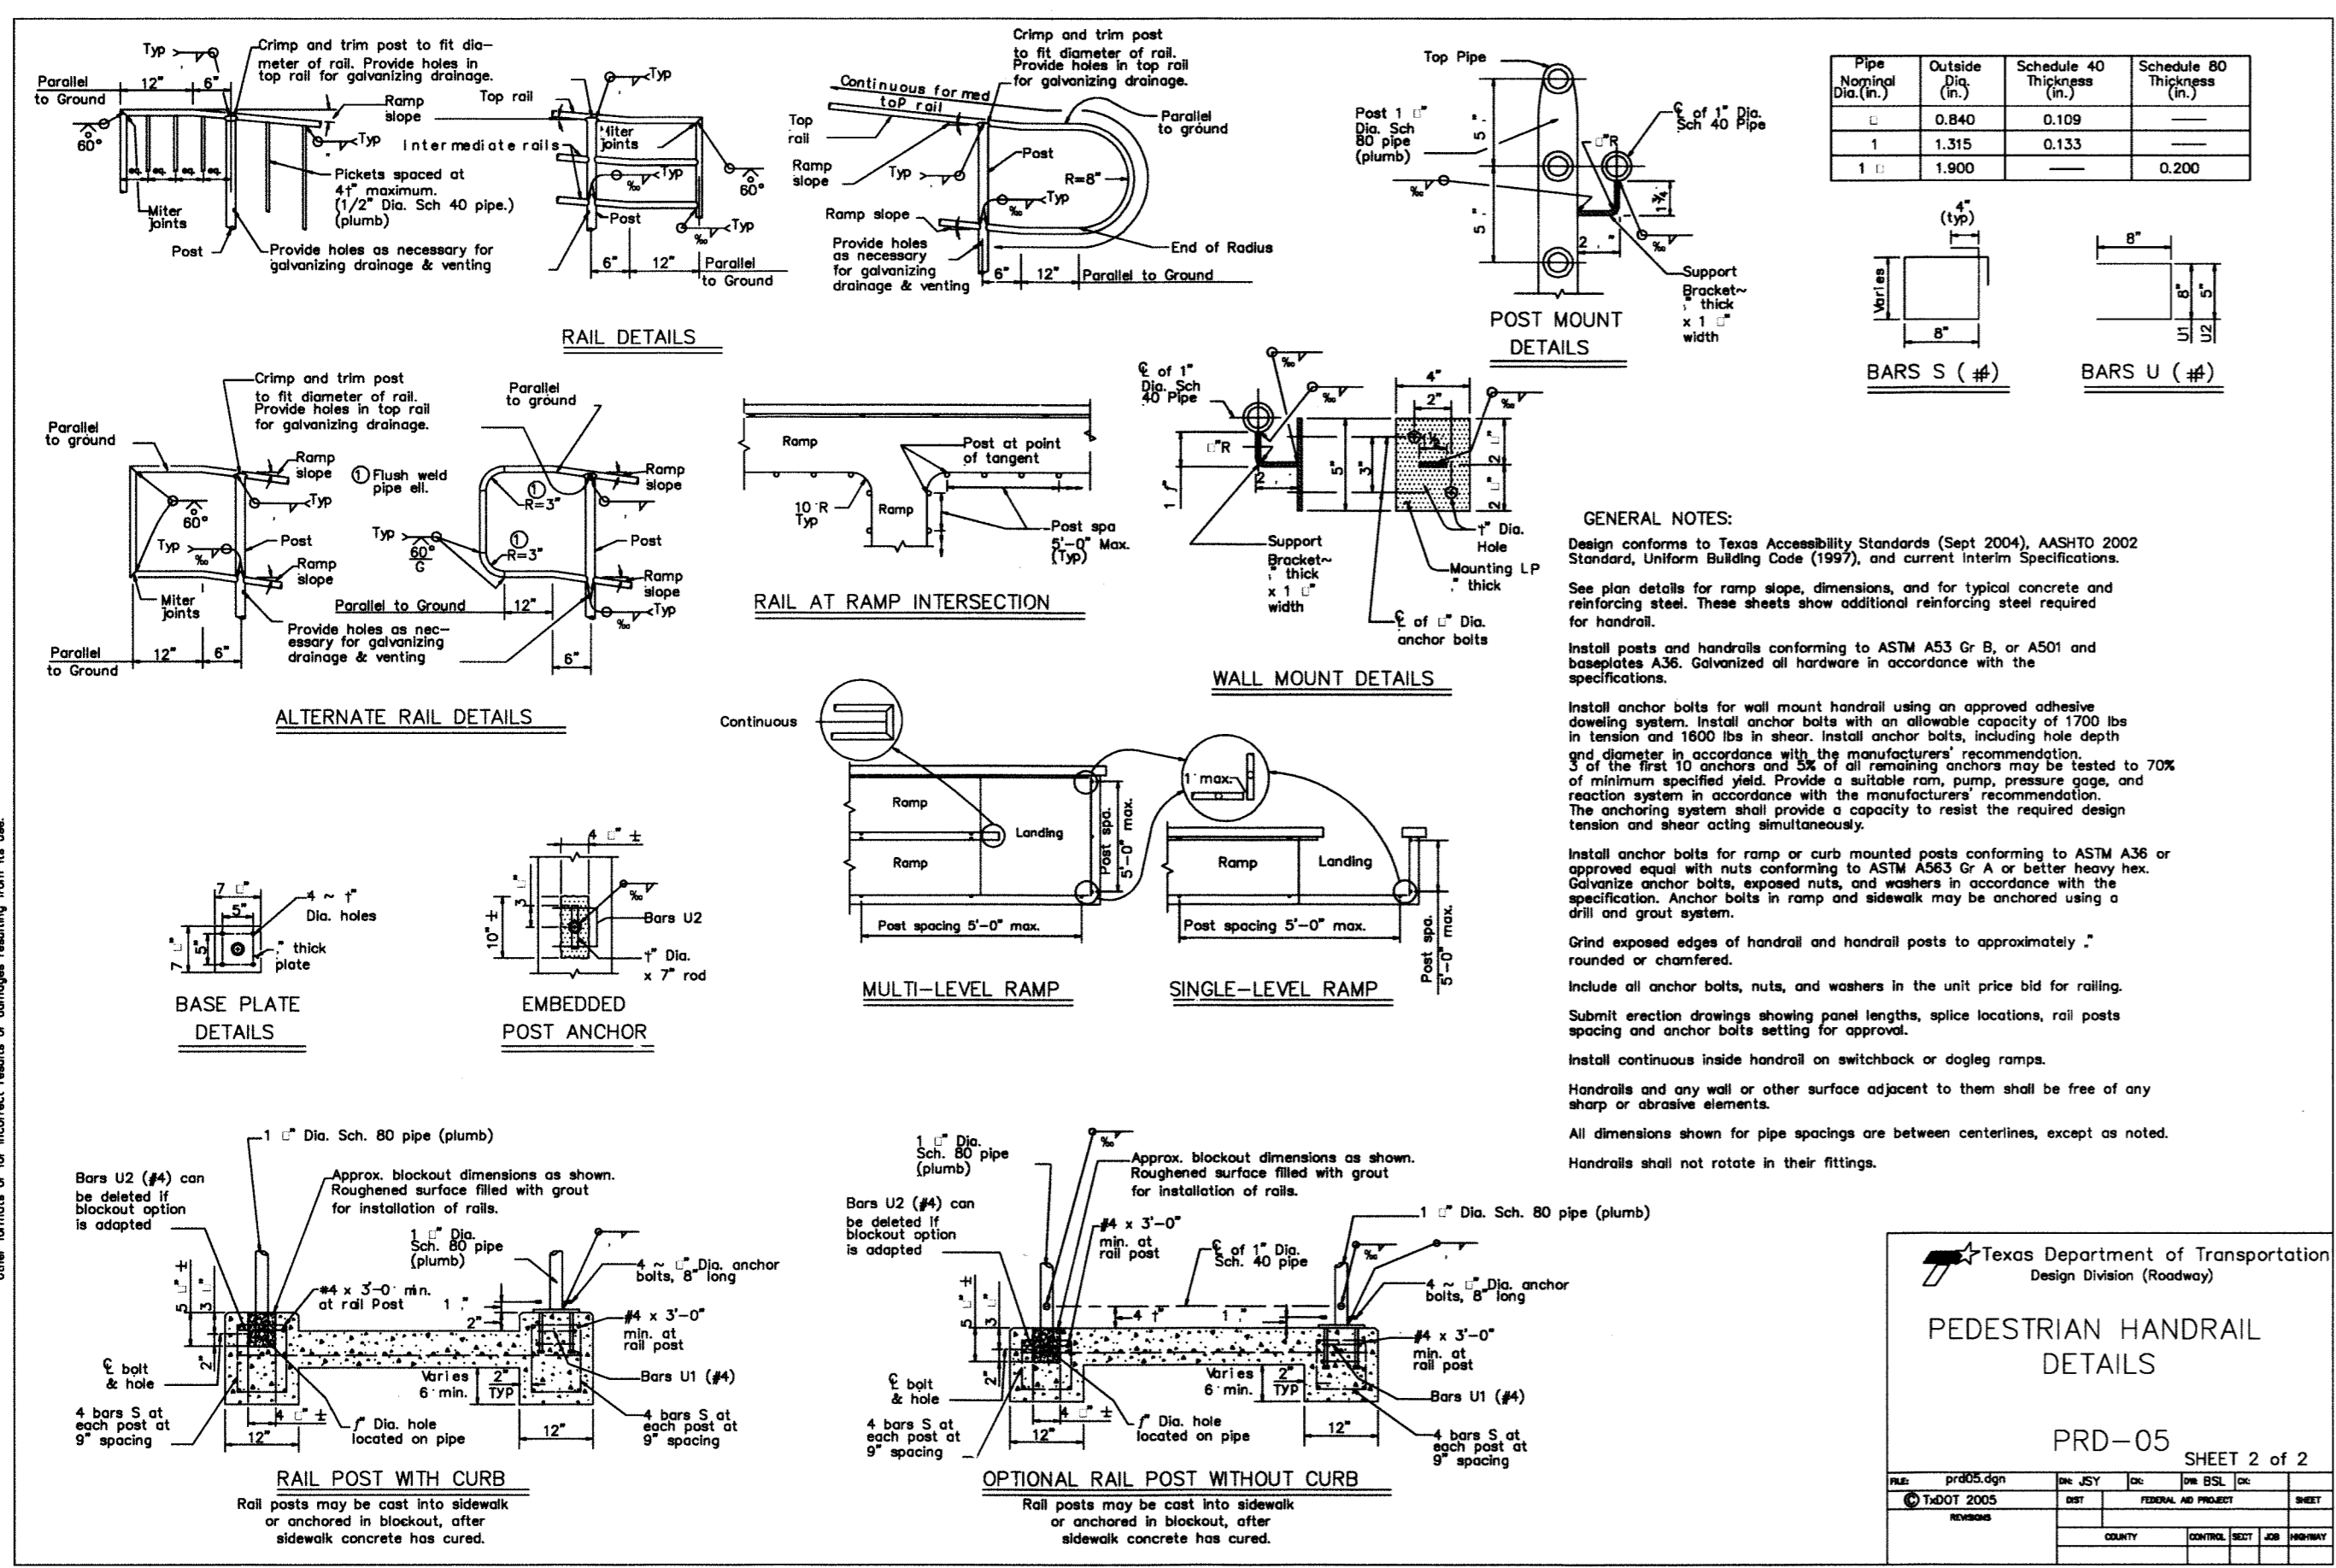


Texas Department of Transportation
Design Division (Roadway)

PEDESTRIAN HANDRAIL DETAILS

PRD-05 SHEET 2 of 2

NO.	DATE	BY	CHK.	REV.	DESCRIPTION
1	12/01/08	HEI	HEI	1	ISSUED

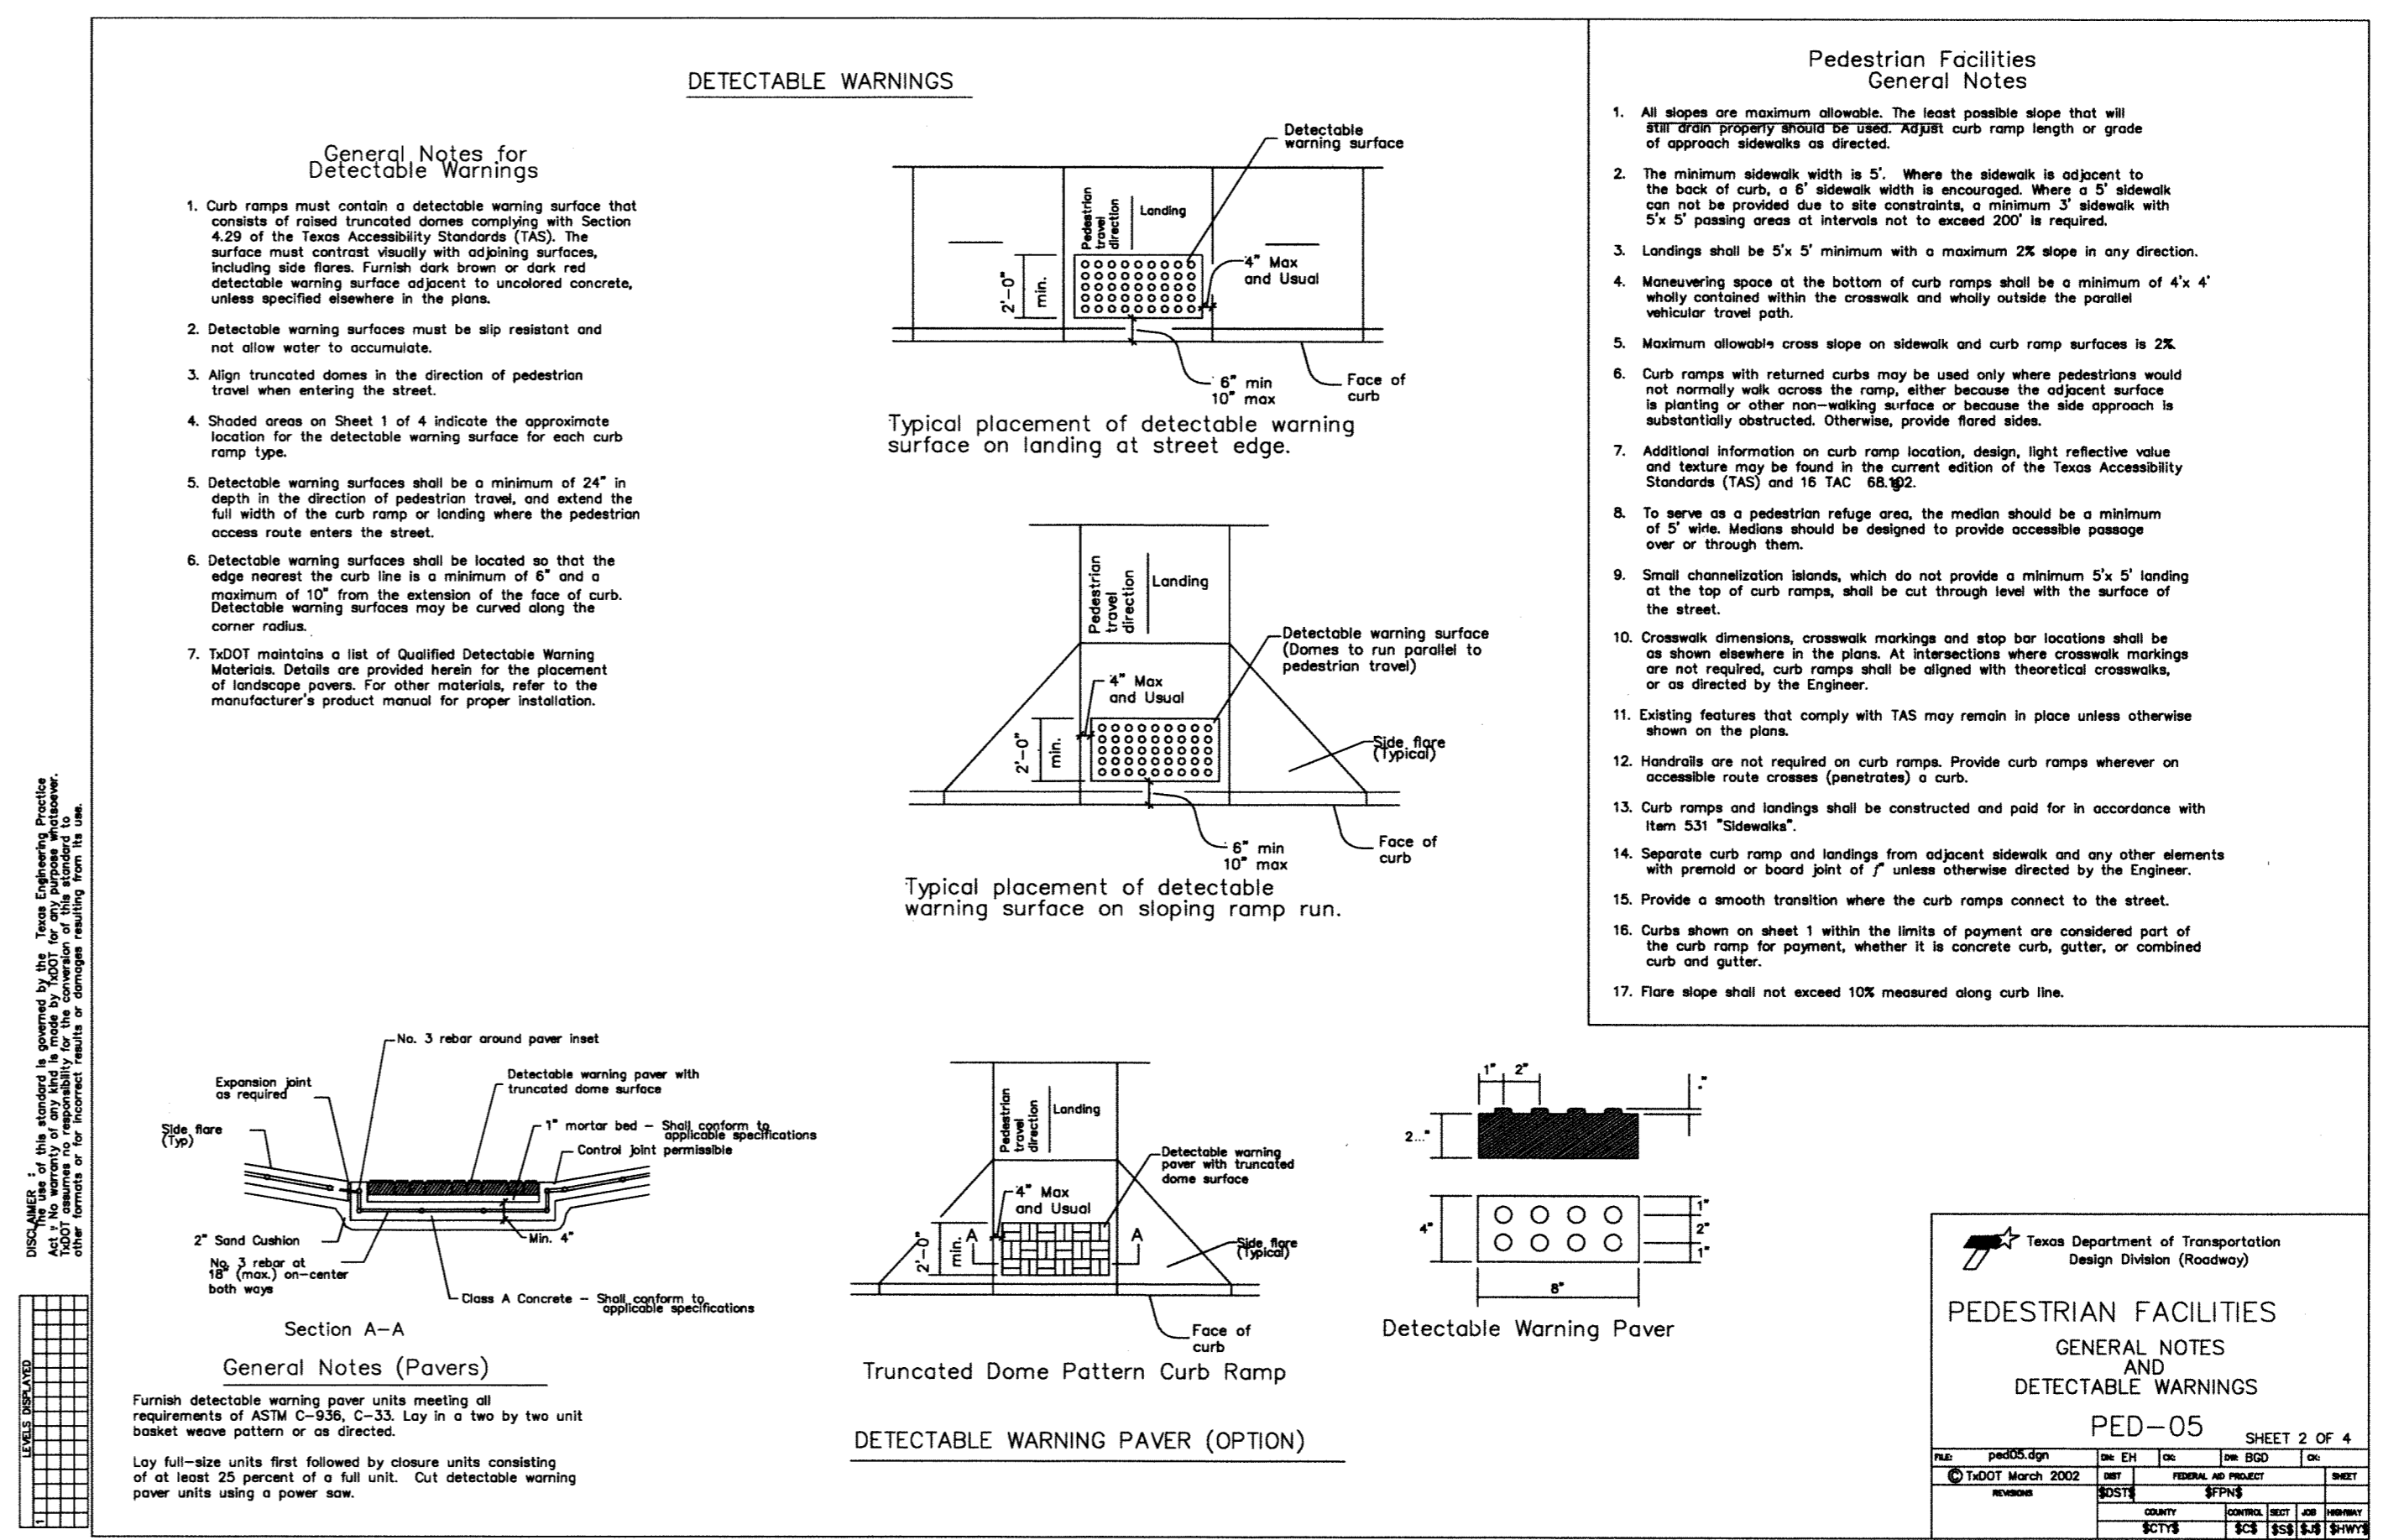

Texas Department of Transportation
Design Division (Roadway)

PEDESTRIAN FACILITIES GENERAL NOTES AND DETECTABLE WARNINGS

PED-05 SHEET 2 of 4

NO.	DATE	BY	CHK.	REV.	DESCRIPTION
1	12/01/08	HEI	HEI	1	ISSUED

RECORD DRAWING

The record drawing herein reflects to the best of the design engineer's knowledge, the approximate location of the constructed improvements using information provided by the contractor.

Steven R. Homeyer, P.E. #86942
Date: 4-15-11

