


RECORD DRAWING

The record drawing herein reflects to the best of the design engineer's knowledge, the approximate location of the constructed improvements using information provided by the contractor.

Steven R. Homeyer, P.E. #86942
Date: 4-15-11

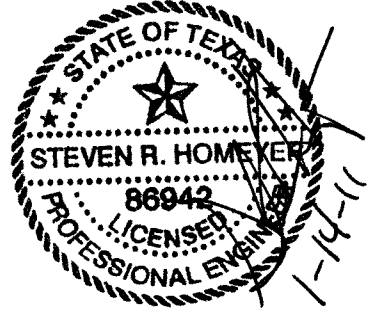


REVISIONS:
01/14/2011
1. REPLACED INLET
DETAIL AS SHOWN.

DRAWN: HEI
DATE: 12/18/08
HEI #: 08-152

SHEET NO:
C9

HOMMEYER
ENGINEERING, INC.
CIVIL ENGINEERING & PLANNING
SITE & LAND PLANNING
P.O. BOX 294527 • LEWISVILLE, TEXAS 75029
972-906-9955 PHONE • 972-906-9987 FAX
WWW.HOMMEYER-ENGINEERING.COM

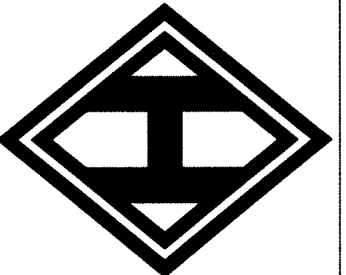

TURBINE AIR EXPANSION
ADDISON AIRPORT, BLDG. A-5
2.404 ACRES, ZONED - I-3
4550 JIMMY DOOLITTLE DRIVE
TOWN OF ADDISON
DALLAS COUNTY, TEXAS

DETAILS