



S-1 PARKING LOT IMPROVEMENTS

TOWN OF ADDISON ADDISON AIRPORT ADDISON, TEXAS

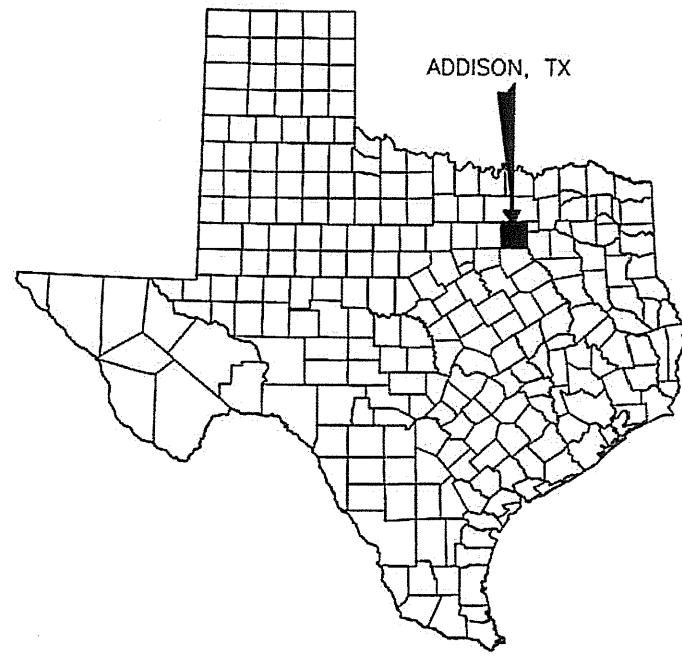


REGISTRATION NO.
F-5713

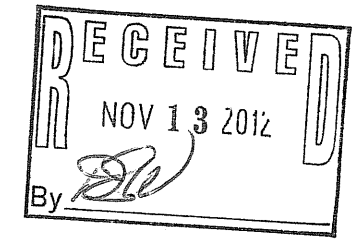

LOCATION MAP



ITEMS OF WORK
RECONSTRUCTION OF THE S-1 PARKING LOT

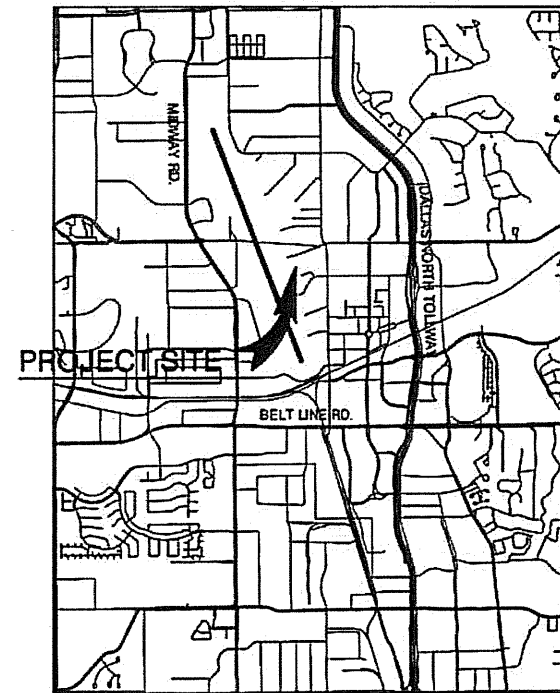

VICINITY MAP
NO SCALE

GARVER PROJECT NO. 12081100
BID NO. 12-17
JULY 2012



3010 Gaylord Parkway
Suite 190
Frisco, TX 75034
(972) 377-7480

RECORD DRAWINGS
10-30-2012

To the best knowledge of the Engineer, these drawings have been generally conformed to the construction of the improvements based on information supplied by the owner, contractor and/or resident project representative. The accuracy of the information contained within these record drawings is not guaranteed.

Frank O. McIlwain, P.E.
10/30/12
Date

REV.	DATE	DESCRIPTION	BY

ADDISON AIRPORT
ADDISON, TX

S-1 PARKING LOT IMPROVEMENTS

COVER SHEET

JOB NO.: 12081100
DATE: JULY, 2012
DESIGNED BY: MRM
DRAWN BY: EGC

BAR IS ONE INCH ON ORIGINAL DRAWING
IF NOT ONE INCH ON THIS SHEET, ADJUST SCALES ACCORDINGLY.

SHEET NUMBER

G-101

File: I:\2012\12081100 - ADS S-1 Parking Lot\Drawings\RECORD\ADS_SIP_G101-CO.dwg Last Saved: 10/30/2012 10:27 AM Last Saved by: MrMcConolly
 Last Printed by: McConolly, Mitchell, R Plot Size: AECOMono.ctb Plot Scale: 1:1 Plot Date: 10/30/2012 10:30 AM Printer Used: DWG To PDF.pc3