



File: L:\2012\12081100 - ADS S-1 Parking Lot\Drawings\RECRD\ADS\_S1P\_G104\_SC.dwg Last\_Save: 10/30/2012 10:36 AM Last\_saved\_by: Mrmcanally  
 Last\_plotted\_by: McAnally, Mitchell, R Plot\_Style: AECmono.ctb Plot\_Scaler: 1:1 Plot\_Date: 10/30/2012 10:37 AM Plotter\_used: DWG To PDF.pc3

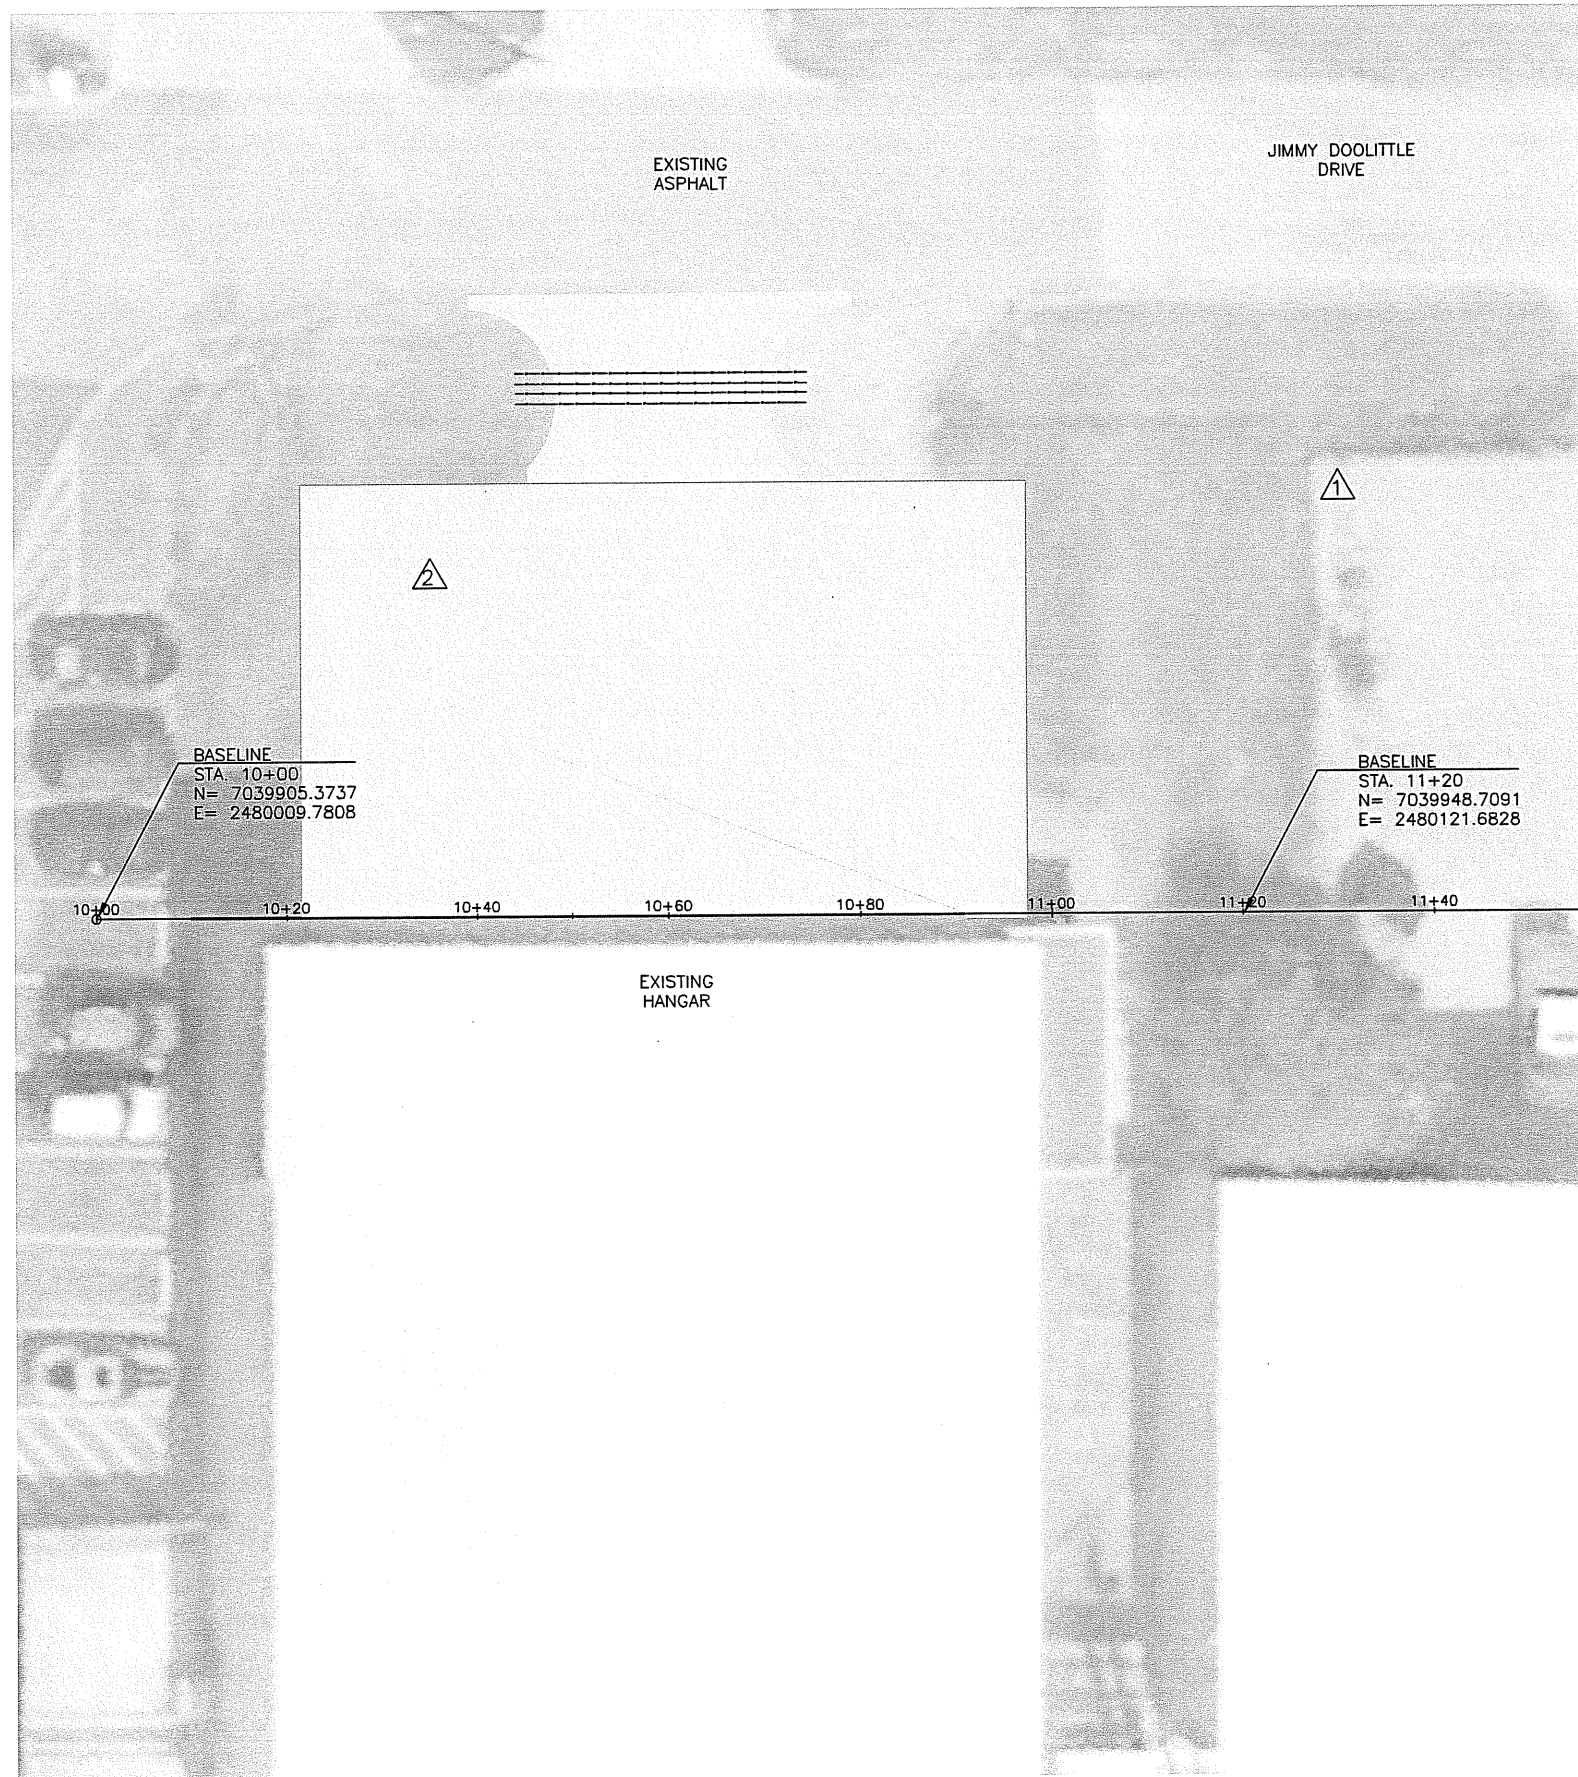

BASELINE  
 STA. 10+00  
 N= 7039905.3737  
 E= 2480009.7808

BASELINE  
 STA. 11+20  
 N= 7039948.7091  
 E= 2480121.6828

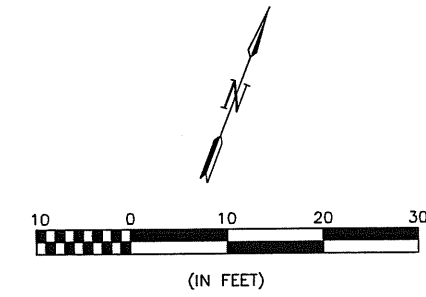

LEGEND	
	PAVING LIMITS

SURVEY CONTROL POINTS				
POINT NO.	NORTHING	EASTING	ELEVATION	DESCRIPTION
	7039993.30	2480115.30	638.87	NAIL
	7039950.90	2480029.56	638.98	NAIL



REGISTRATION NO.  
F-5713



REV.	DATE	DESCRIPTION	BY

ADDISON AIRPORT  
ADDISON, TX

S-1 PARKING LOT IMPROVEMENTS

SURVEY CONTROL  
PLAN

JOB NO.: 12081100  
DATE: JULY, 2012  
DESIGNED BY: MRM  
DRAWN BY: EGC

BAR IS ONE INCH ON ORIGINAL DRAWING  
IF NOT ONE INCH ON THIS SHEET, ADJUST SCALES ACCORDINGLY.

SHEET NUMBER

**G-104**

**RECORD DRAWINGS**  
10-30-2012