




File: L:\2012\12081100 - ADS S-1 Parking Lot\Drawings\RECORD\ADS_SIP_C105.dwg Last Saved: 10/30/2012 10:57 AM Last saved by: Mrmcconally
 Last plotted by: McAnally, Mitchell, R Plot Date: 10/30/2012 10:57 AM Plotter used: DWG To PDF.pc3

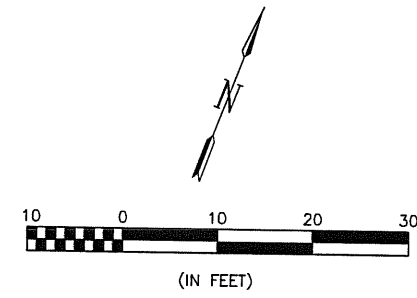

PAVEMENT JOINT LEGEND	
-----	TYPE "A-1" - REINFORCED ISOLATION JOINT
==	TYPE "B" - HINGED CONTRACTION JOINT
+	TYPE "C" - DOWELED CONTRACTION JOINT
X	TYPE "E" - DOWELED CONSTRUCTION JOINT

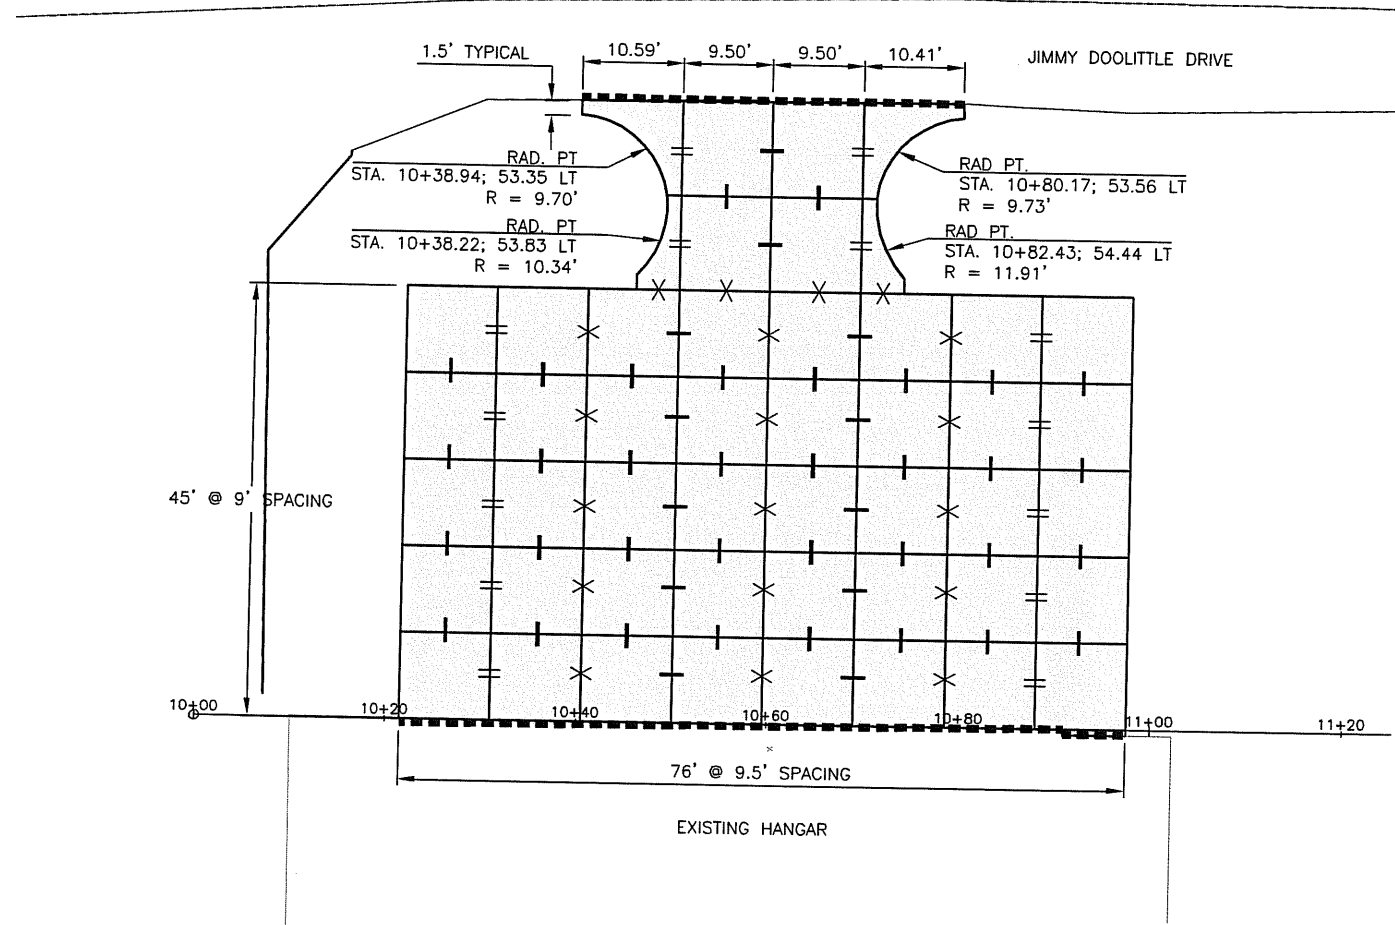

REGISTRATION NO. F-5713

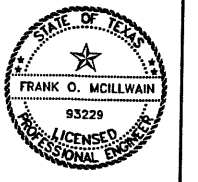

REV.	DATE	DESCRIPTION	BY

ADDISON AIRPORT
 ADDISON, TX
 S-1 PARKING LOT IMPROVEMENTS

JOINT LAYOUT PLAN

JOB NO.: 12081100
 DATE: JULY, 2012
 DESIGNED BY: MRM
 DRAWN BY: EGC

BAR IS ONE INCH ON ORIGINAL DRAWING
 IF NOT ONE INCH ON THIS SHEET, ADJUST SCALES ACCORDINGLY.

SHEET NUMBER

C-105

RECORD DRAWINGS
 10-30-2012