

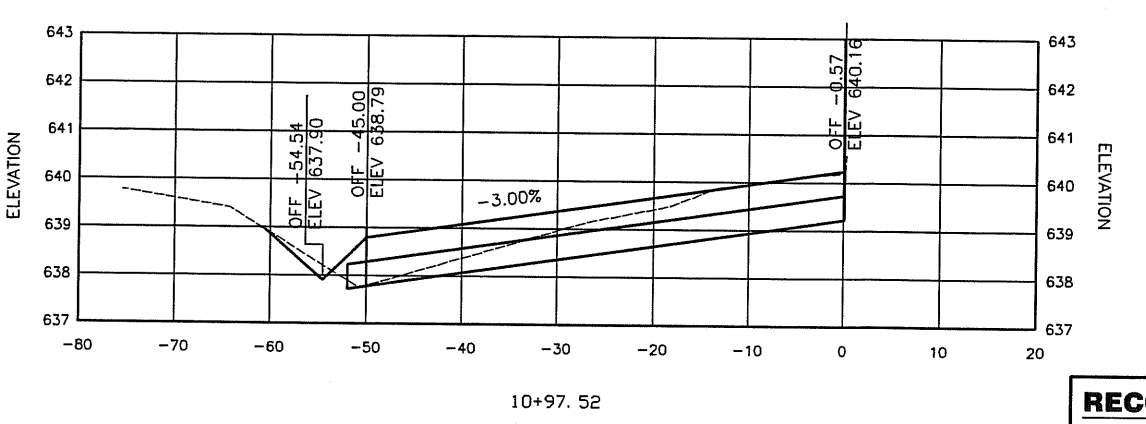
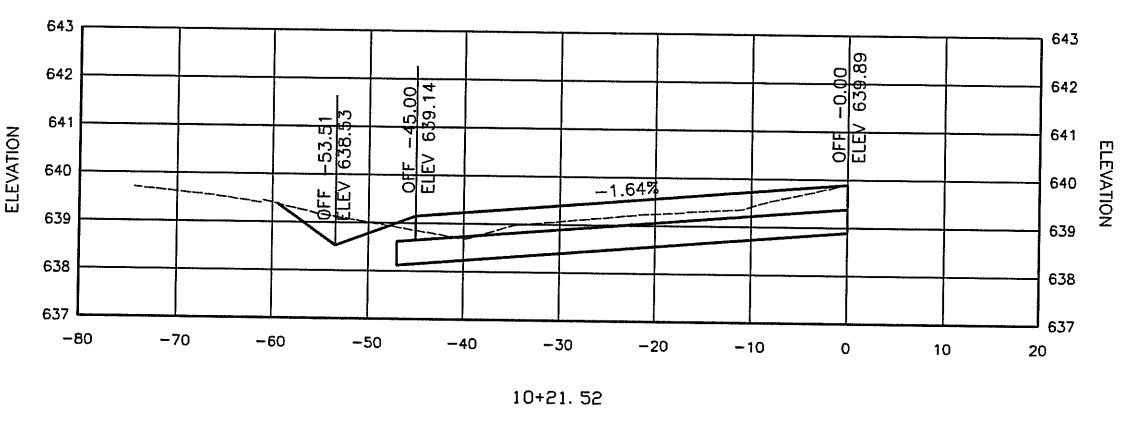
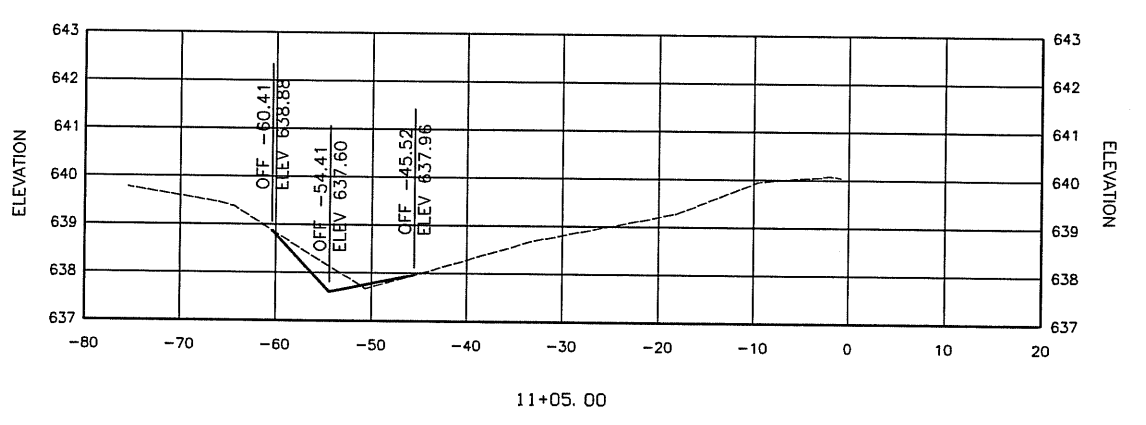
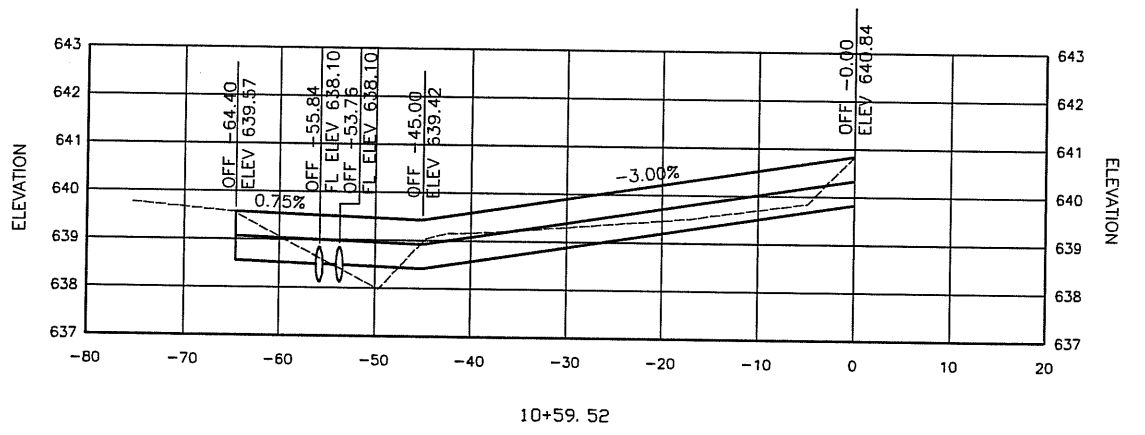
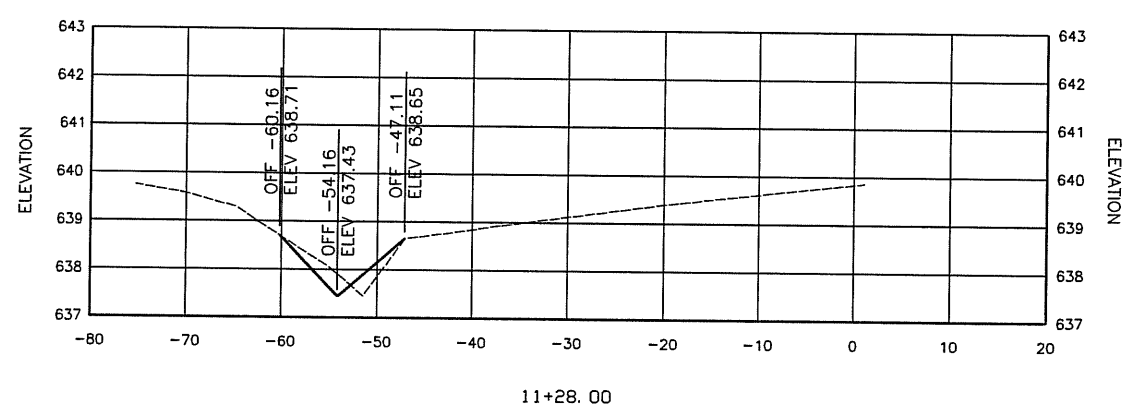
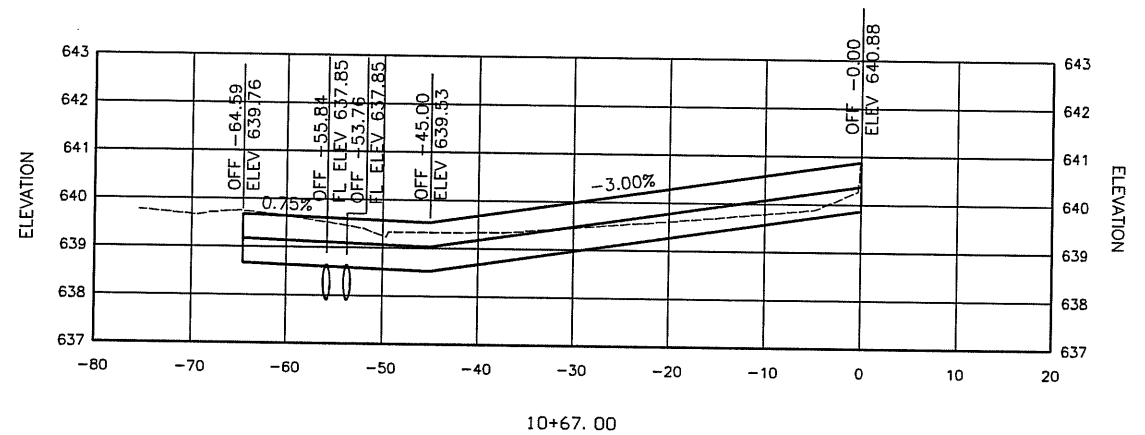
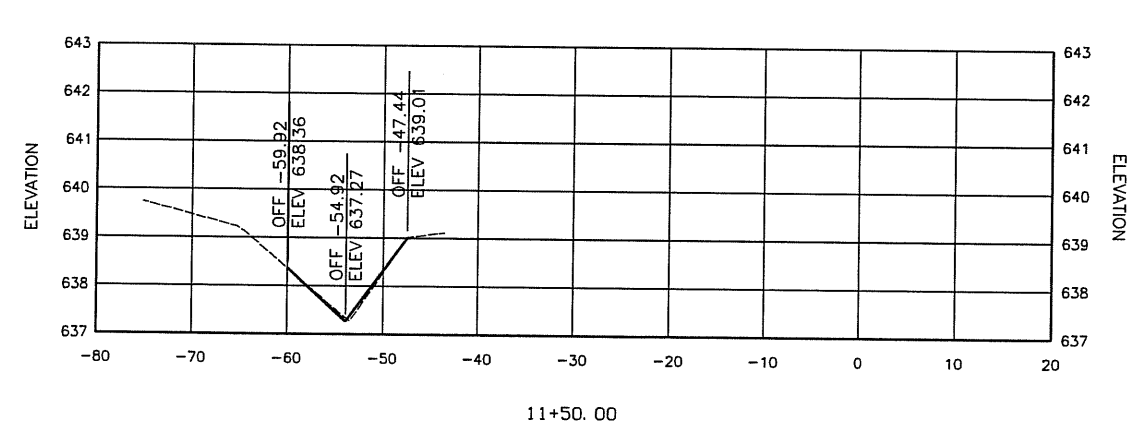


File: L:\2012\12081100 - ADS S-1 Parking Lot\Drawings\RECORD\ADS\_S1P\_S1X1.dwg Last Saved: 10/30/2012 11:01 AM Last saved by: Mrmccorally  
 Last plotted by: McAnally, Mitchell, R Plot Styles: AECmono.ctb Plot Scale: 1:1 Plot Date: 10/30/2012 11:02 AM Plotter used: DWG to PDF.pc3

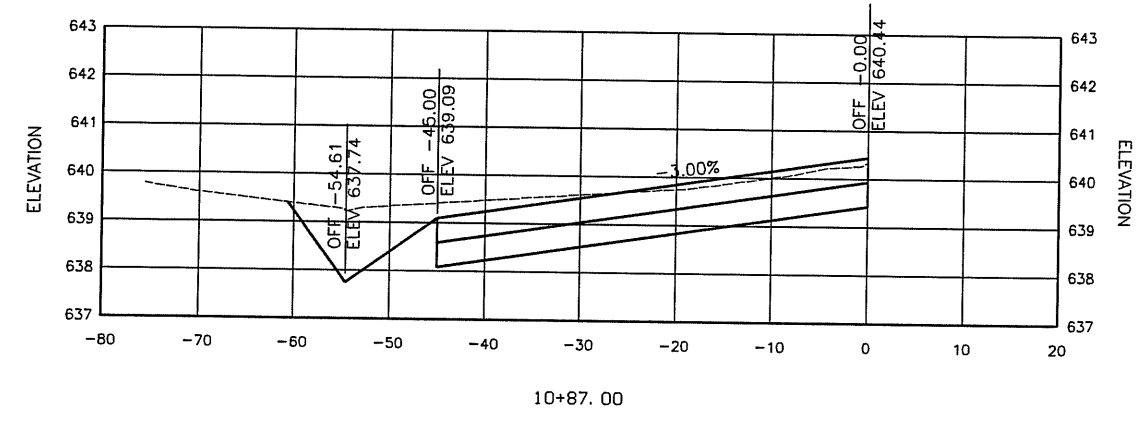

REGISTRATION NO.  
F-5713

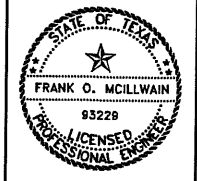

REV.	DATE	DESCRIPTION	BY

ADDISON AIRPORT  
ADDISON, TX

S-1 PARKING LOT IMPROVEMENTS

S-1 PARKING LOT -  
CROSS SECTIONS

JOB NO.: 12081100  
DATE: JULY, 2012  
DESIGNED BY: MRM  
DRAWN BY: EGC

BAR IS ONE INCH ON ORIGINAL DRAWING  
IF NOT ONE INCH ON THIS SHEET, ADJUST SCALES ACCORDINGLY.

SHEET NUMBER  
**S1-X1**

**RECORD DRAWINGS**  
10-30-2012