
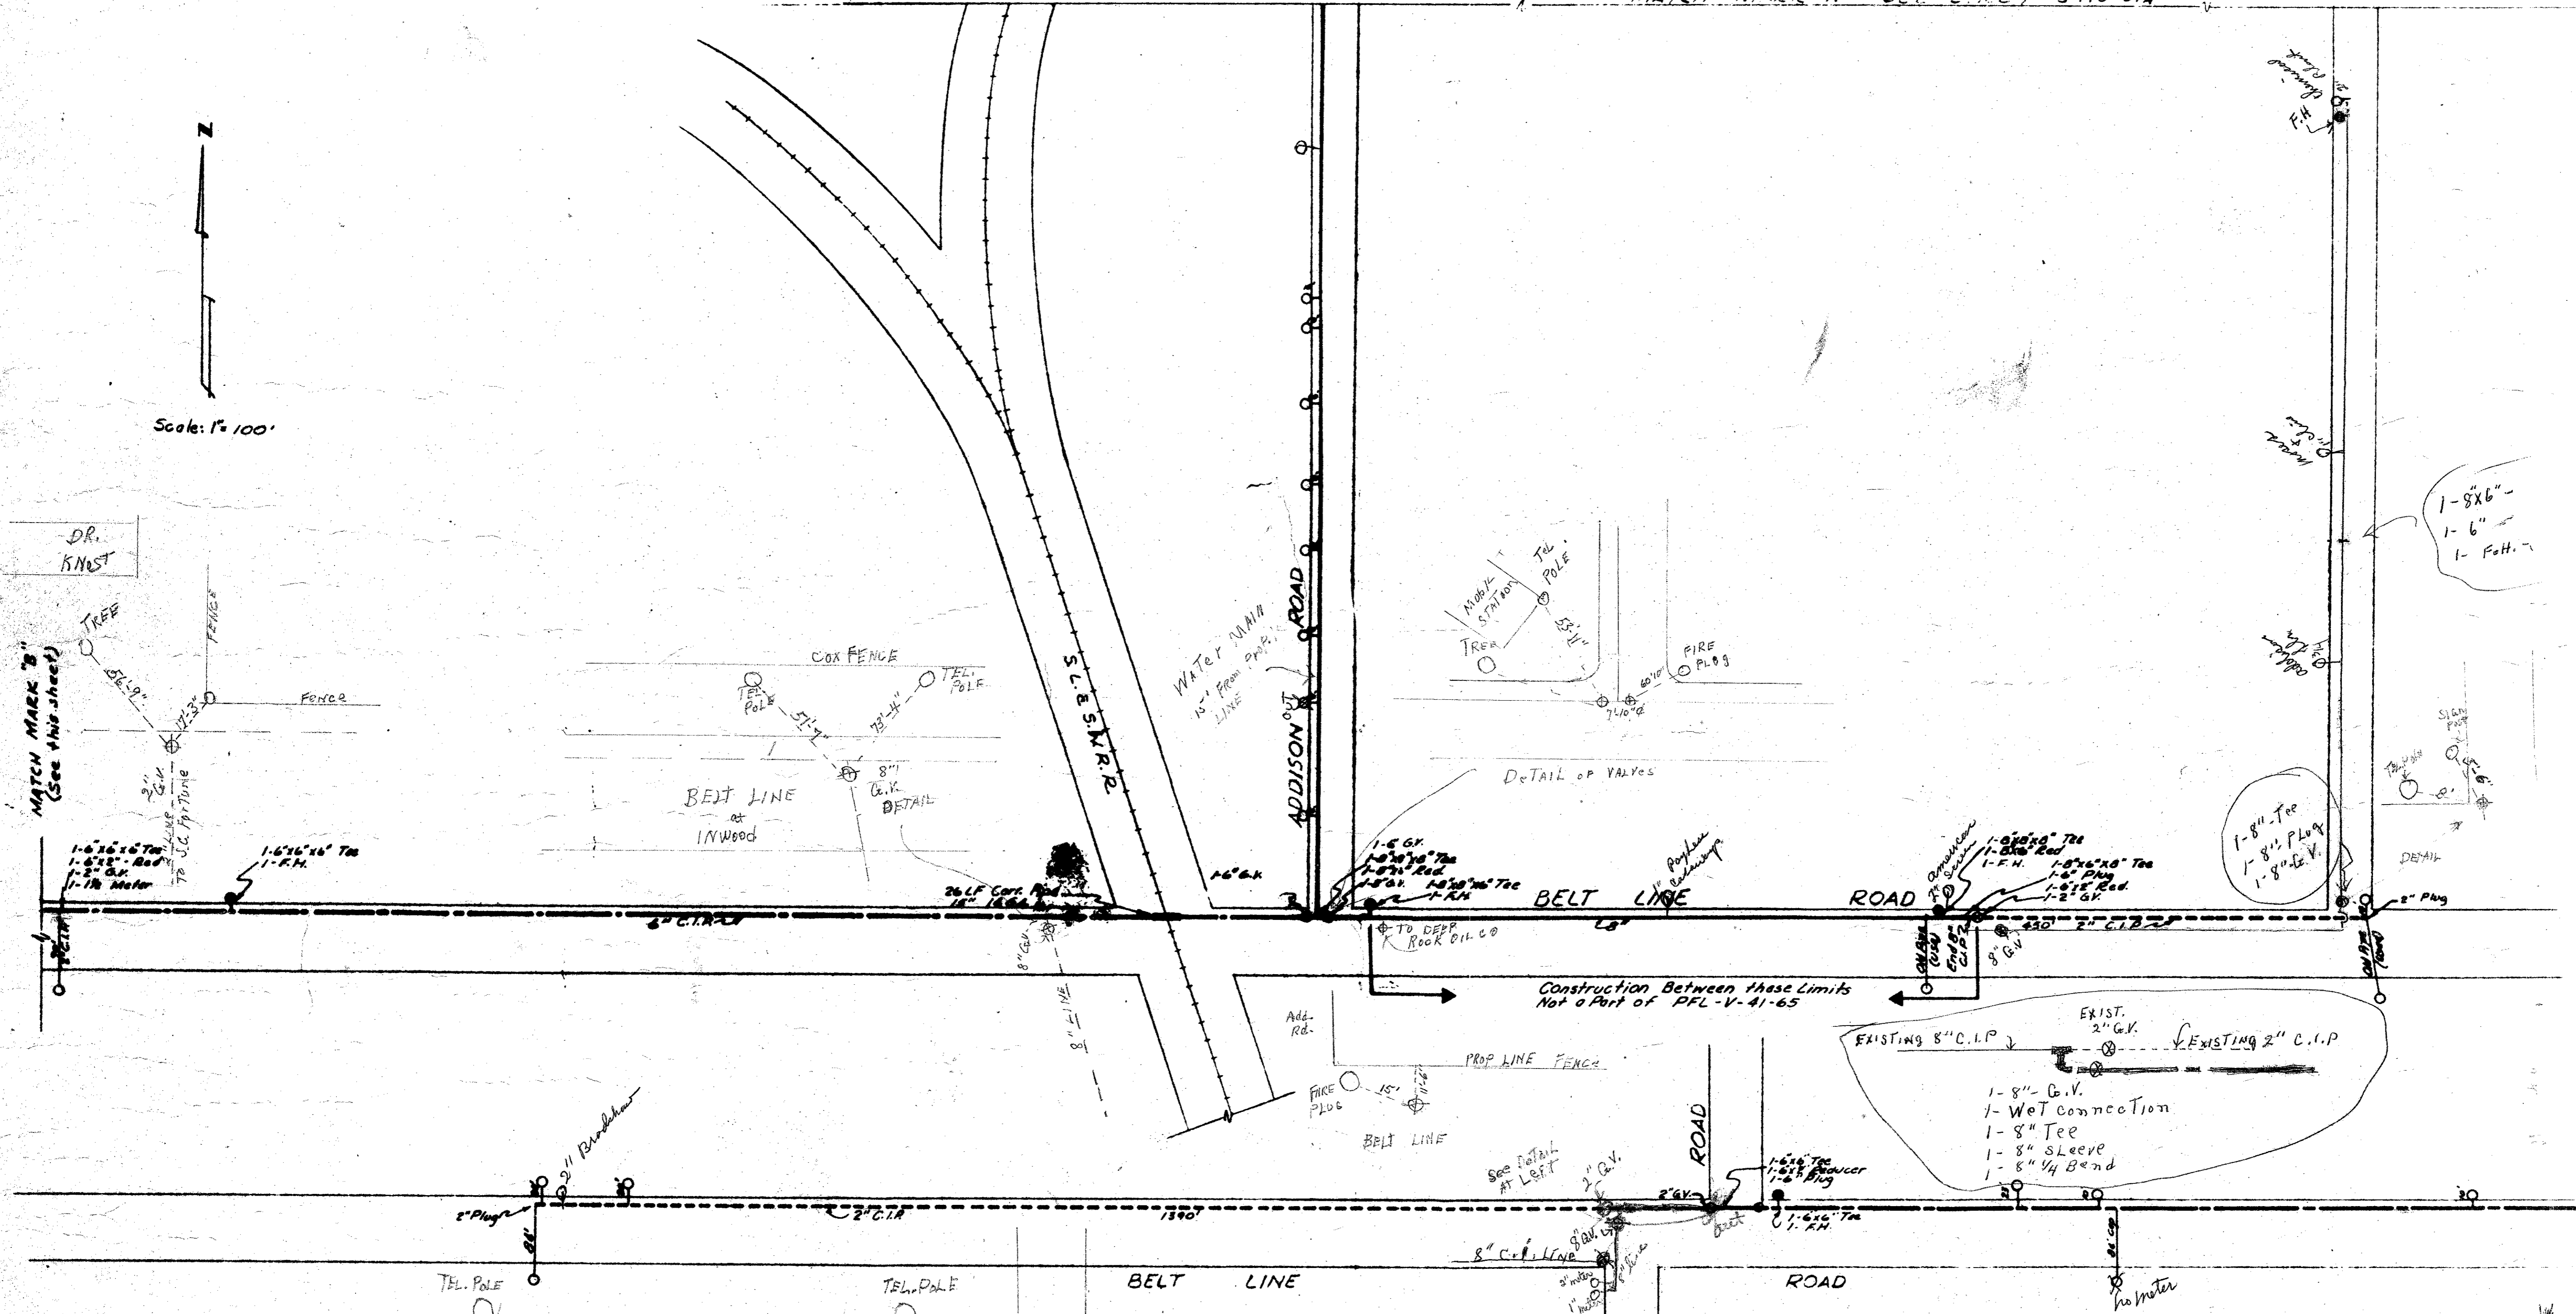


MATCH MARK 'A' SEE SHEET 5710-01A

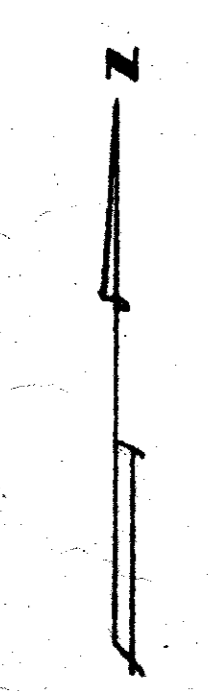

DR. KNST
MATERIAL
MATCH MARK 'B' (See this sheet)

1-8"x6"
1-6"
1-F.H.

EXIST. 8" C.I.P.
EXIST. 2" C.I.P.
1-8" G.V.
1-WeT connection
1-8" Tee
1-8" Sleeve
1-8" 1/4 Band

- LEGEND**
- 8" CAST IRON PIPE
 - 6" CAST IRON PIPE
 - 2" CAST IRON PIPE
 - ⊕ GATE VALVE
 - FIRE HYDRANT
 - COPPER SERVICE & METER & DISTANCE - METER TO MAIN

H.H.F.A. PROJ SHEE
ADDISON
WATER DIST

HOMER A. HUNTER ASS.
CONSULTING ENGINEER
DALLAS, TEXAS

DESIGNED: E.M.R.	APPROVED: H.A.M.
---------------------	---------------------

5710-01 REV JAN 1959