



02312

MATCH MARK 'A' SEE SHEET 5710-01A

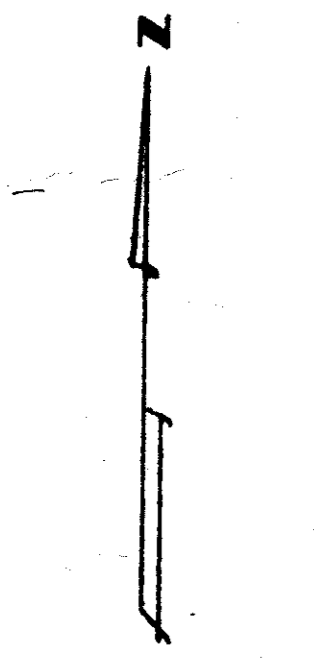

Scale: 1" = 100'

MATCH MARK 'B' (See this sheet)

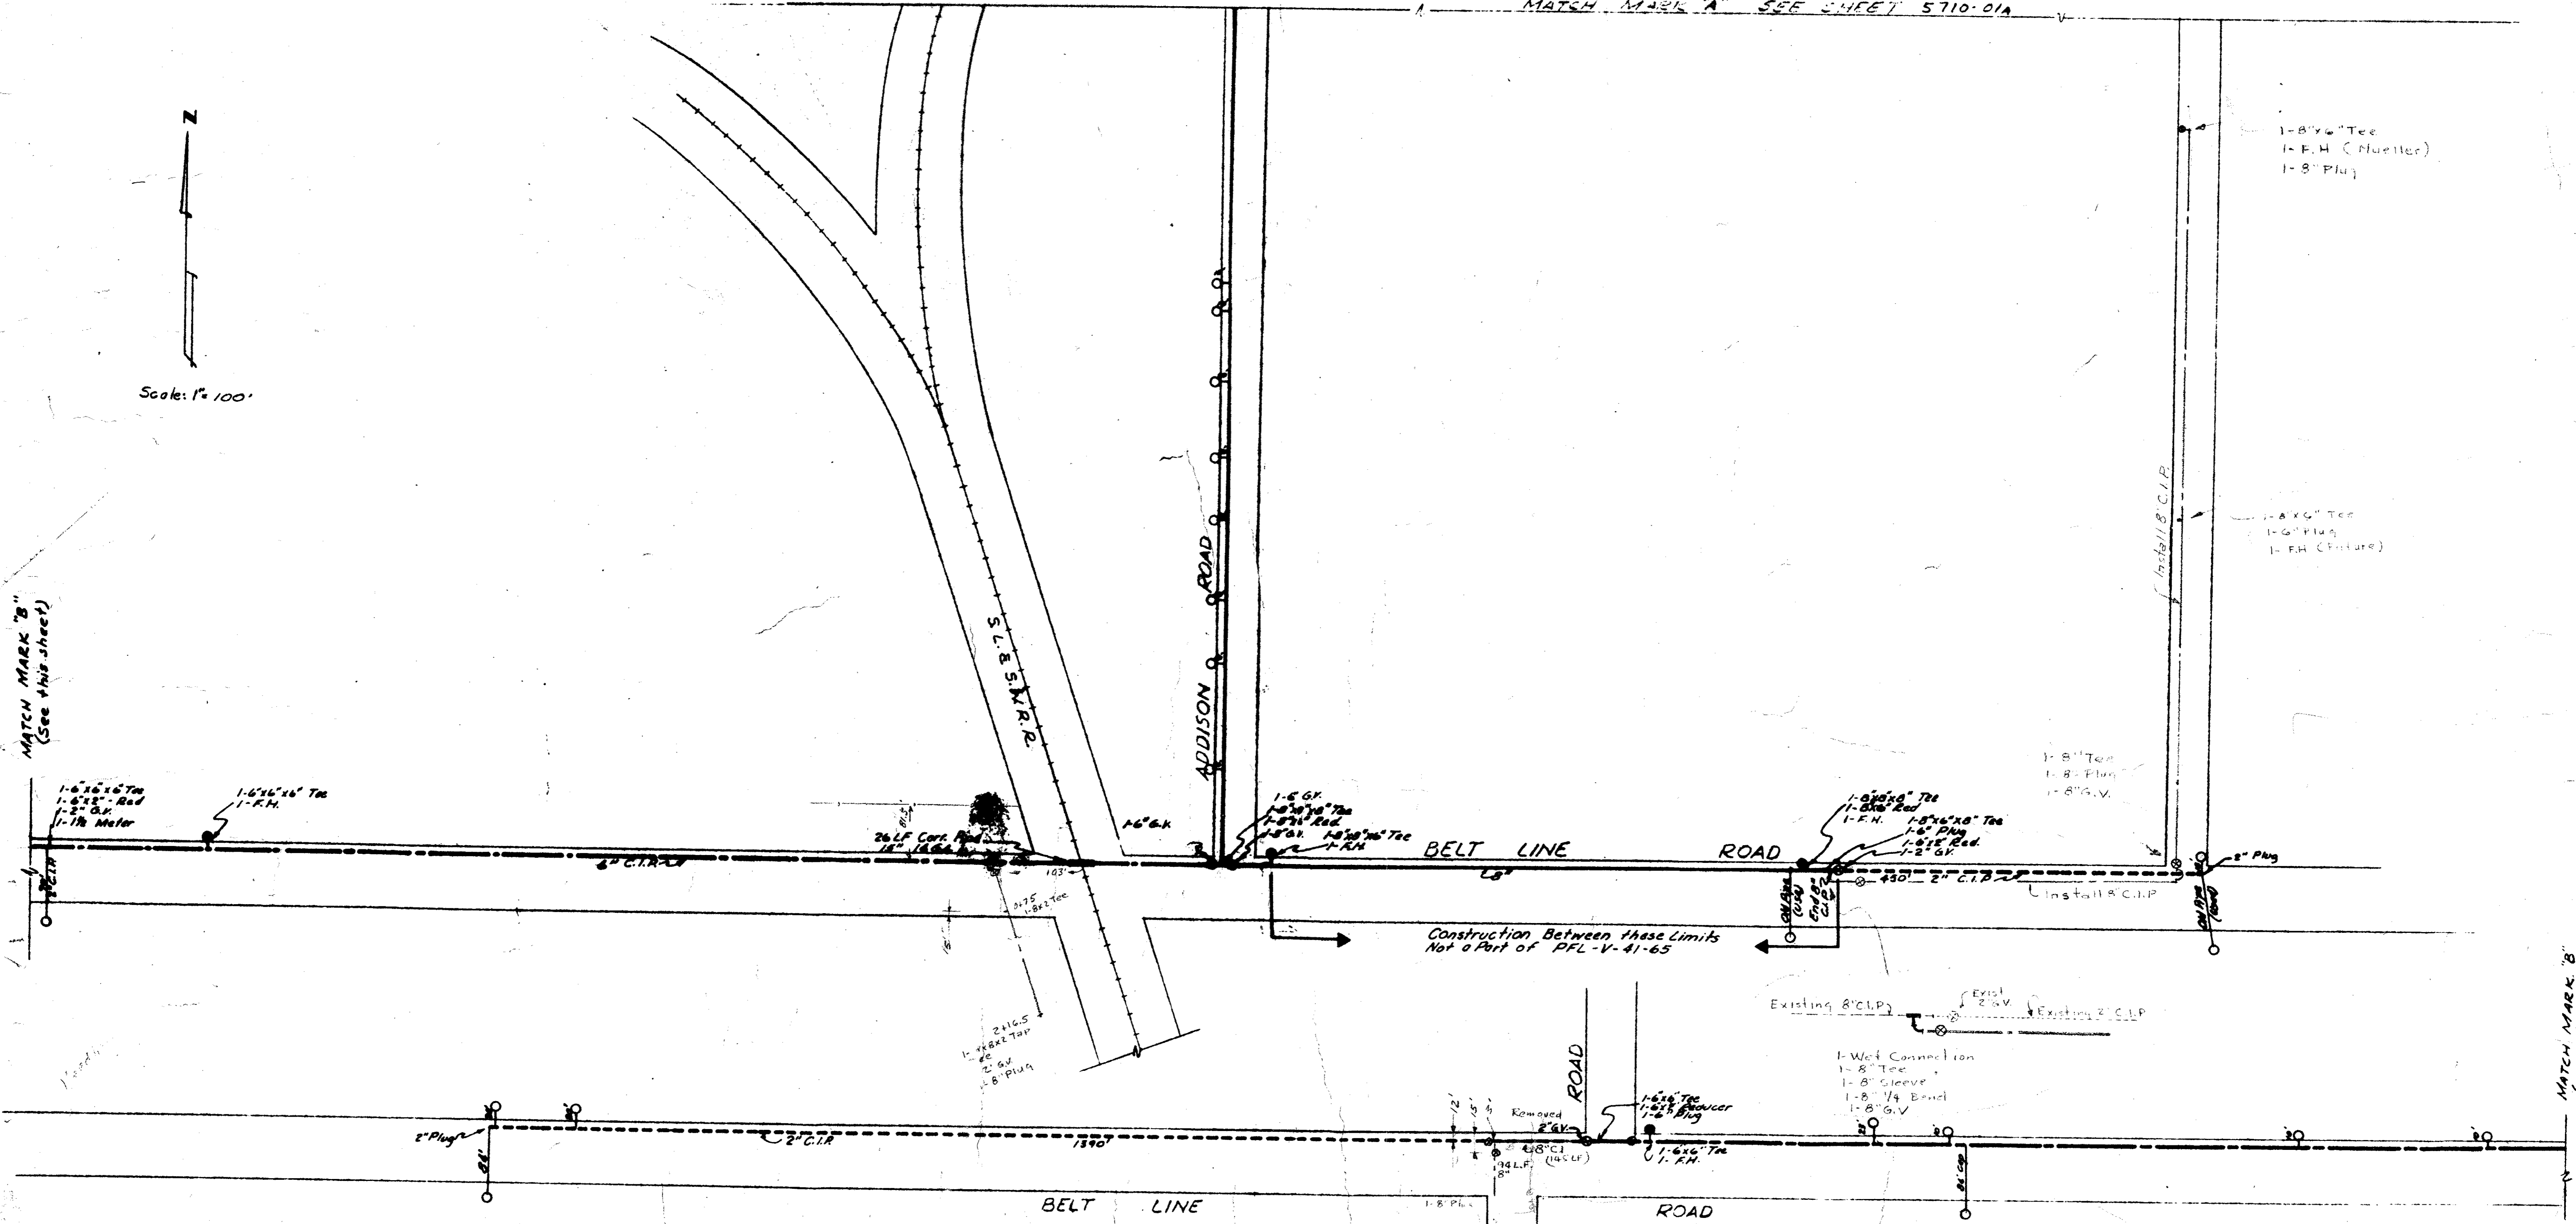

MATCH MARK 'B' (See this sheet)

LEGEND

- 8" CAST IRON PIPE
- - - 6" CAST IRON PIPE
- - - 2" CAST IRON PIPE
- ⊗ GATE VALVE
- FIRE HYDRANT
- ⊕ COPPER SERVICE & METER & DISTANCE - METER TO MAIN

H.H.F.A. PROJECT NO. PFL-V-41-65 SHEET 1B OF 4

ADDISON, TEXAS WATER DISTRIBUTION SYSTEM

HOMER A. HUNTER ASSOCIATES CONSULTING ENGINEERS DALLAS, TEXAS

DESIGNED: E.M.R. APPROVED: H.A.H.

5710-01B REV. JAN. 1969

