


MATCH MARK "A" SEE SHEET 5710-01A

Scale: 1" = 100'

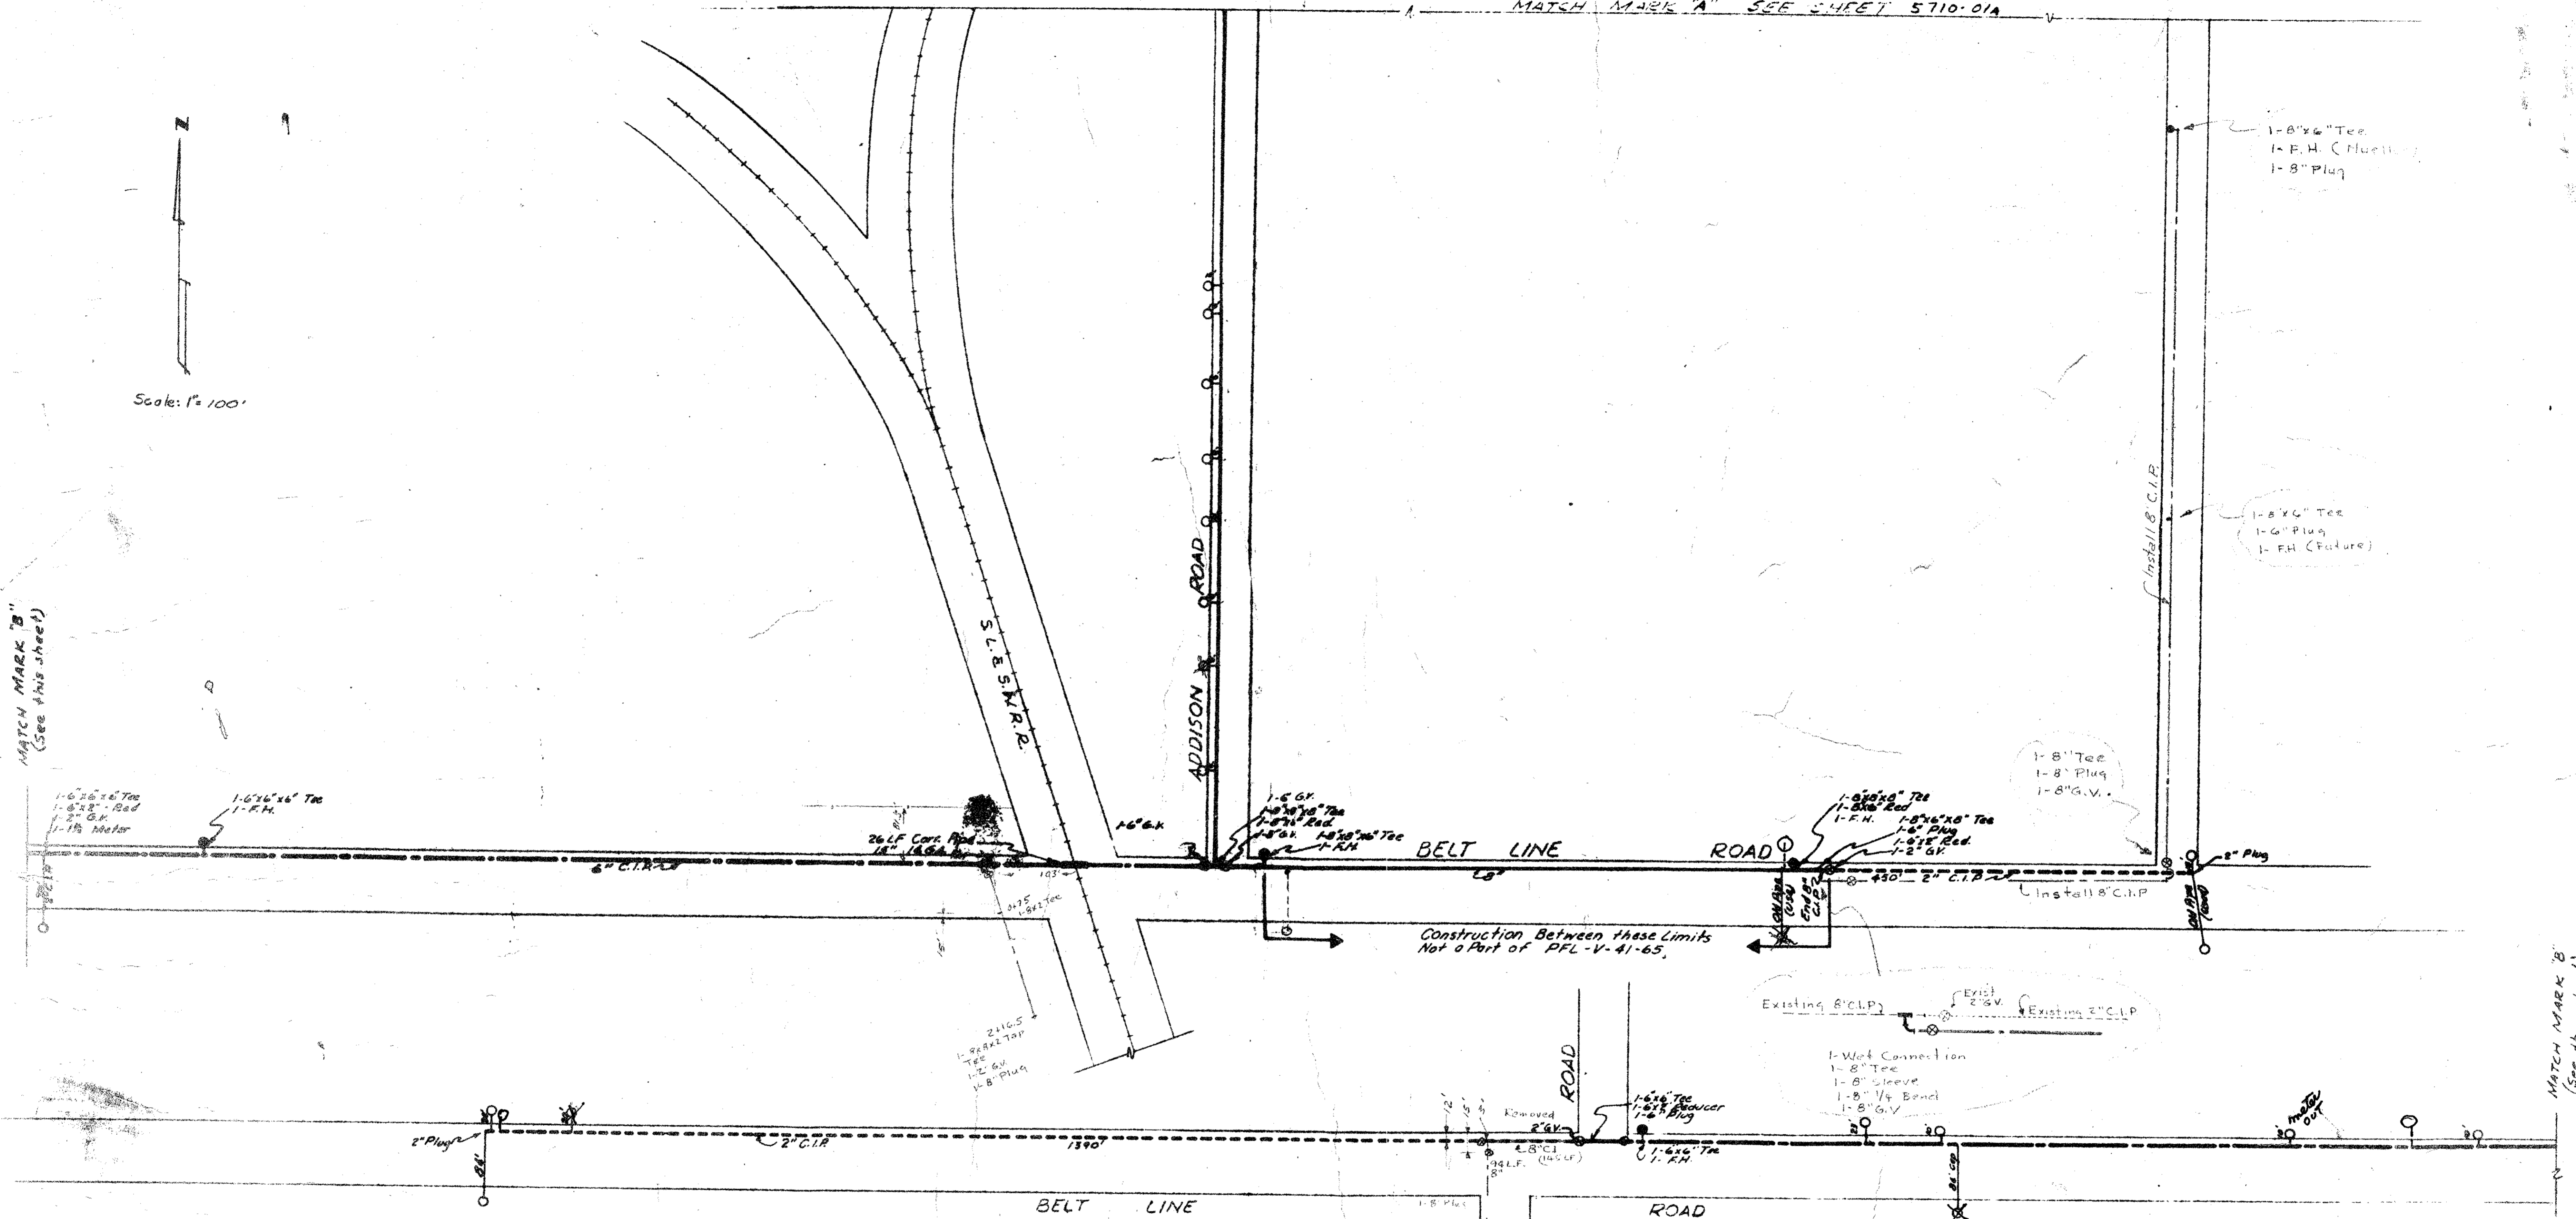

MATCH MARK "B" (See this sheet)

MATCH MARK "B" (See this sheet)

Construction Between these Limits Not a Part of PFL-V-41-65.

LEGEND

- 8" CAST IRON PIPE
- 6" CAST IRON PIPE
- 2" CAST IRON PIPE
- ⊕ GATE VALVE
- FIRE HYDRANT
- ⊙ COPPER SERVICE & METER & DISTANCE - METER TO MAIN

H.H.F.A. PROJECT NO. PFL-V-41-65 SHEET 1B of 4

ADDISON, TEXAS WATER DISTRIBUTION SYSTEM

HOMER A. HUNTER ASSOCIATES CONSULTING ENGINEERS DALLAS, TEXAS

DESIGNED: E.N.R. APPROVED: H.A.H.

5710-01B REV. JAN. 1959



AS BUILT