


JDJR ENGINEERS AND CONSULTANTS
ENGINEERS • LAND PLANNERS • CAD DESIGNERS
P. O. BOX 16437 Irving, Texas 75016-4327
Tel: 972-265-1601 Fax: 972-700-9470

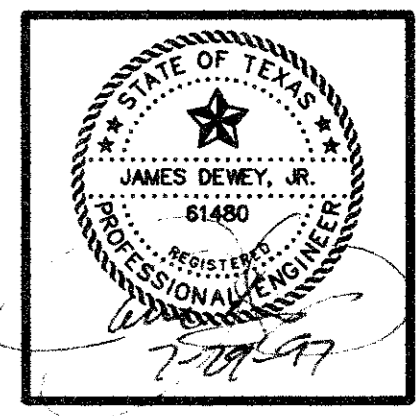

PROJECT:
**A NEW OFFICE BUILDING FOR
NATIONAL TEACHERS ASSOCIATION, INC.**
KELLER SPRINGS ROAD AT QUORUM ROAD
ADDISON, TEXAS

REVISIONS:

DATE	REVISION
6-16-97	CITY COMMENTS
7-29-97	REVISE DET. POND

SHEET TITLE
STORM DRAIN
AND DETENTION
BASIN PLANS

DATE: MAY 16, 1997
SCALE: 1" = 30'
DRAWN BY: SAS (ACAD)
CHECKED BY: JDJ
SHEET NO.
C3 OF 8
JDJR FILE NO. 91-007

BENCH MARK: SQUARE OUT CENTER OF CURB INLET WEST SIDE OF ADDISON ROAD 450' NORTH OF AIRPORT PARKWAY. ELEVATION 639.92
I.B.M. X-CUT SET IN CONCRETE DRIVE APPROACH OF DRIVEWAY 7' WEST AND 25' SOUTH OF THE SOUTHWEST CORNER OF THIS TRACT. ELEVATION 639.65

AS-BUILT