


AS-BUILT

BENCH MARK: SQUARE CUT CENTER OF CURB INLET WEST SIDE OF ADDISON ROAD 450' NORTH OF AIRPORT PARKWAY. ELEVATION 639.92
 T.B.M. X-CUT SET IN CONCRETE DRIVE APPROACH OF DRIVEWAY 7' WEST AND 25' SOUTH OF THE SOUTHWEST CORNER OF THIS TRACT. ELEVATION 639.65

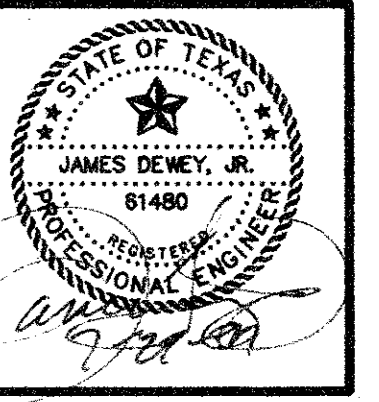

PROJECT:
**A NEW OFFICE BUILDING FOR
 NATIONAL TEACHERS ASSOCIATION, INC.**
 KELLER SPRINGS ROAD AT QUORUM ROAD
 ADDISON, TEXAS

REVISIONS:	
DATE	REVISION
6-16-97	CITY COMMENTS
7-29-97	REVISE DET. POND

SHEET TITLE
**STORM DRAIN
 PROFILES**

DATE: MAY 16, 1997
 SCALE: 1" = 30'
 DRAWN BY: SAS (ACAD)
 CHECKED BY: JDJ

SHEET NO.
C4 of 8
 JDJR FILE NO. 97-007