
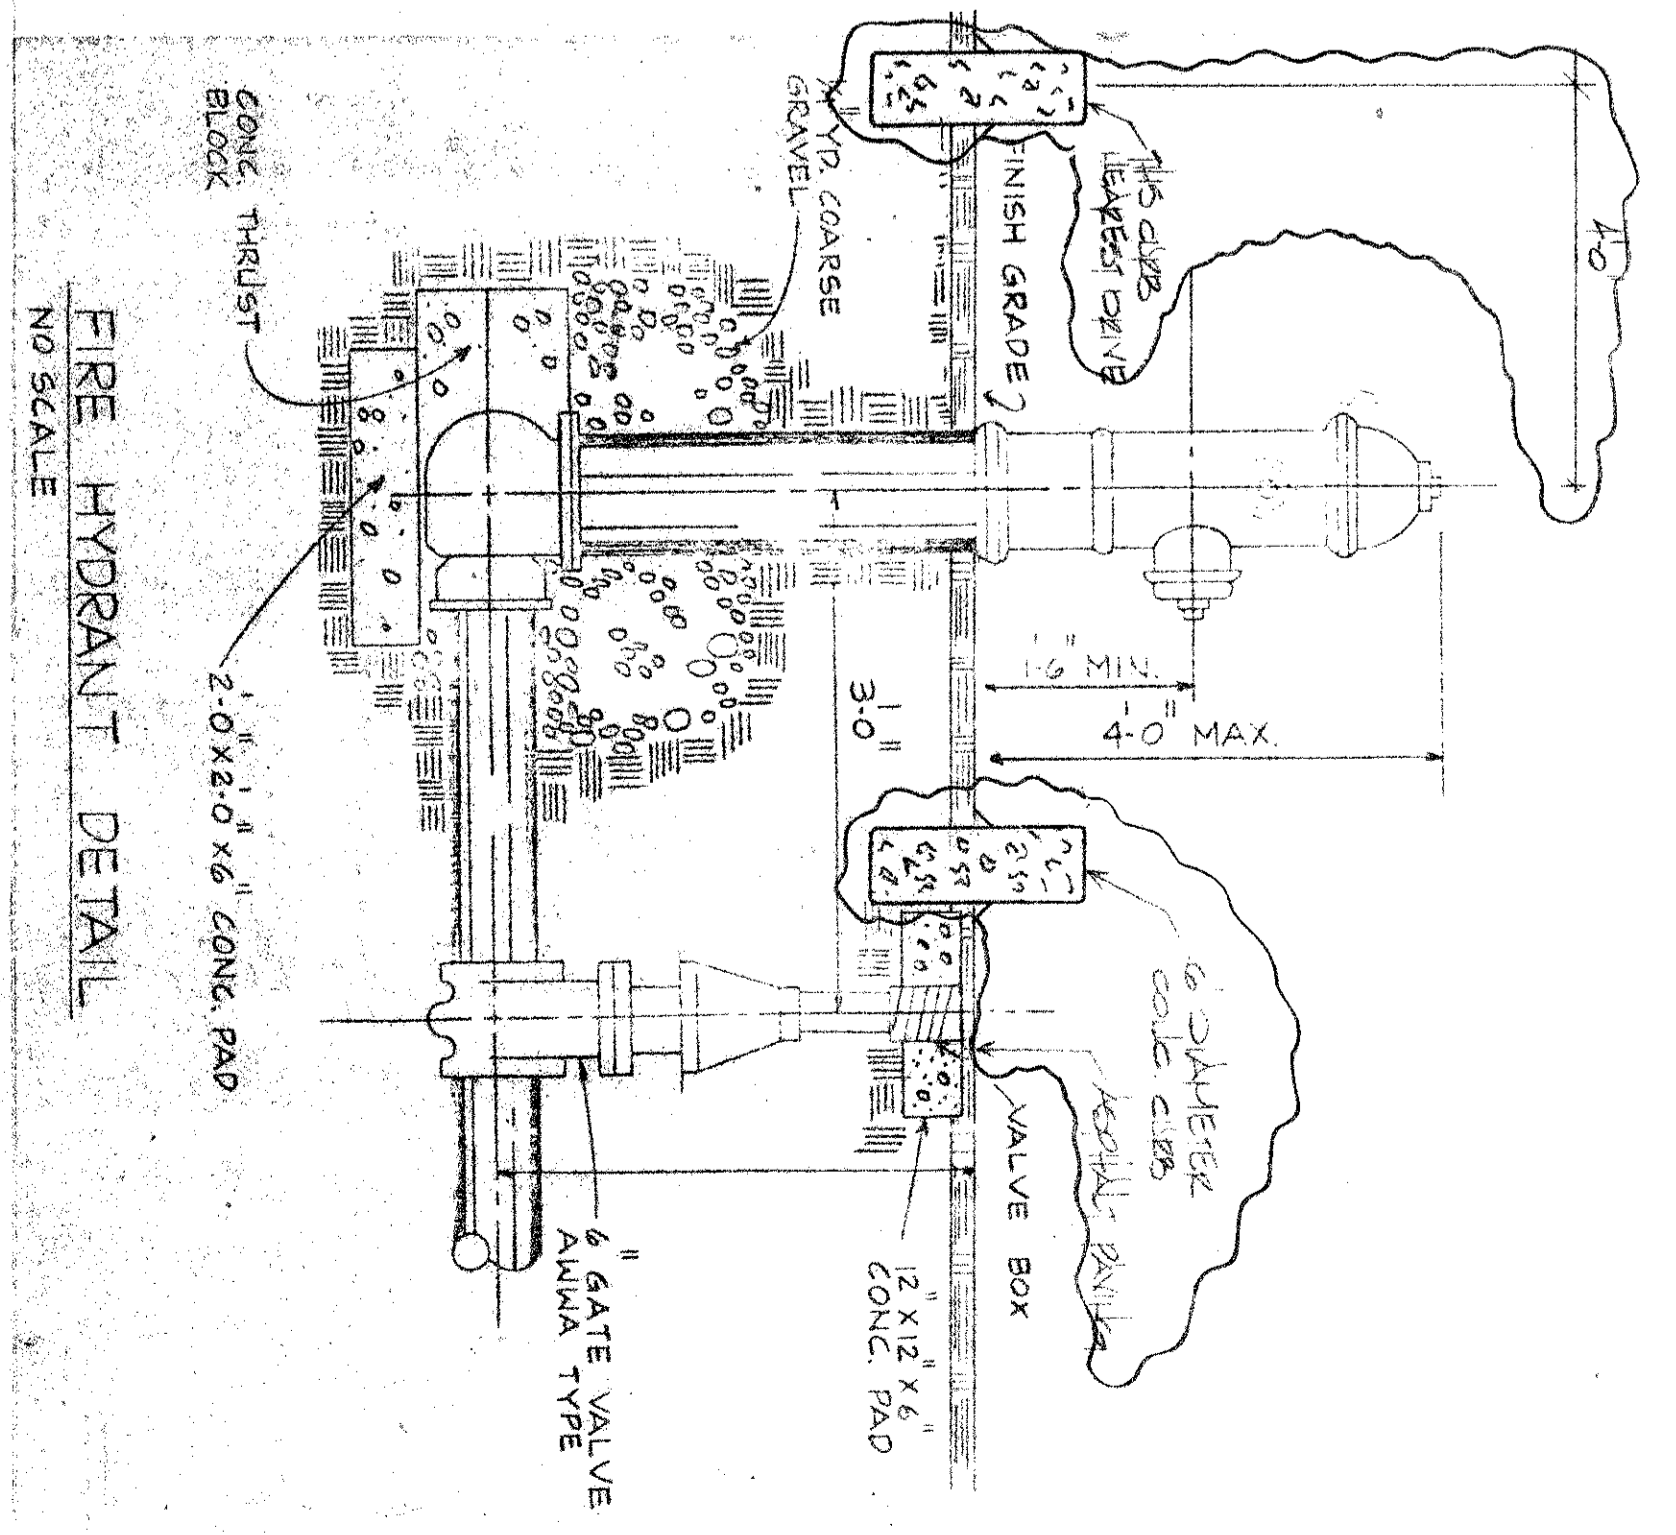
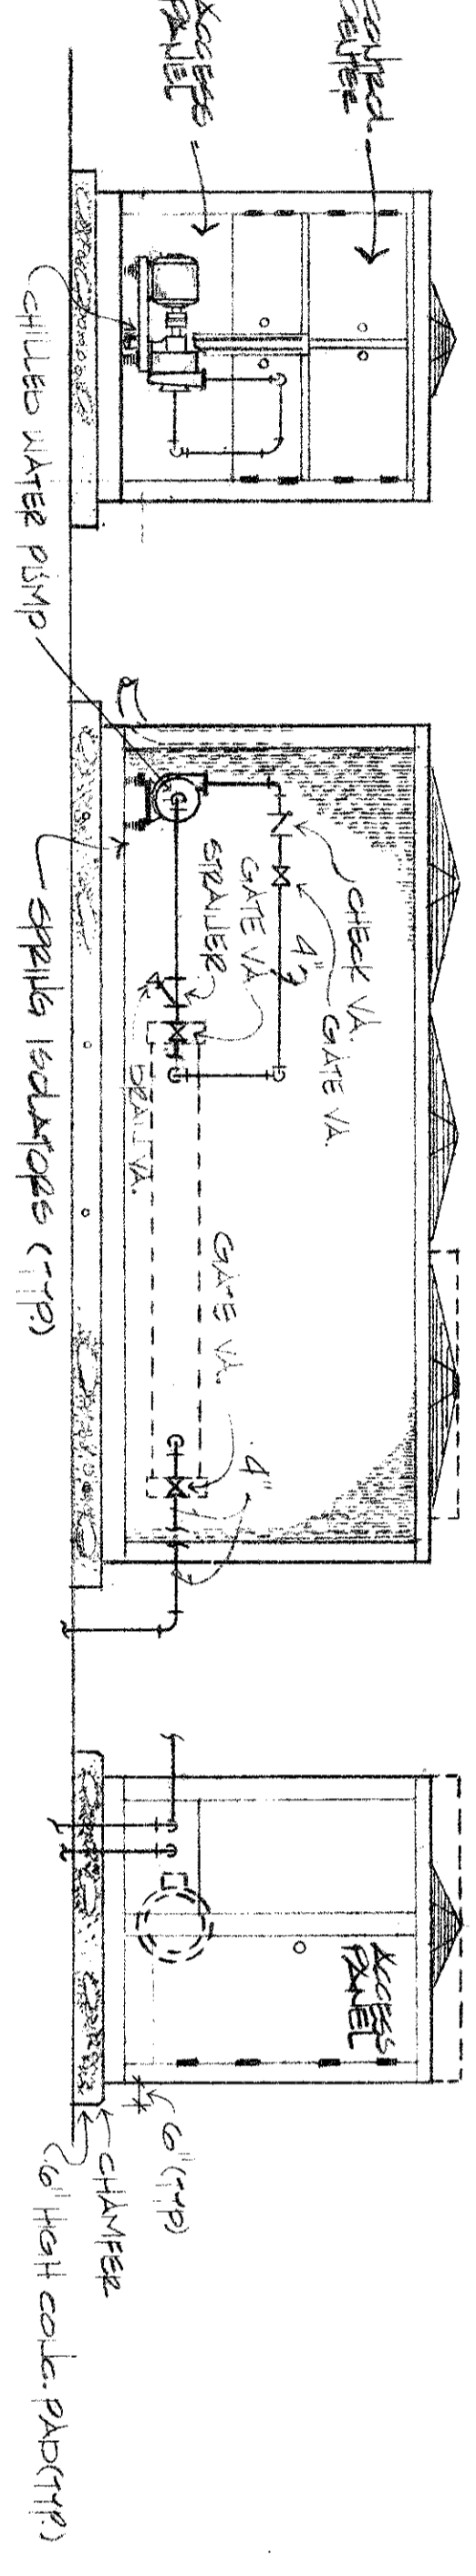


LIGHT FIXTURE SCHEDULE	
AA	STANDARD 4'x4' 2" 48-48-1/2 120-0/3500-4-2-4, BLACK FINISH WITH ALUMINUM LENS
BB	4'x4' 2" 48-48-1/2 120-0/3500-4-2-4, BLACK FINISH WITH ALUMINUM LENS
CC	STANDARD 4'x4' 2" 48-48-1/2 120-0/3500-4-2-4, BLACK FINISH WITH ALUMINUM LENS
DD	STANDARD 4'x4' 2" 48-48-1/2 120-0/3500-4-2-4, BLACK FINISH WITH ALUMINUM LENS
EE	STANDARD 4'x4' 2" 48-48-1/2 120-0/3500-4-2-4, BLACK FINISH WITH ALUMINUM LENS
FF	STANDARD 4'x4' 2" 48-48-1/2 120-0/3500-4-2-4, BLACK FINISH WITH ALUMINUM LENS

- NOTES BY SYMBOL
1. GRID COUNTS OUT AT PROPERTY LINE TO TELEPHONE CO REQUIREMENTS.
 2. UNDERGROUND PRIMARY BY ELECTRIC UTILITY COMPANY, VERIFY EXACT LOCATION.
 3. 2-1/2" PVC FOR TELEPHONE COMPANY.
 4. 0-3/8" CONDUIT, EACH WITH 3500 MCM AND 1-1/2" NEUTRAL.
 5. PAD MOUNTED TRANSFORMER BY ELECTRIC UTILITY CO.
 6. ALL 1/2" HDPE BY ELECTRICAL CODE. ALL 3/4" HDPE BY ELECTRICAL CODE. ALL 1" HDPE BY ELECTRICAL CODE. ALL 1-1/2" HDPE BY ELECTRICAL CODE. ALL 2" HDPE BY ELECTRICAL CODE. ALL 3" HDPE BY ELECTRICAL CODE. ALL 4" HDPE BY ELECTRICAL CODE. ALL 6" HDPE BY ELECTRICAL CODE. ALL 8" HDPE BY ELECTRICAL CODE. ALL 12" HDPE BY ELECTRICAL CODE. ALL 18" HDPE BY ELECTRICAL CODE. ALL 24" HDPE BY ELECTRICAL CODE.
 7. ALL 1/2" HDPE BY ELECTRICAL CODE. ALL 3/4" HDPE BY ELECTRICAL CODE. ALL 1" HDPE BY ELECTRICAL CODE. ALL 1-1/2" HDPE BY ELECTRICAL CODE. ALL 2" HDPE BY ELECTRICAL CODE. ALL 3" HDPE BY ELECTRICAL CODE. ALL 4" HDPE BY ELECTRICAL CODE. ALL 6" HDPE BY ELECTRICAL CODE. ALL 8" HDPE BY ELECTRICAL CODE. ALL 12" HDPE BY ELECTRICAL CODE. ALL 18" HDPE BY ELECTRICAL CODE. ALL 24" HDPE BY ELECTRICAL CODE.

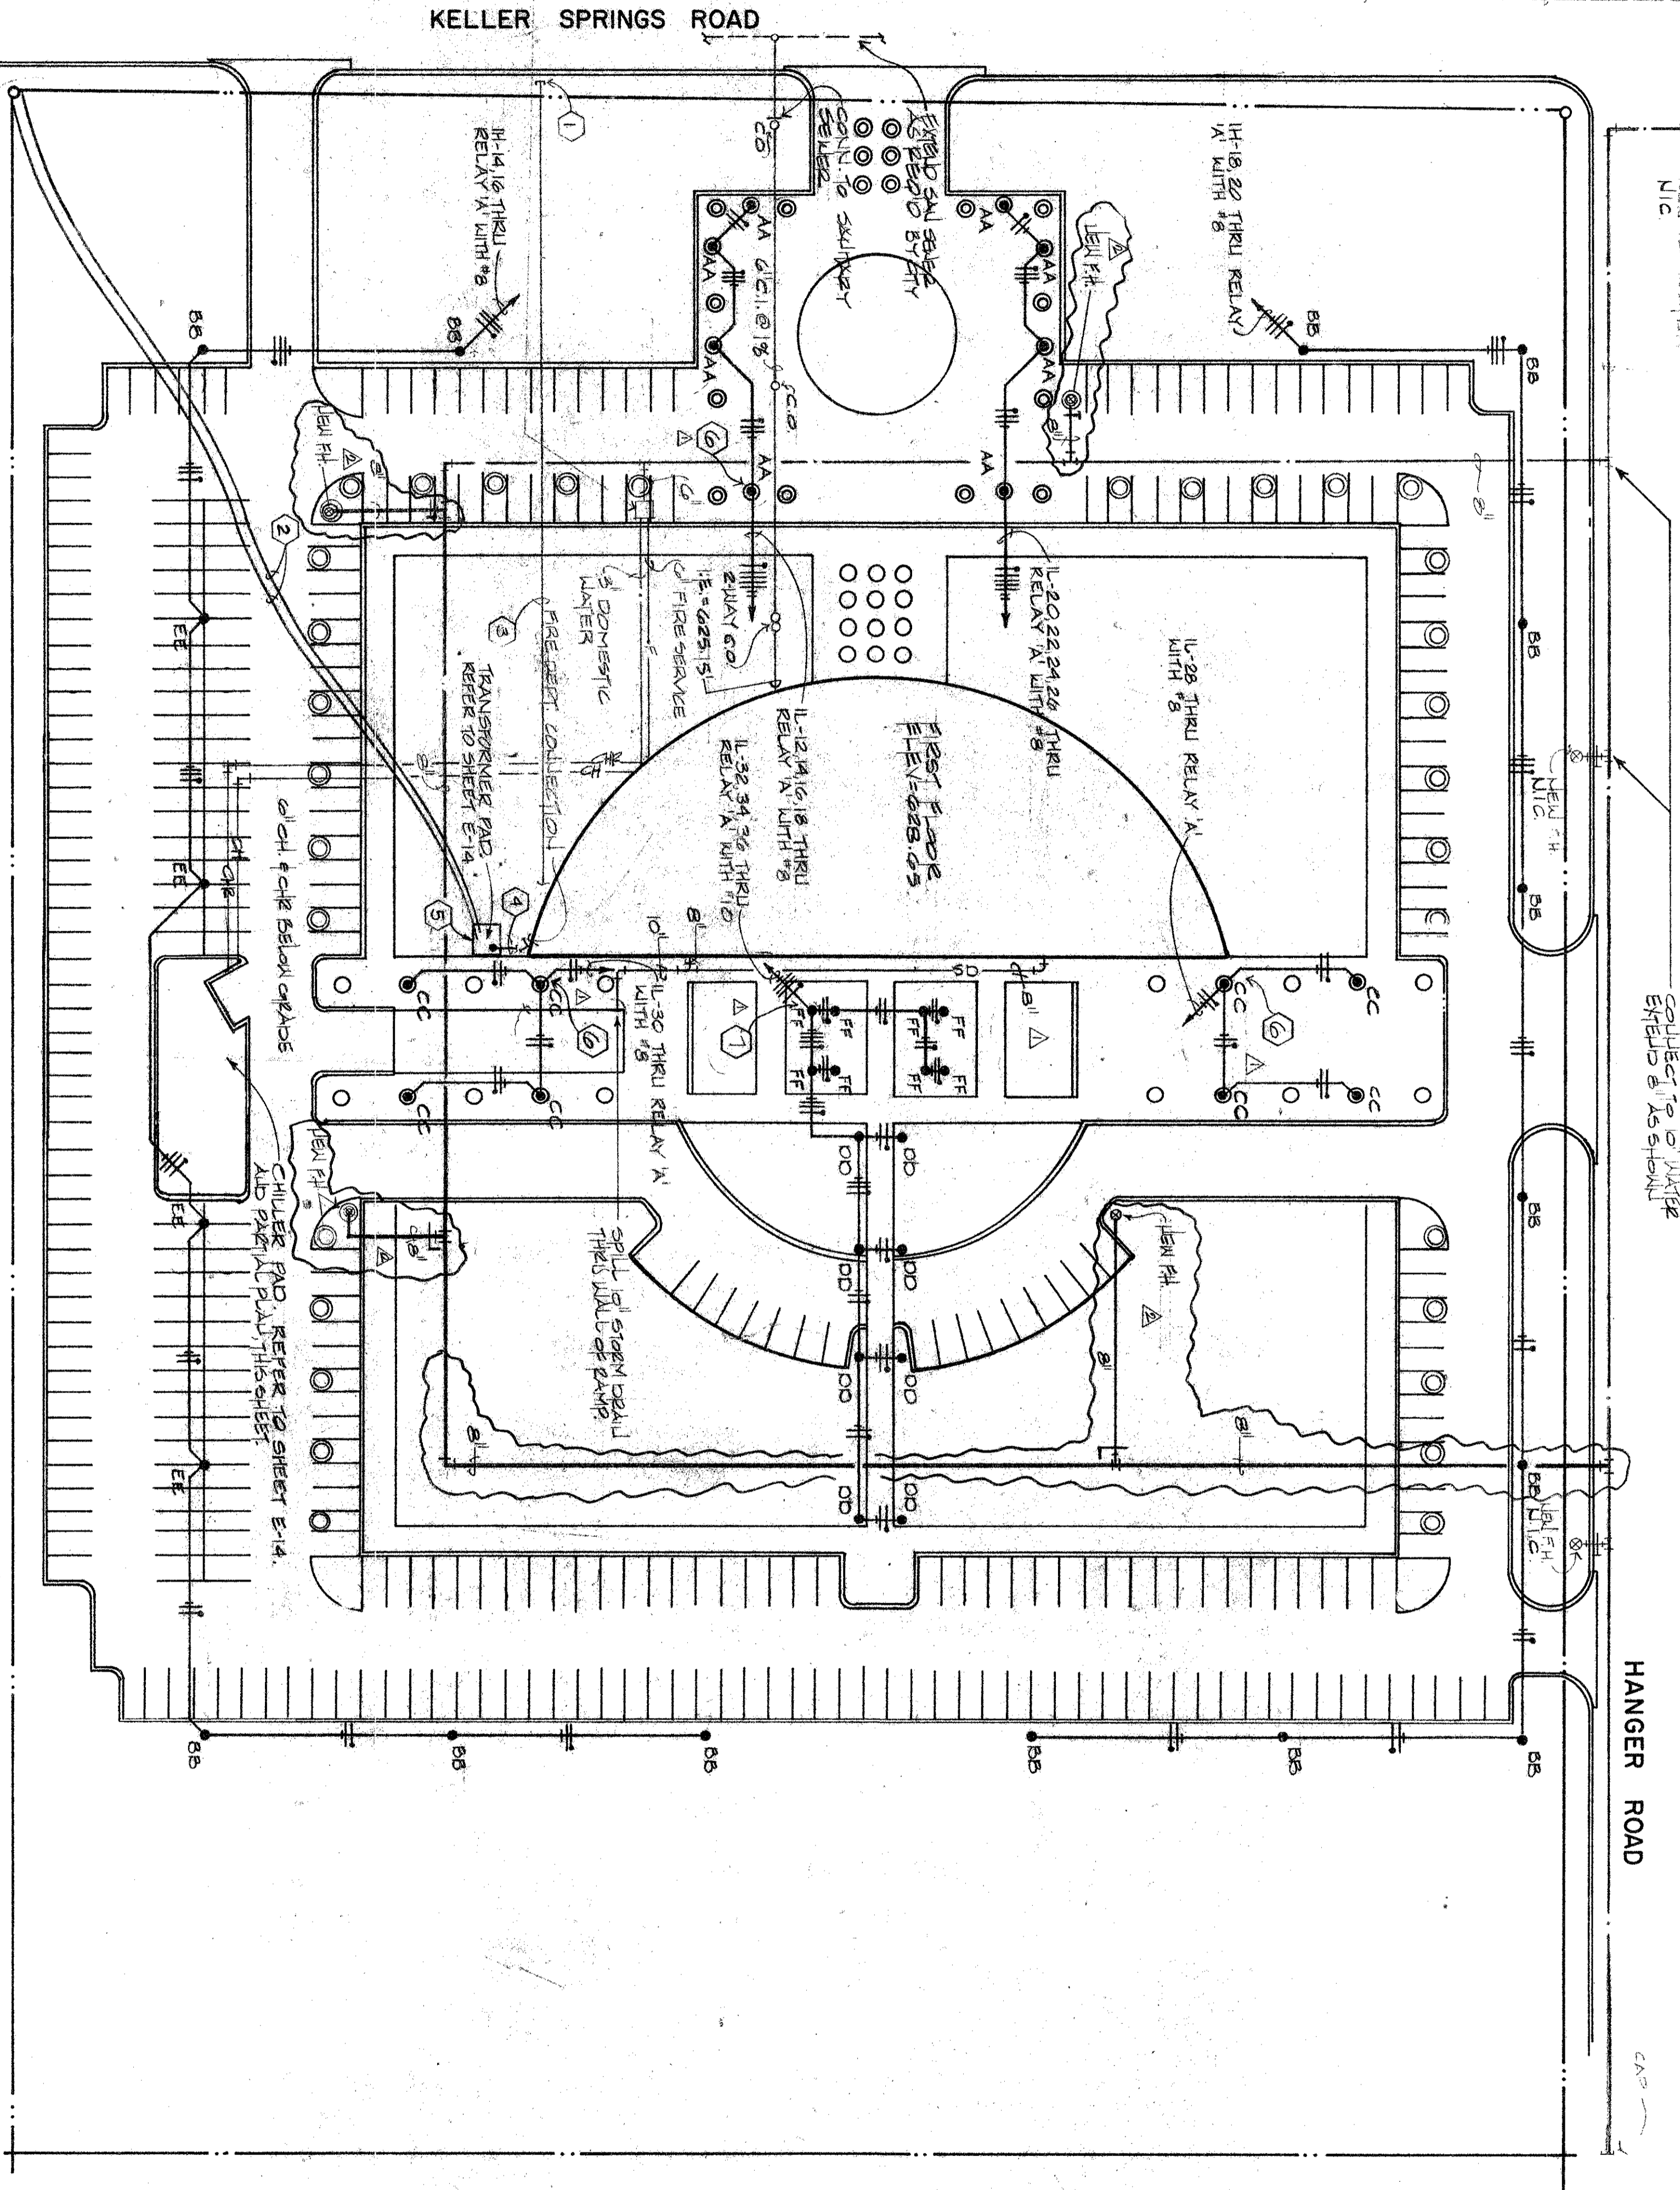

MECHANICAL SYMBOLS LEGEND	
SYMBOL	DESCRIPTION
(Symbol)	COLD WATER
(Symbol)	DOMESTIC HOT WATER
(Symbol)	HEATING WATER SUPPLY
(Symbol)	HEATING WATER RETURN
(Symbol)	CHILLED WATER SUPPLY
(Symbol)	CHILLED WATER RETURN
(Symbol)	CONDENSER WATER SUPPLY
(Symbol)	CONDENSER WATER RETURN
(Symbol)	REFRIGERANT LIQUID
(Symbol)	REFRIGERANT VAPOR
(Symbol)	WASTE
(Symbol)	VENT
(Symbol)	STAINLESS STEEL
(Symbol)	STEEL
(Symbol)	INSULATED CONDENSATE RETURN
(Symbol)	FLUE GAS
(Symbol)	COMBUSTIBLE FIBER
(Symbol)	PIPE
(Symbol)	VALVE
(Symbol)	FLANGE
(Symbol)	UNION
(Symbol)	TELESCOPE
(Symbol)	WALL MOUNT
(Symbol)	BOX MOUNT
(Symbol)	ROOM MOUNT
(Symbol)	ROOF MOUNT
(Symbol)	VENT FAN ROOF
(Symbol)	CLEAR OUT

SITE PLAN
SCALE 1/8"=1'-0"

CHILLER & PUMP DETAIL
SCALE 1/8"=1'-0"

PARTIAL PLAN - MECHANICAL CHILLERS
SCALE 1/8"=1'-0"