
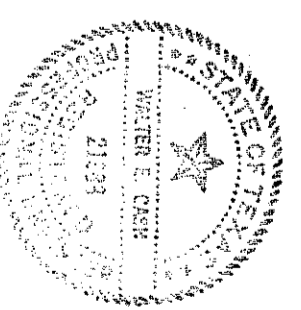


SITE PLAN - FIRE LOOP

SCALE 1" = 40'-0"

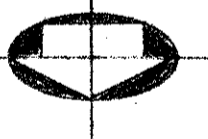

REV. NO.	DATE	DESCRIPTION	BY

JOB NAME	LIBERTY CORPORATION
DESCRIPTION	SITE PLAN - FIRE LOOP
DESIGNER	AS SHOWN
DATE	4/14/81
JOB NO.	8005
DRWG. NO.	F-1

<b>NM</b> NATIONAL MECHANICAL CORPORATION	P. O. Box 402326 Dallas, TX 75240 (214) 386-8200
---	--