

01 GRADING PLAN
SCALE 1/4" = 1'-0"
H

02 SECTION - EASTERN DITCH
SCALE 1/4" = 1'-0"

03 CONTROL JOINT PAVEMENTS
SCALE 1/2" = 1'-0"






04 EXPANSION JOINT PAVERS
SCALE 1/2" = 1'-0"

05 SECTION - CONCRETE PAVING
SCALE 1/2" = 1'-0"

06 LIGHT FIXTURE BB & CLUBS
SCALE 1/2" = 1'-0"

07 LIGHT FIXTURE AA & PLANTED ISLAND
SCALE 1/2" = 1'-0"


08 LIGHT FIXTURE CC @ PARKING
SCALE 1/2" = 1'-0"

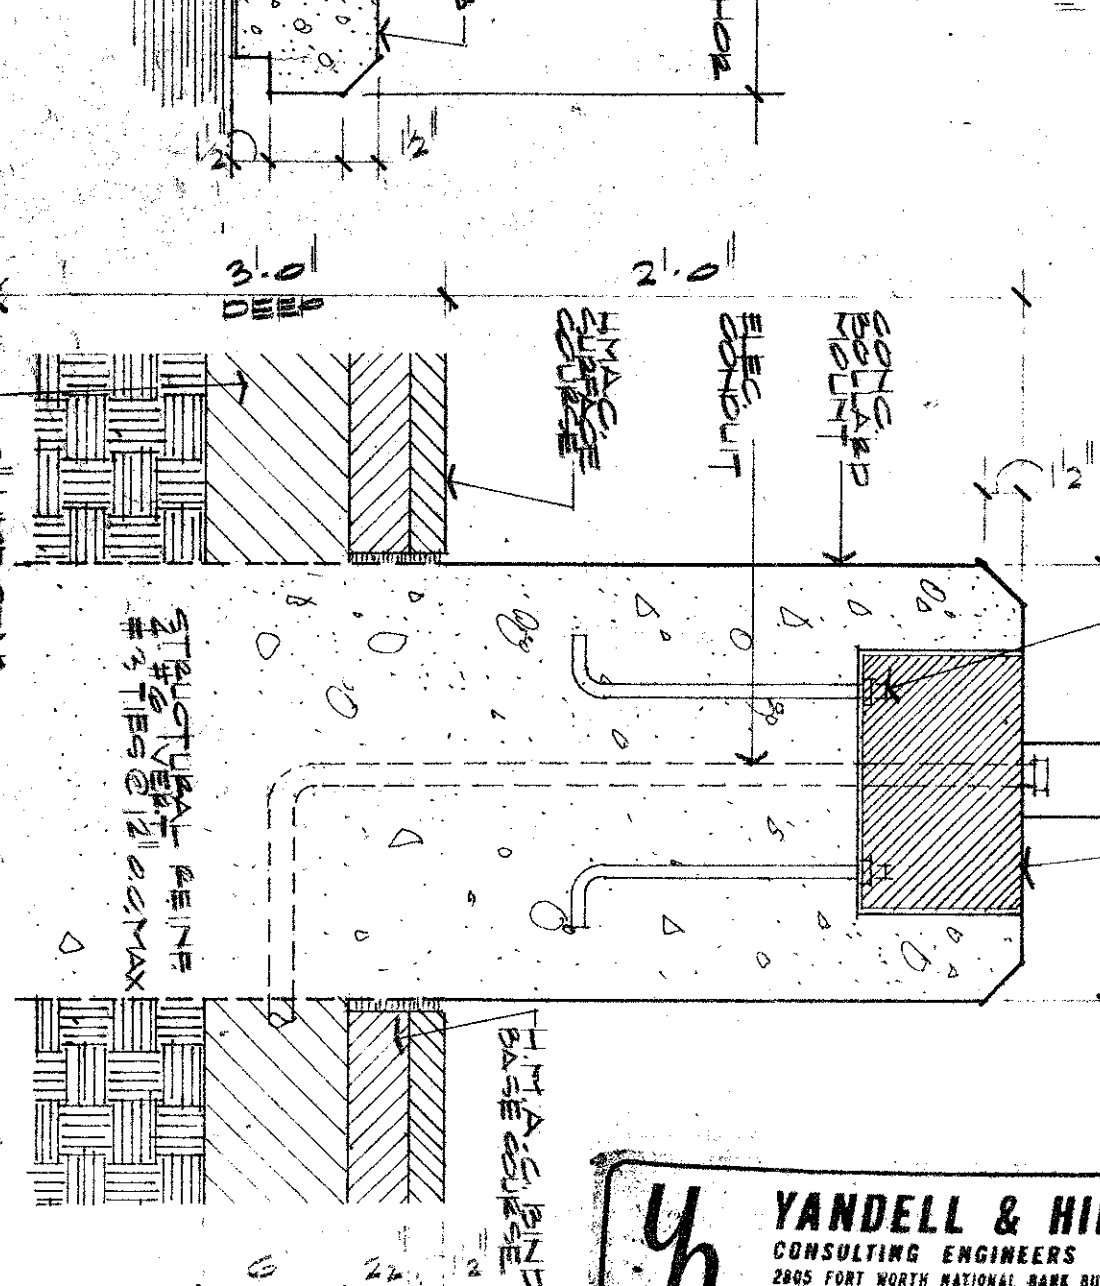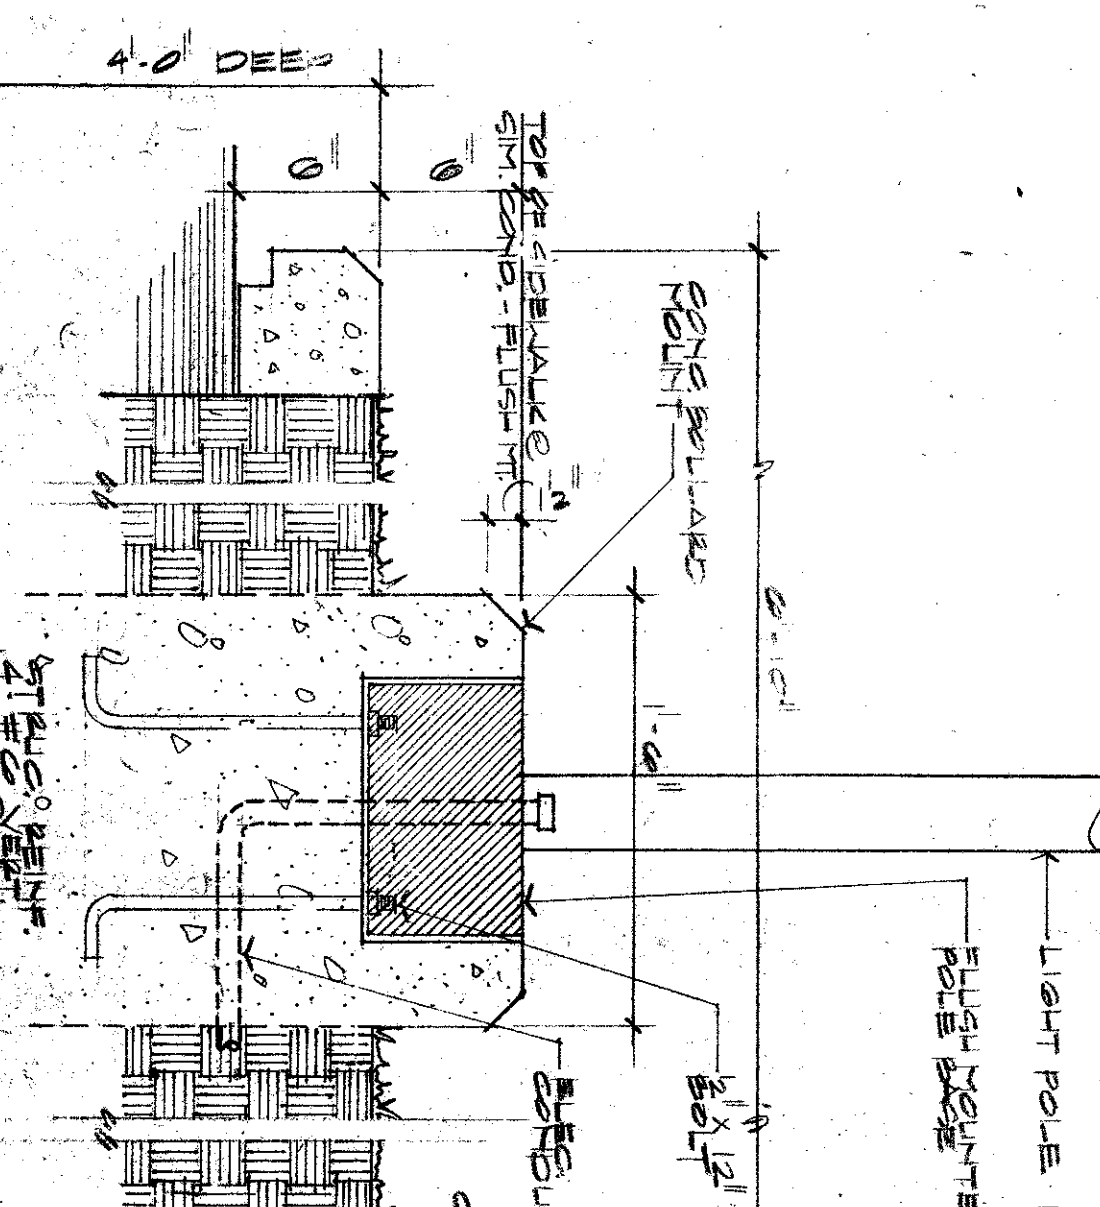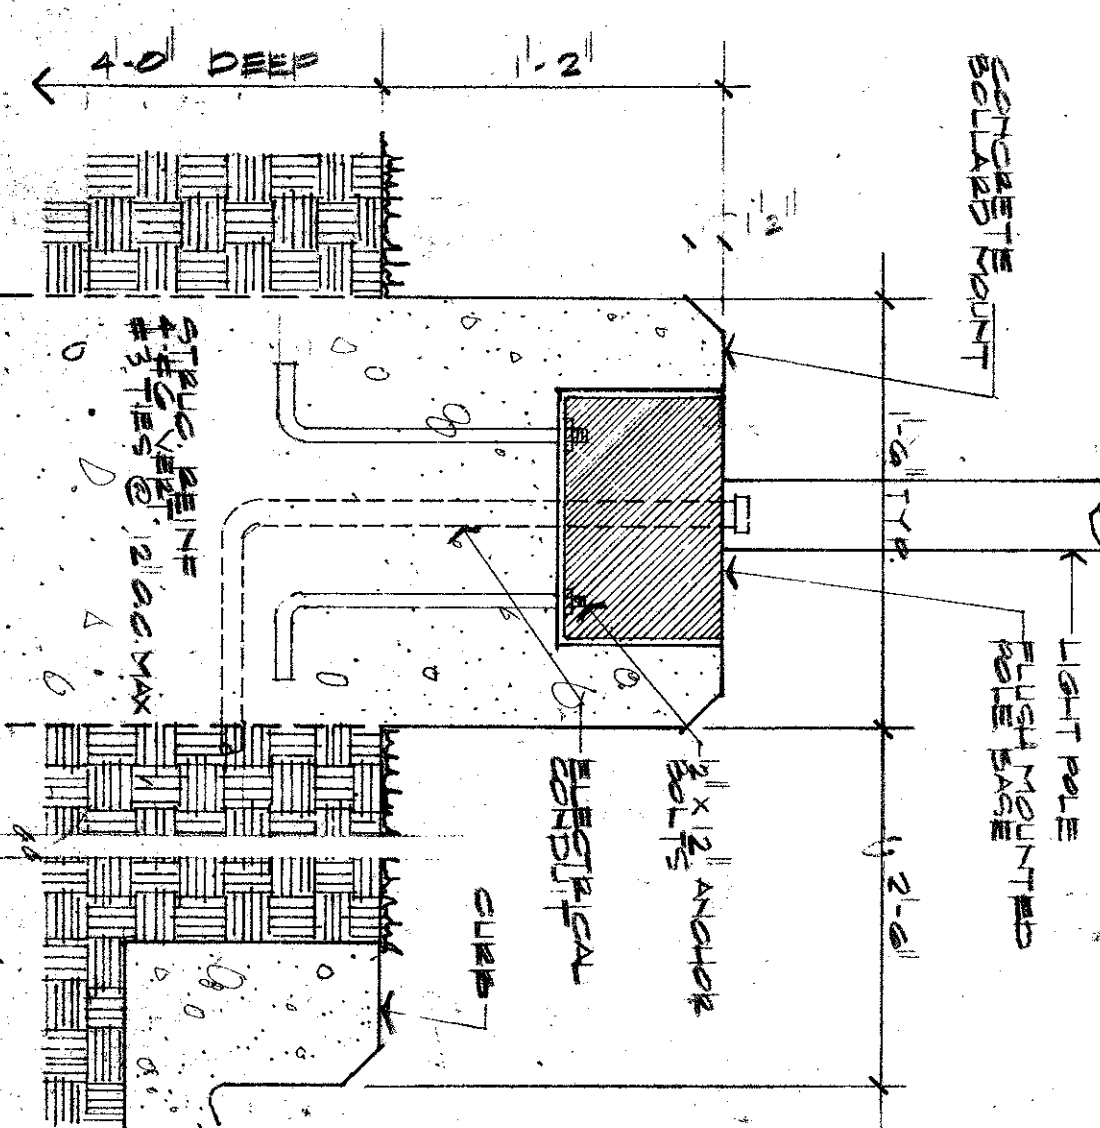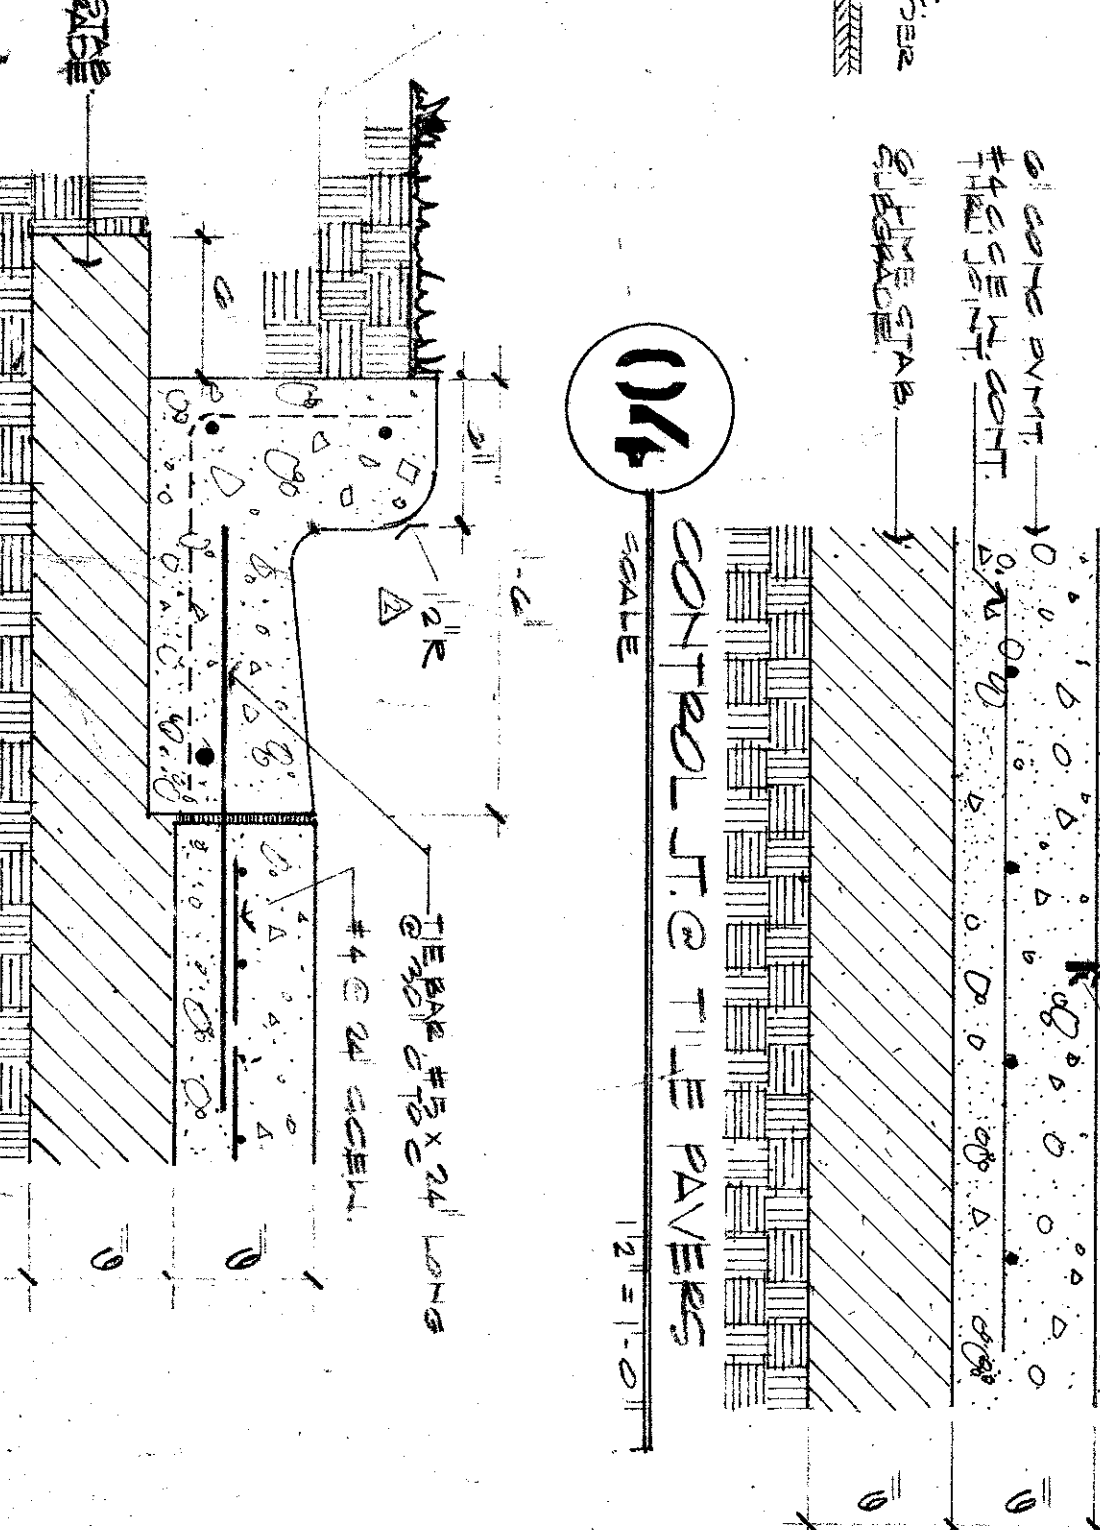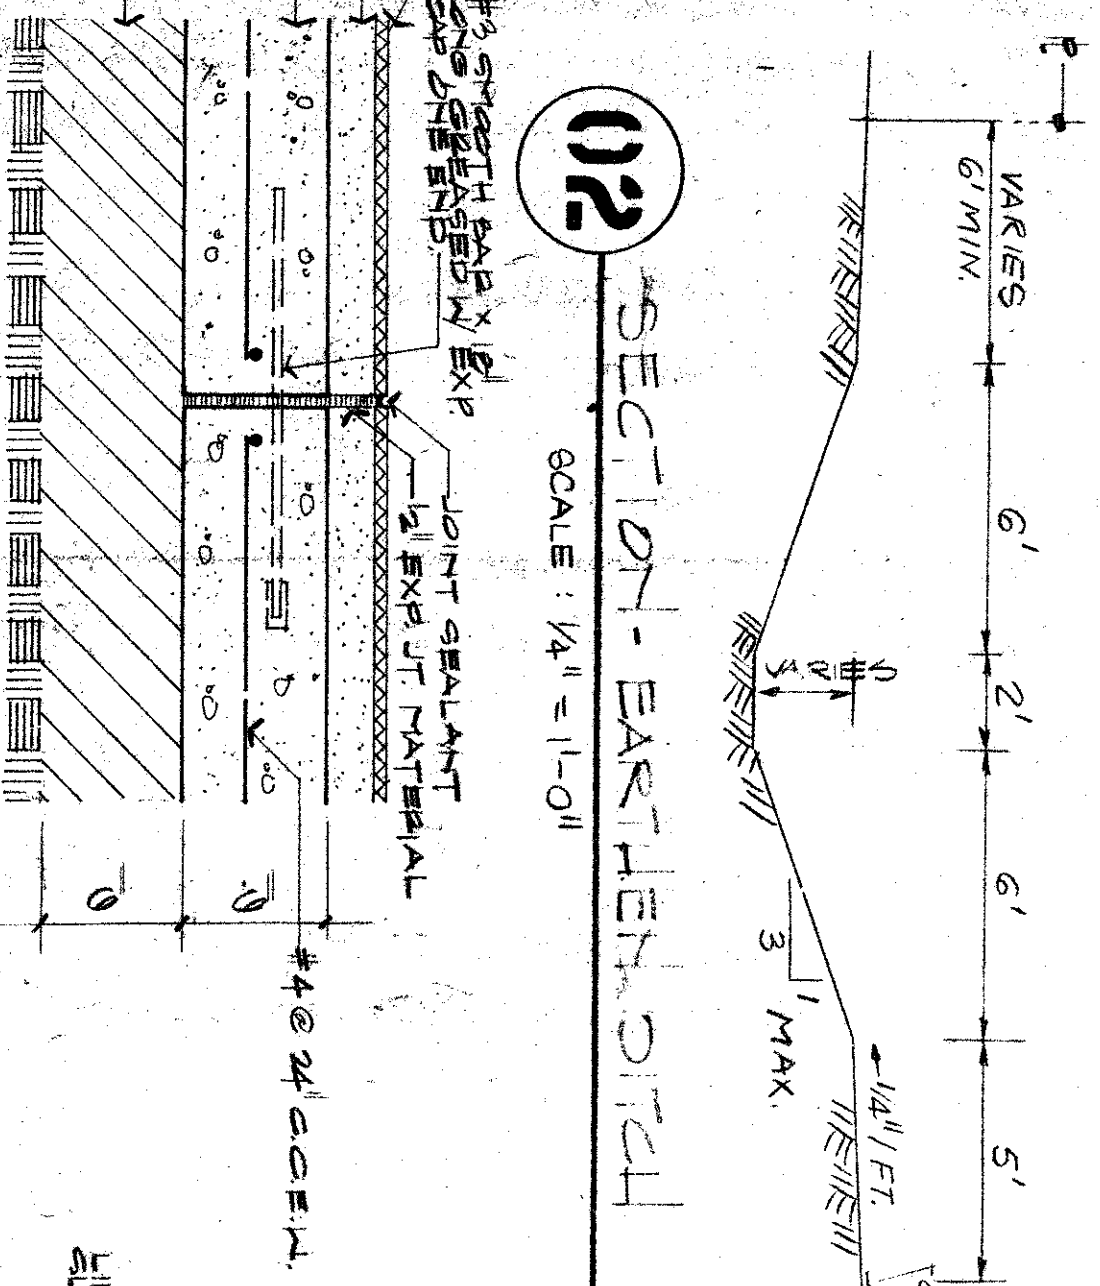

YANDELL & HILLER, INC.
CONSULTING ENGINEERS
2900 SOUTHLAND CENTER DALLAS TEXAS 75201
PORT WORTH, TEXAS 1802 817-333-3000

Liberty Corporation - Phase I
United Fidelity Insurance Company Home Office Building
Keller Springs Road Addison, Texas

Harwood K Smith & Partners Inc
Architects Engineers Planners 2900 Southland Center Dallas Texas 75201
Harwood K Smith
George R Richie Ronald M Brame Paul M Terrill Jr
John M Bane Jack R Yardley Ronald L Skaggs
J Wade Driver Jr C Joe Buskuhl Jack M Nottingham

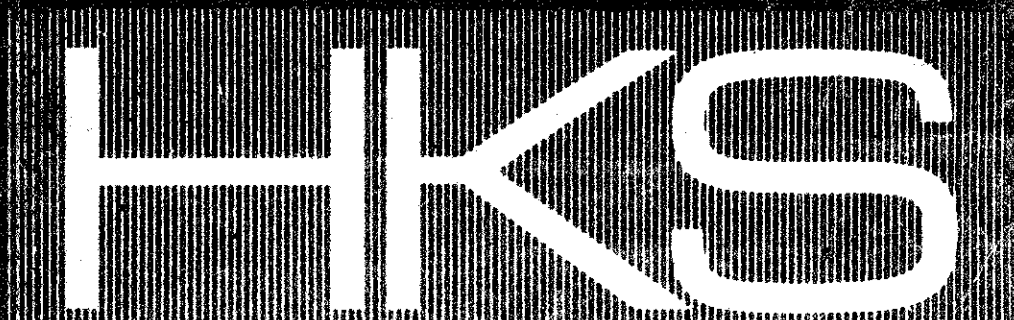

OF SHEETS **A1.02**

NO.	DATE	BY	REVISIONS
1	5-11-80		REVISED TO ADD
2	7-22-80		REVISED TO ADD
3	11-21-80		REVISED TO ADD

HKS JOB # 2895
DATE PLOT 11-20
SHEET NUMBER