
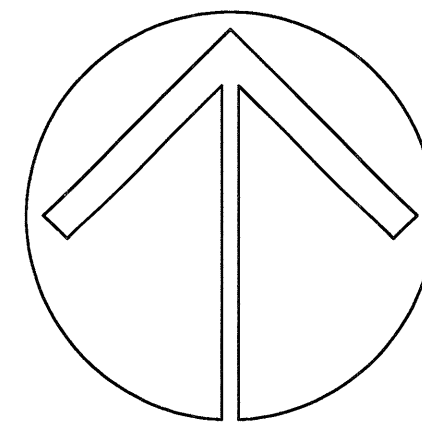


10-17-2011


REVISIONS

KELLER SPRINGS LOFTS

LOFT APARTMENTS IN ADDISON, TEXAS

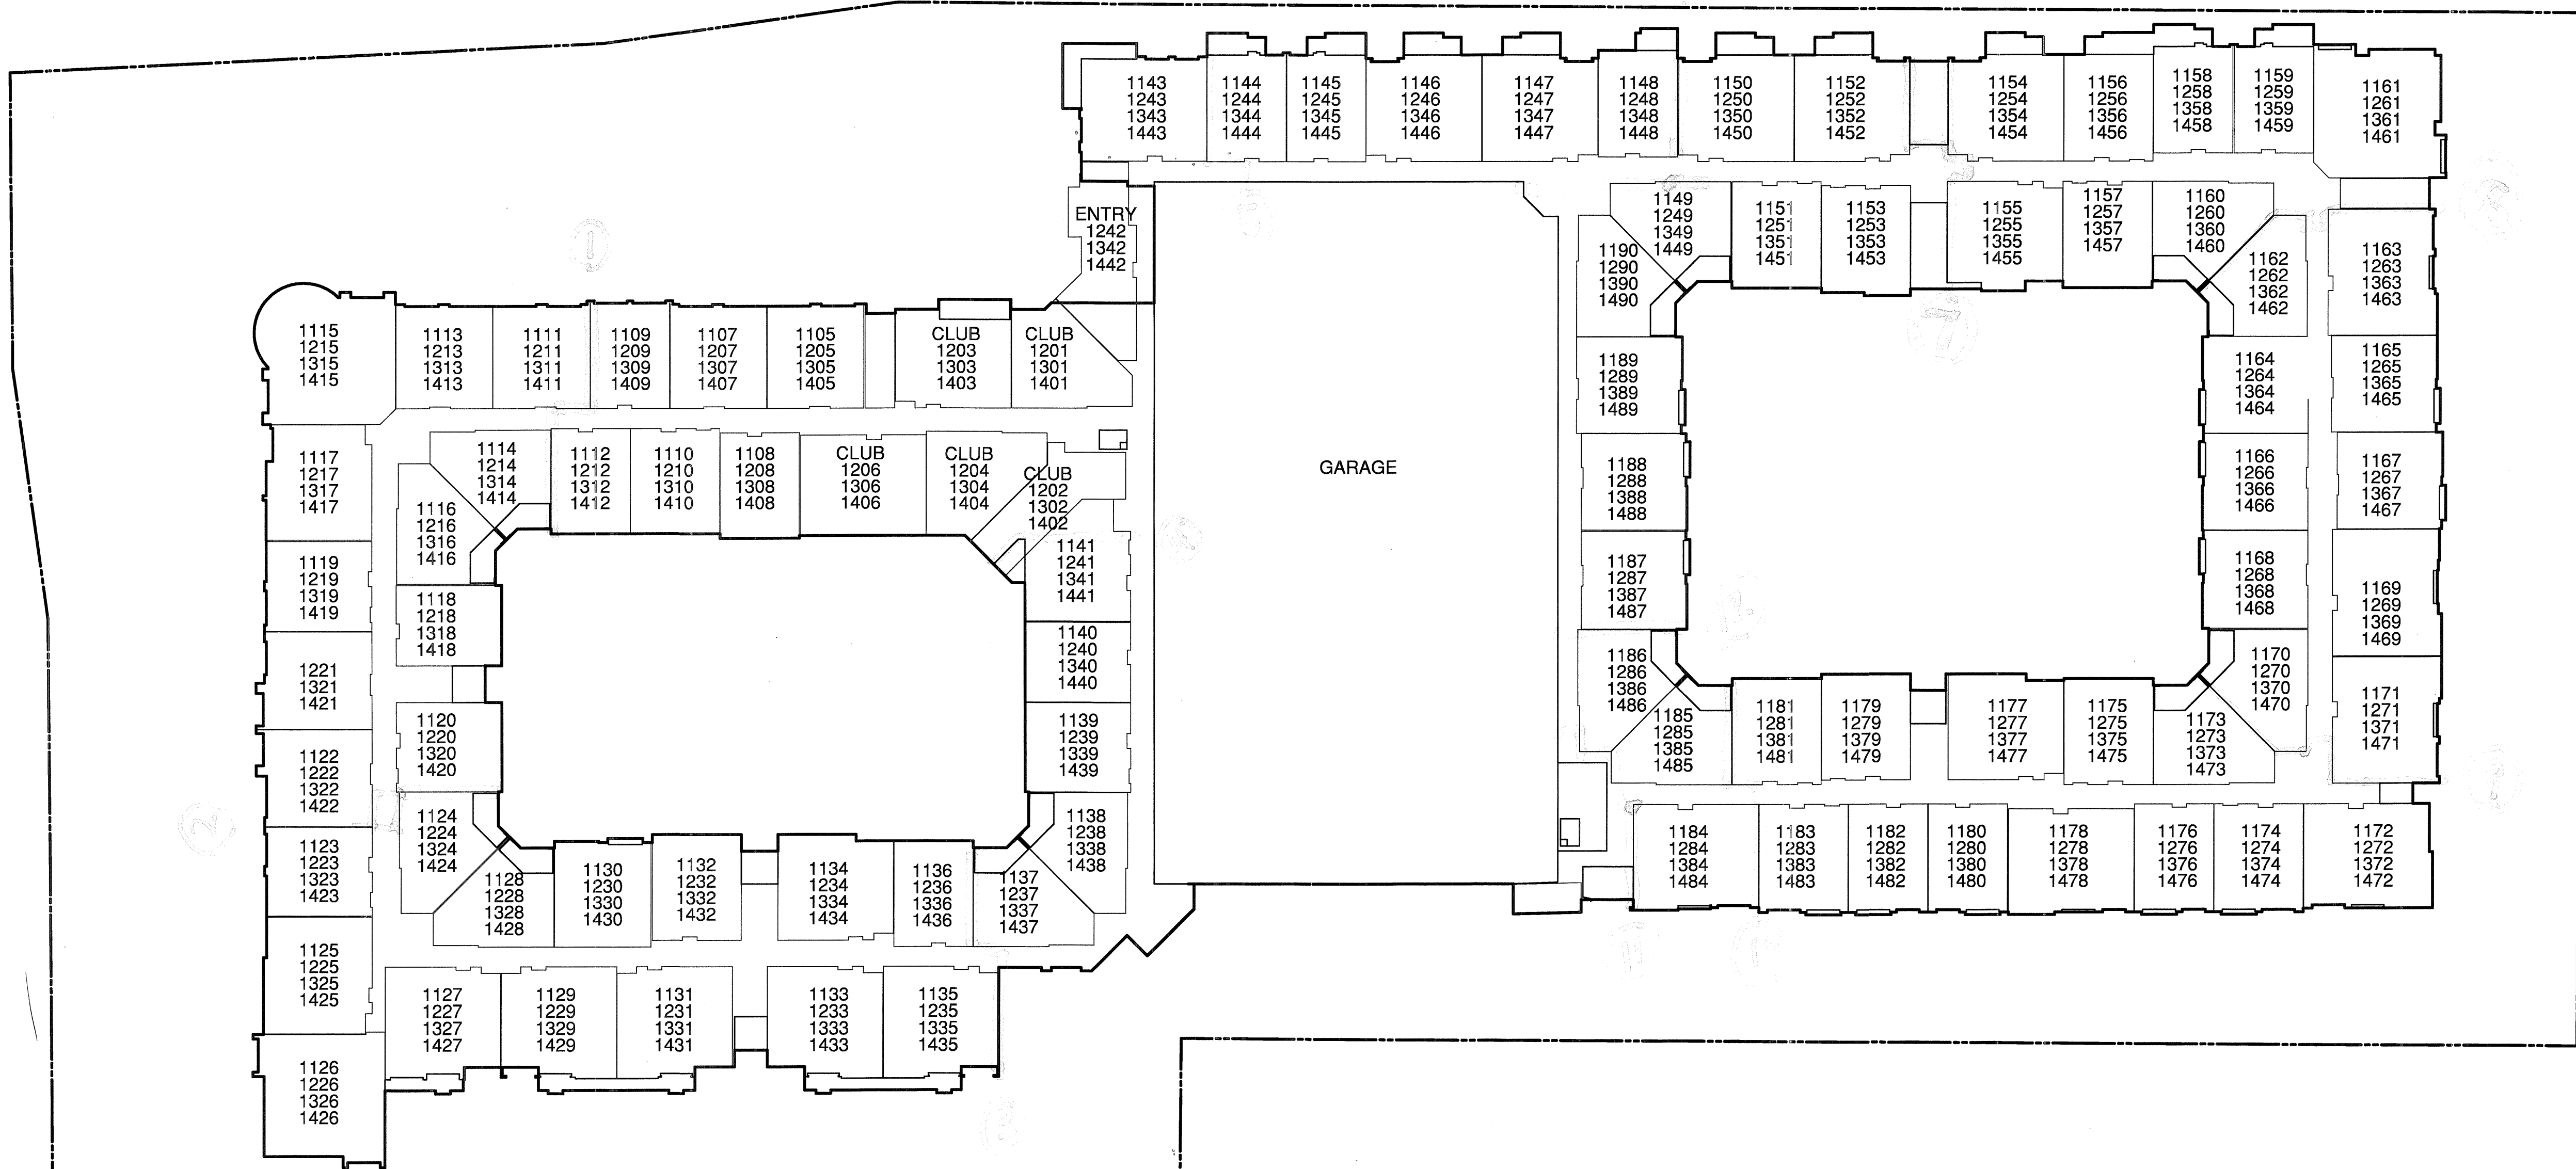

GRAPHIC SCALE

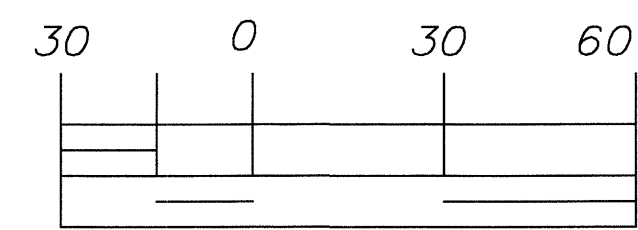

SCALE: 1"=30.00'

1 ADDRESS PLAN
SCALE: 1"=30.00'

CONSTRUCTION ISSUE
10-17-2011



4144 N. Central Expy.
Suite 855
Dallas, TX 75204
214.520.8878
bgoarchitects.com

DATE

08-05-2011

PROJECT

11129

SHEET NUMBER

1.2

ADDRESS PLAN

COPYRIGHT © Beeler Guest Owens Architects All Rights Reserved