

1 BUILDING EGRESS PLAN LEVEL 1

SCALE: 1:20


BGO
architects
4144 N. Central Expy.
Suite 955
Dallas, TX 75204
214.520.8878
bgoarchitects.com

CONSTRUCTION ISSUE
10-17-2011

REVISIONS

KELLER SPRINGS LOFTS

LOFT APARTMENTS IN ADDISON, TEXAS

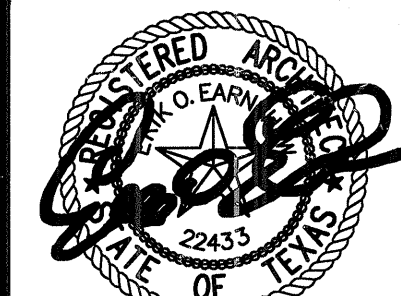

10-17-2011

DATE
08-05-2011

PROJECT
11129

SHEET NUMBER

1.6

COPYRIGHT © Beeler Guest Owens Architects ALL RIGHTS RESERVED