

EMBREY BUILDERS, LLC.

1020 N. E. Loop 410, Suite 700
San Antonio, TX 78209
Ph : (210) 824-6044 Fax: (210) 824-7656

RFI

To: Erik Earnshaw
BGO Architects
4144 N. Central Expressway
Suite 855
Dallas, TX 75205
Ph: (214)520-8878

RFI #: 30
Date: 1/5/2012
Job: EB-02 Keller Springs Lofts
Phone: 877-777-5115

CC: David Gallagher (Embrey Build (Embrey Construction LLC))

Subject: Door Schedule


Drawing: None Spec Section: Schedule Impact: None
Cost Impact: None

Request: Erik can you provide the door schedule for the common areas doors # 20 and up. **Date Required:** 1/12/2012
Requested by: Bryan Pickler
Embrey Partners, Ltd.

Response:

All common door and windows are on sheet 2.0A
within your set

Erik Earnshaw
Answered by BGO Architects Date 01-05-2012
Company Date

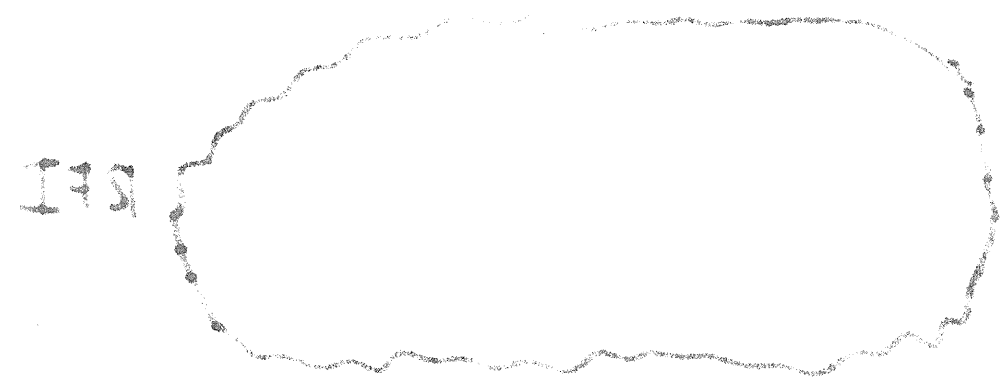

Embrey Builders, LLC

1020 N. E. Loop 410, Suite 700
San Antonio, TX 78209
Ph : (210) 824-6044 Fax: (210) 824-7656

RFI

To: Erik Earnshaw
Beeler Guest Owens Architects
4245 N. Central Expressway
Suite 300
Dallas, TX 75205
Ph: 214/520-8878 Fax: 214/520-8879

RFI #: 155
Date: 6/13/2012
Job: EB-02 Keller Springs Lofts
Phone: 877-777-5115

CC: Trent Perkins (Parkin Perkins Olsen)

Subject: Units with a Mark 17, 18 and 19 Door

Drawing: Unit Plans Spec Section: Schedule Impact: None
Cost Impact: None

Request: On certain locations where the door 17, 18 and 19 occur, the framing will not allow us to install a door that wide. We propose the following: **Date Required:** 6/20/2012
17 = 2'-8" 3'-0" 2'-8"
18 = 2'-8" 3'-0" 2'-8"
19 = 2'-8" 2'-8" 3'-0"
Requested by: David Miller
Embrey Builders LLC

Response:
I agree.
See revised Version 2.0 that is attached

Answered by: Erik Earnshaw Answered date: July 09, 2012
Beeler Guest Owens Architects