




DOOR/WINDOW SCHEDULE

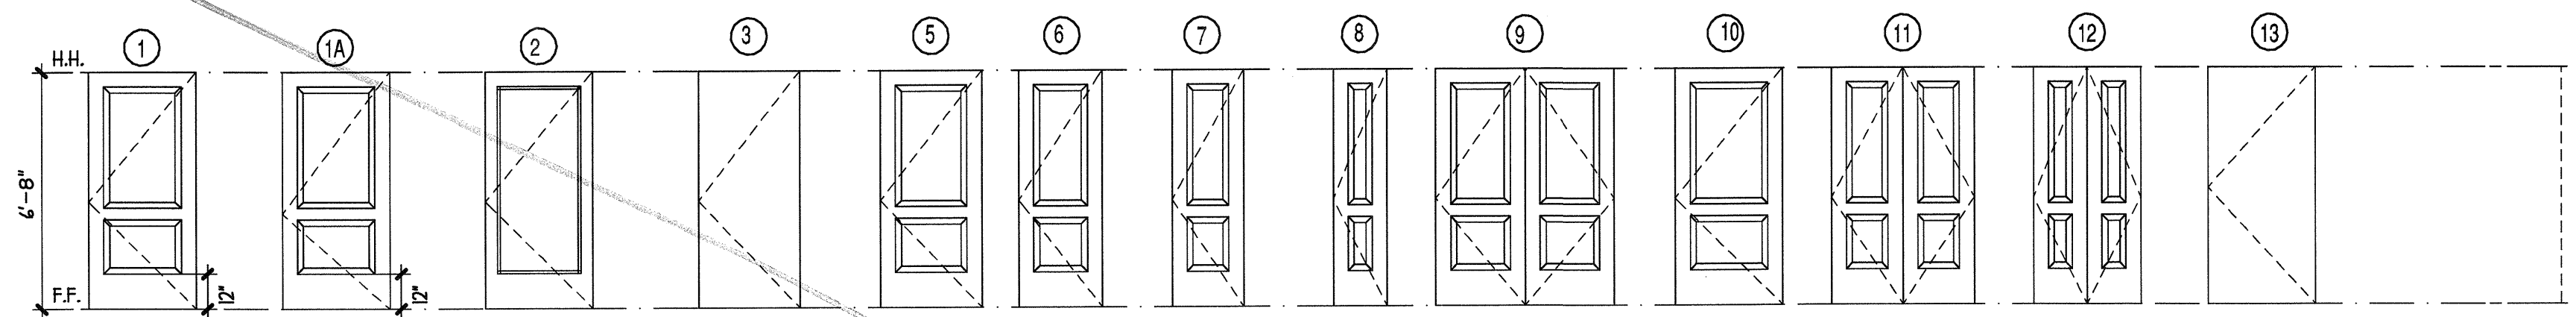

1 3-OX4-8 1 3/4" SC WOOD EXTERIOR GRADE W/ WEATHERSTRIP AND THRESHOLD AND THRESHOLD 20 MIN ASSEMBLY WITH SMOKE SEAL, CLOSURE, LATCH AND LABELED DOOR & FRAME 2-PANEL
1A 3-OX4-8 1 3/4" SC WOOD EXTERIOR GRADE W/ WEATHERSTRIP AND THRESHOLD 90 MIN ASSEMBLY WITH SMOKE SEAL, CLOSURE, LATCH AND LABELED DOOR & FRAME UNIT #2 ONLY (AS PART 3) 2-PANEL
2 3-OX4-8 1 3/4" FRENCH DOOR EXTERIOR GRADE W/ WEATHERSTRIP AND THRESHOLD 1/4" TEMPERED GLASS 2-PANEL
3 2-OX4-8 1 3/4" MTL. INSULATED EXTERIOR GRADE W/ WEATHERSTRIP AND THRESHOLD 2-PANEL
5 2-OX4-8 1 3/8" H.C. MASONITE 2-PANEL
6 2-OX4-8 1 3/8" H.C. MASONITE 2-PANEL
7 2-OX4-8 1 3/8" H.C. MASONITE 2-PANEL
8 1-OX4-8 1 3/8" H.C. MASONITE 2-PANEL
9 PR 2-66-84 3/4" H.C. MASONITE 2-PANEL
10 3-OX4-8 1 3/8" H.C. MASONITE 2-PANEL
11 PR 2-OX4-84 3/4" H.C. MASONITE 2-PANEL
12 PR 1-OX4-8 1 3/8" H.C. MASONITE 2-PANEL
13 3-OX4-8 1 3/8" METAL NON-INSUL. MTL. JAMB PAINT GRADE NON-RATED LOCK SET

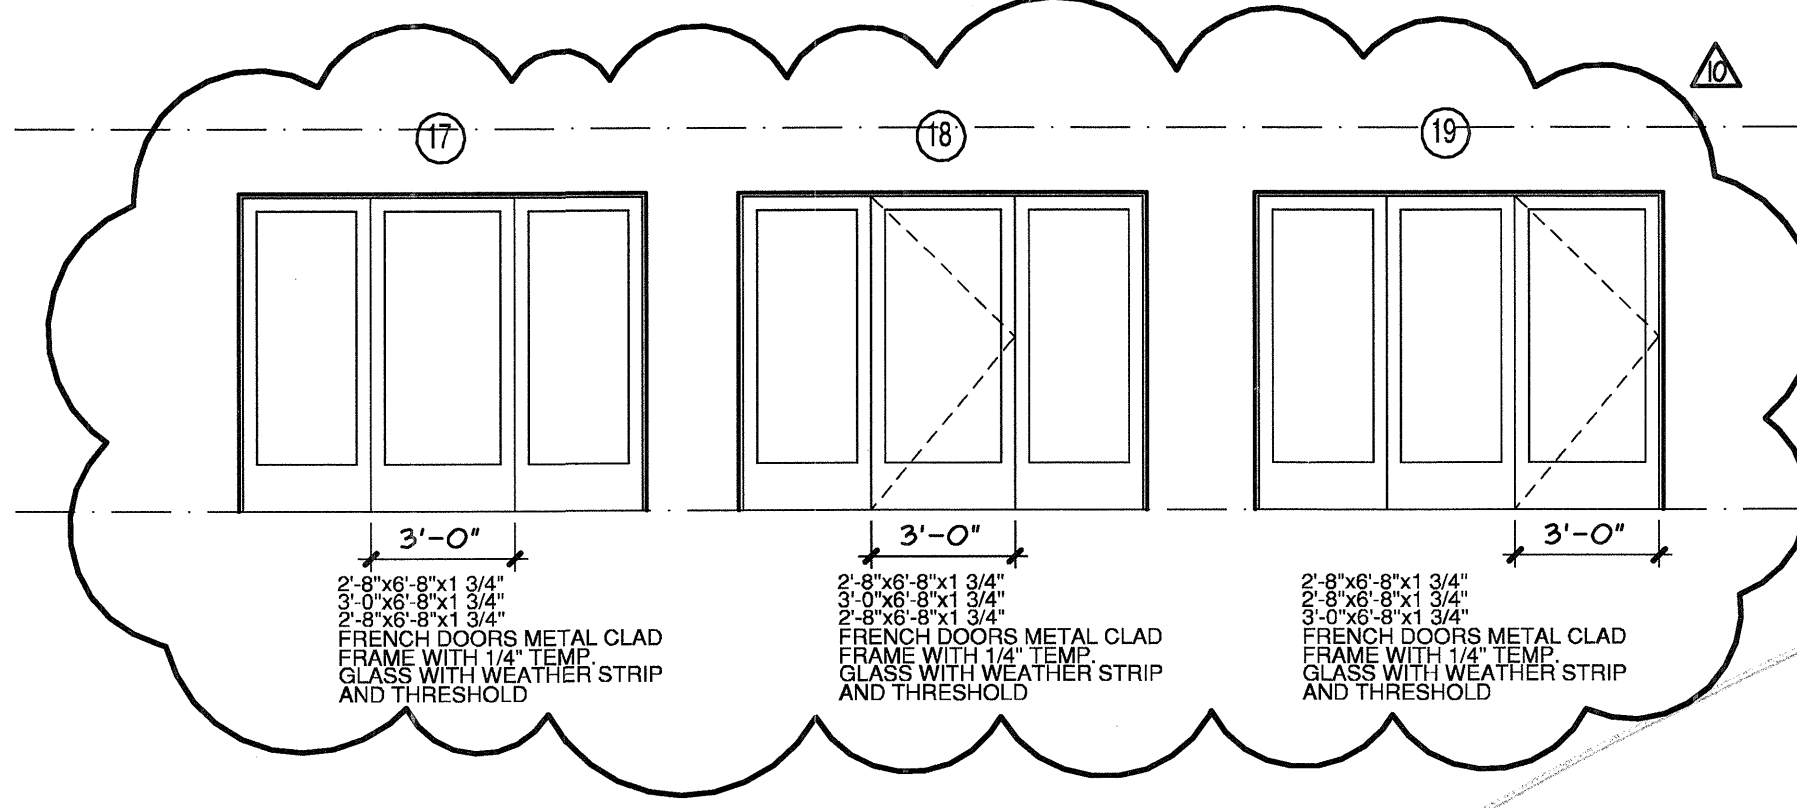


17 2-8'x6-8'x1 3/4" FRENCH DOORS METAL CLAD FRAME WITH 1/2" TEMP. GLASS WITH WEATHER STRIP AND THRESHOLD 3'-0"
18 2-8'x6-8'x1 3/4" FRENCH DOORS METAL CLAD FRAME WITH 1/2" TEMP. GLASS WITH WEATHER STRIP AND THRESHOLD 3'-0"
19 2-8'x6-8'x1 3/4" FRENCH DOORS METAL CLAD FRAME WITH 1/2" TEMP. GLASS WITH WEATHER STRIP AND THRESHOLD 3'-0"

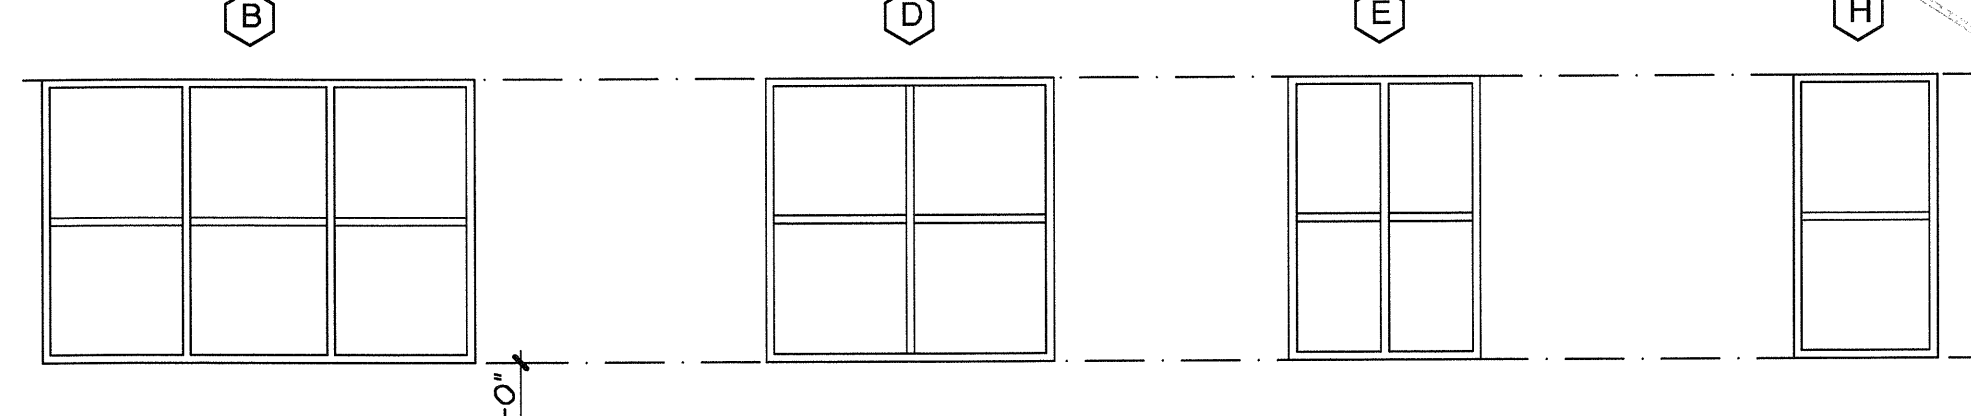

B TRIPLE 3'-0"x6'-0" DRILL GLAZED SINGLE HUNG 2'-0"
D PR 3'-0"x6'-0" DRILL GLAZED SINGLE HUNG
E PR 3'-0"x6'-0" DRILL GLAZED SINGLE HUNG
H 3'-0"x6'-0" DRILL GLAZED SINGLE HUNG

METAL GRILLE

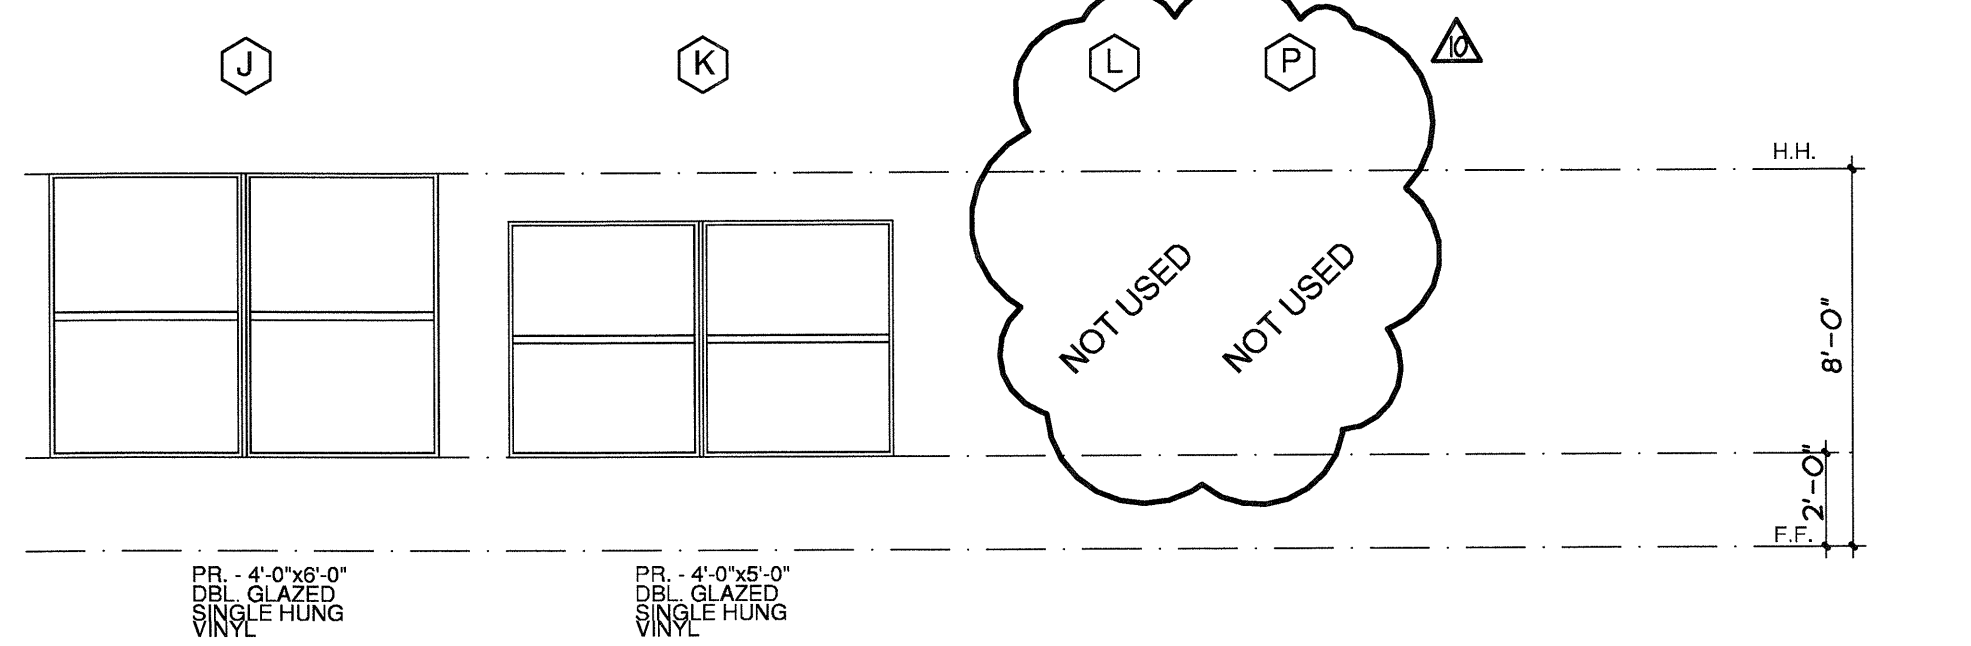

J PR 4'-0"x6'-0" DRILL GLAZED SINGLE HUNG
K PR 4'-0"x6'-0" DRILL GLAZED SINGLE HUNG
L NOT USED
P NOT USED
Q TRIPLE 3'-0"x6'-0" METAL GRILLE NO GLASS 2'-0"


GENERAL NOTE:
FIRE EXTINGUISHER CABINETS MUST BE RATED AND GYPSUM BOARD MUST BE BLOCKED AROUND RECESS TO MAINTAIN FIRE RATING INTEGRITY

GENERAL NOTE:
PROVIDE CONTROL JOINTS AT 30 FOOT INTERVALS AT GYPSUM WALLBOARD AND SOFFIT BOARD CONDITIONS IN CORRIDORS


GENERAL NOTE:
FRAME ALL DOORS AT 4'-8" HEAD HEIGHT AND FRAME ALL WINDOWS AT 4'-8" HEAD HEIGHT. REFER TO UNIT PLANS FOR SPECIFIC WINDOWS AT BALCONY LOCATIONS TO BE FRAMED AT 4'-8"

RFI 139


TYPICAL SECTIONS

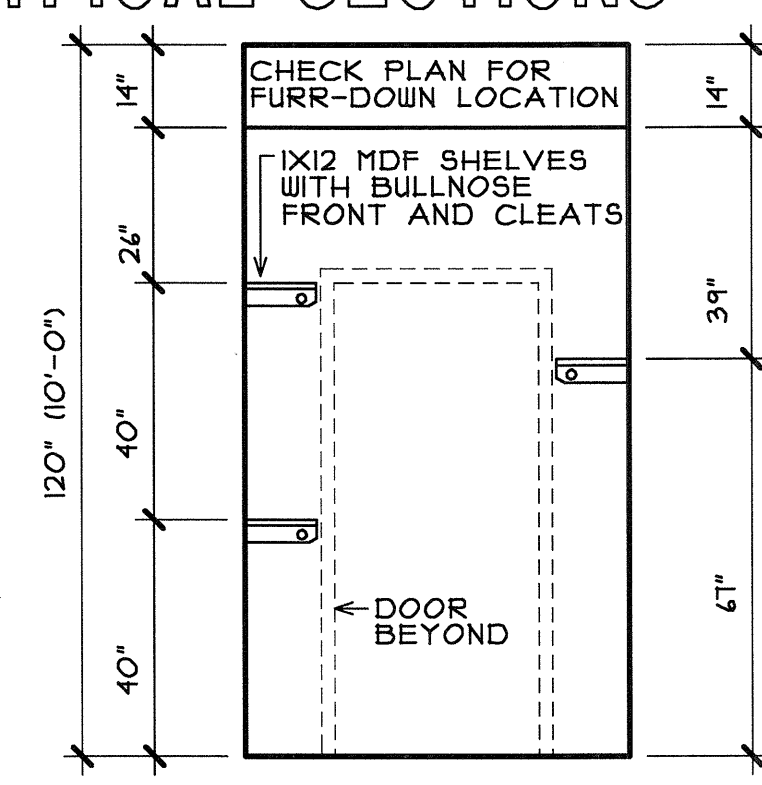


1 CLOSET
3/8"=1'-0"

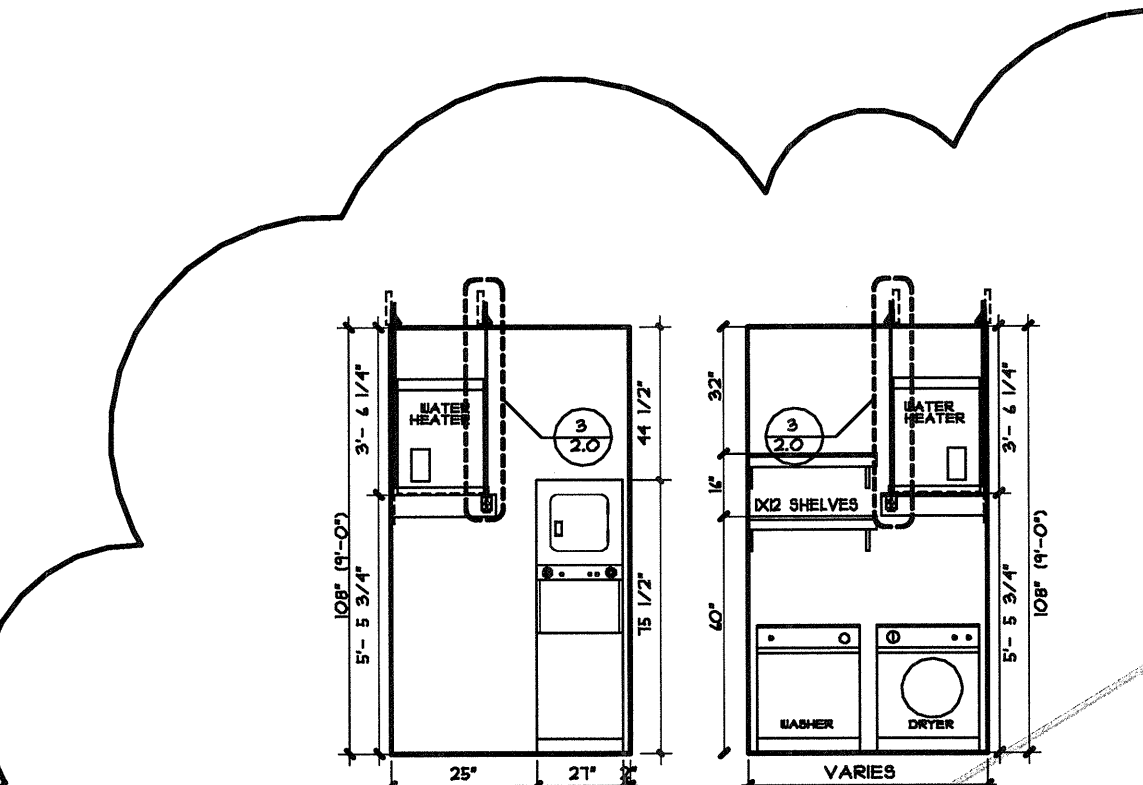


2 UTILITY ROOM
3/8"=1'-0"

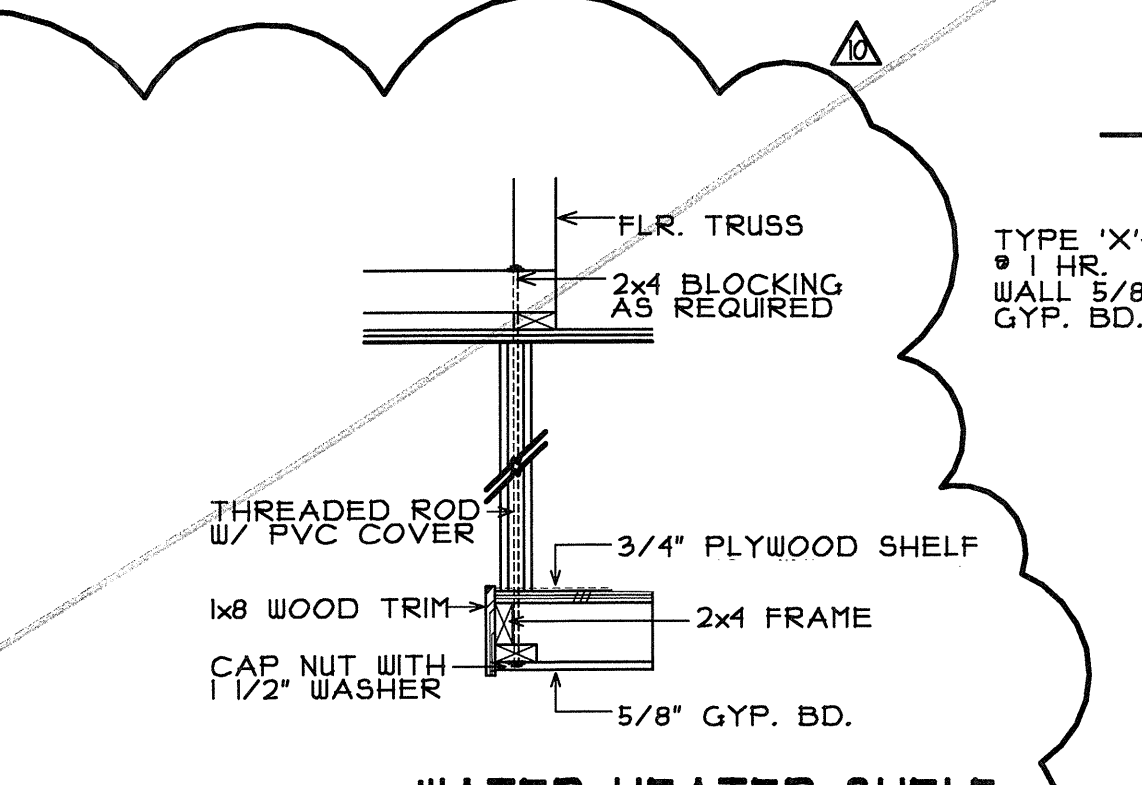


3 WATER HEATER SHELF AT UTILITY ROOM
1/2"=1'-0"

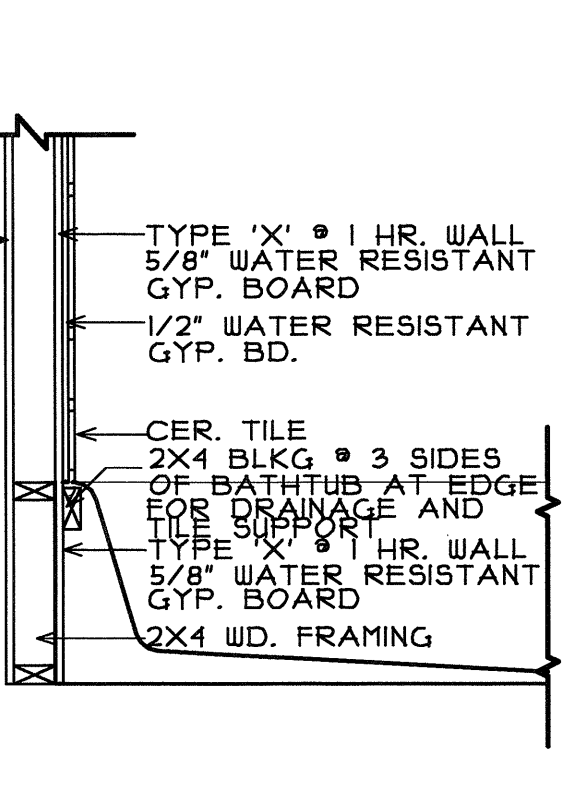


4 BATH TUB SECTION
3/4"=1'-0"

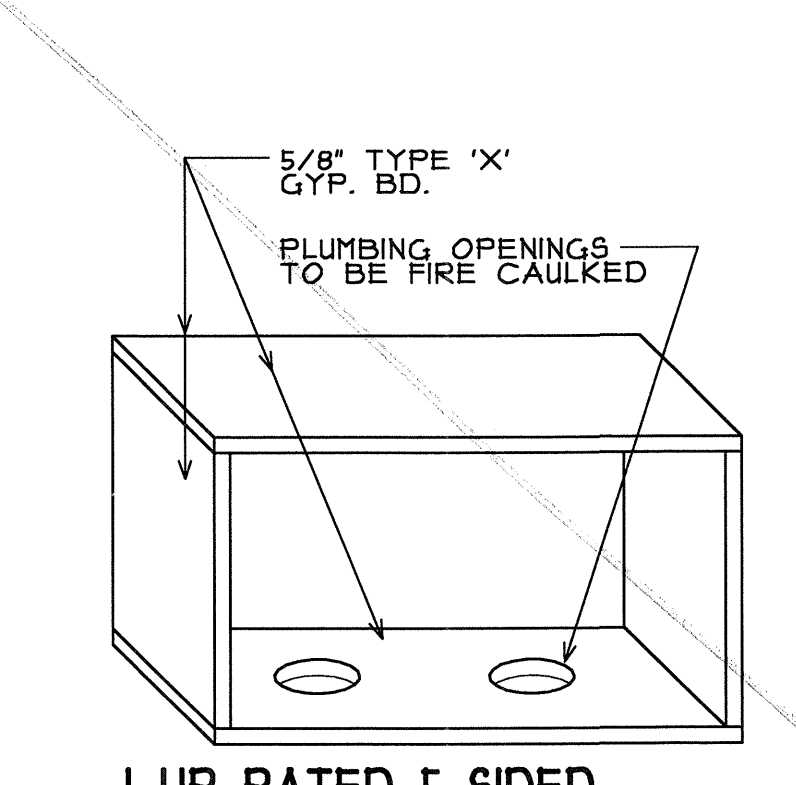


5 1 HR RATED 5 SIDED GYPSUM BOX & WASHER
NOT TO SCALE

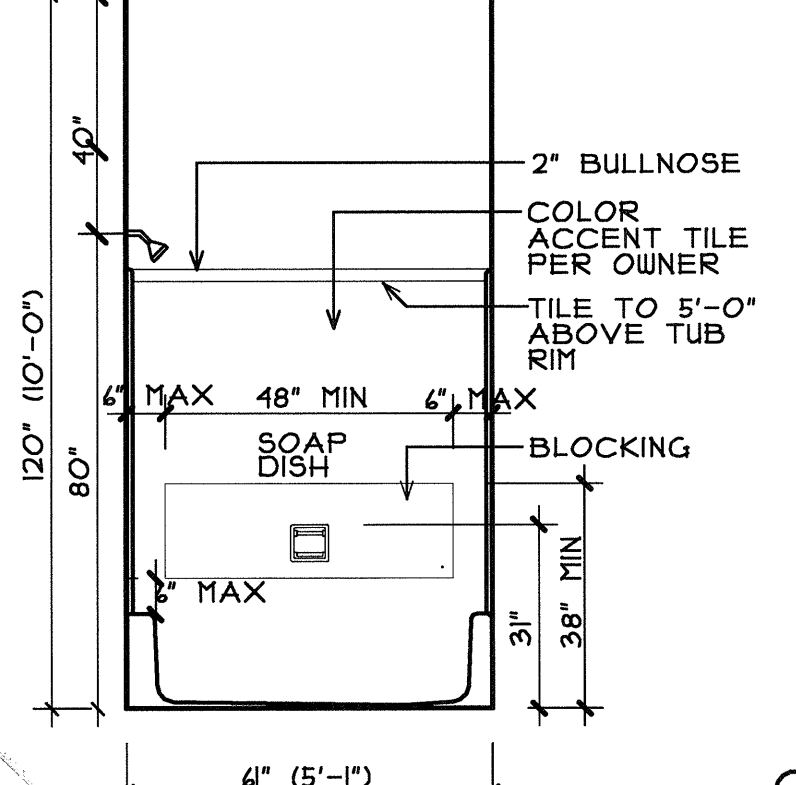


6 BATHTUB
SCALE 3/8"=1'-0"

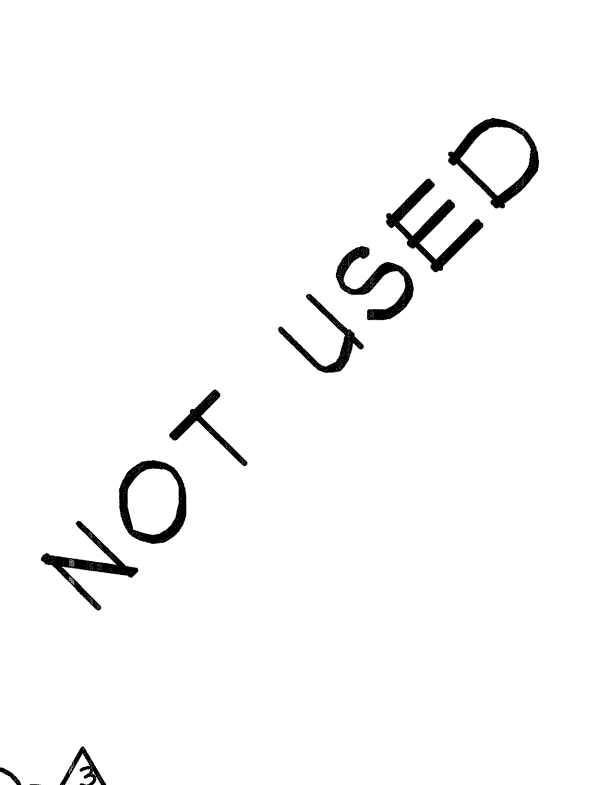


7 NOT USED
NOT TO SCALE

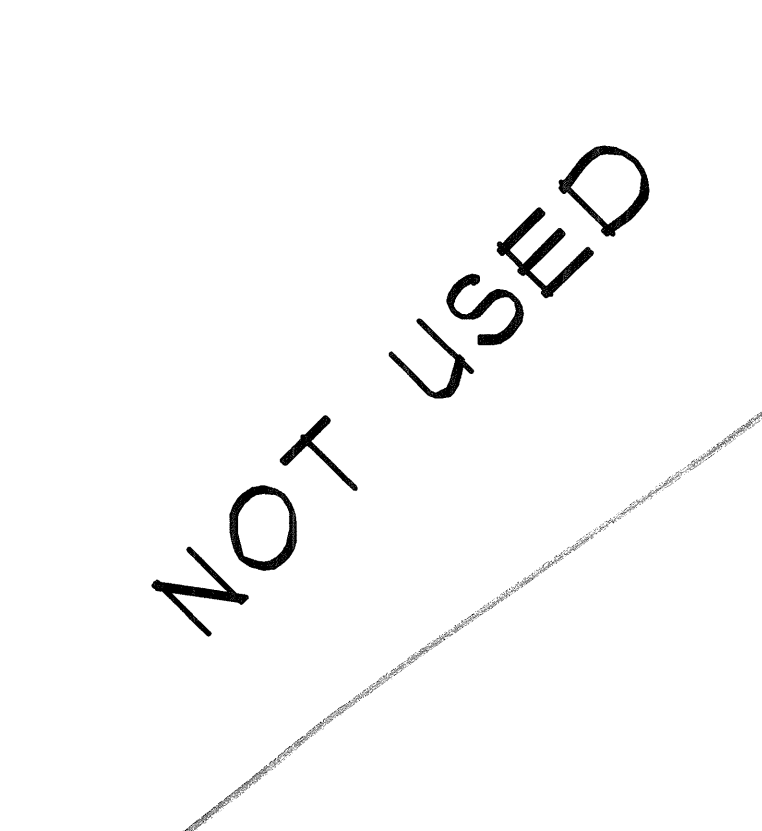


8 NOT USED
NOT TO SCALE

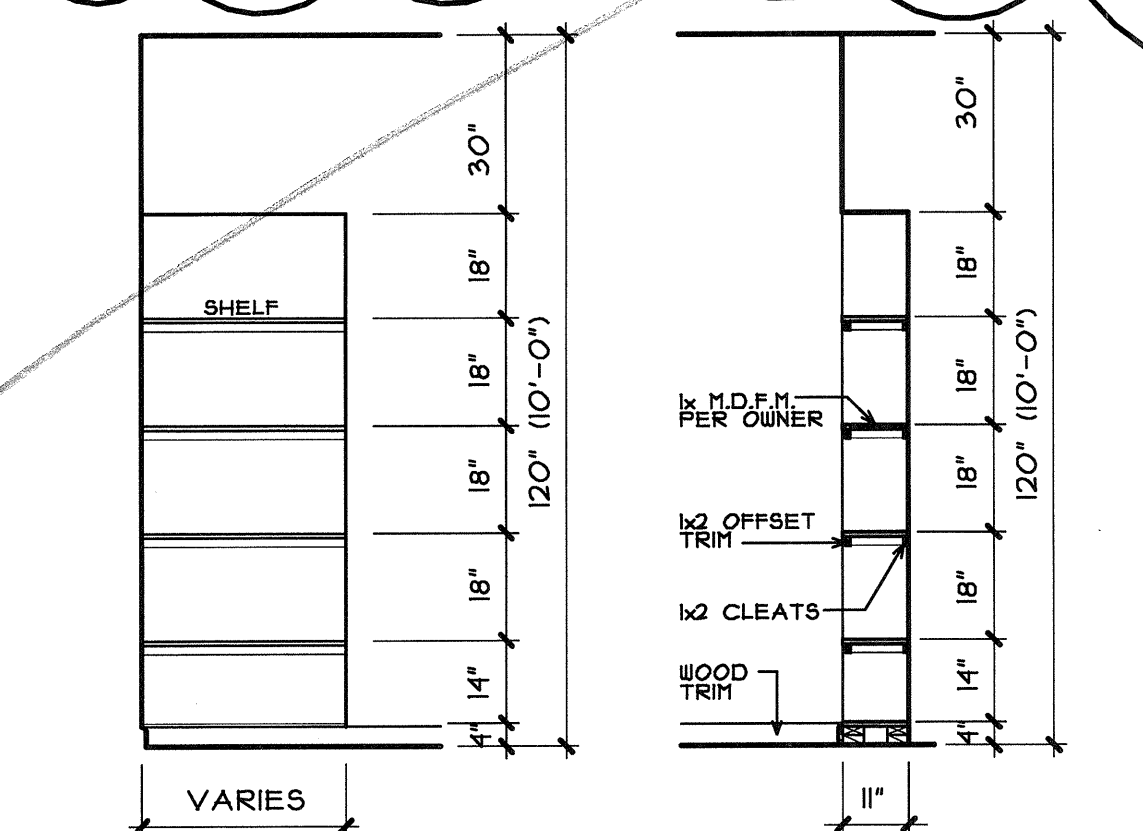


9 ELEVATION & SECTION BOOK SHELF
SCALE: 3/8"=1'-0"

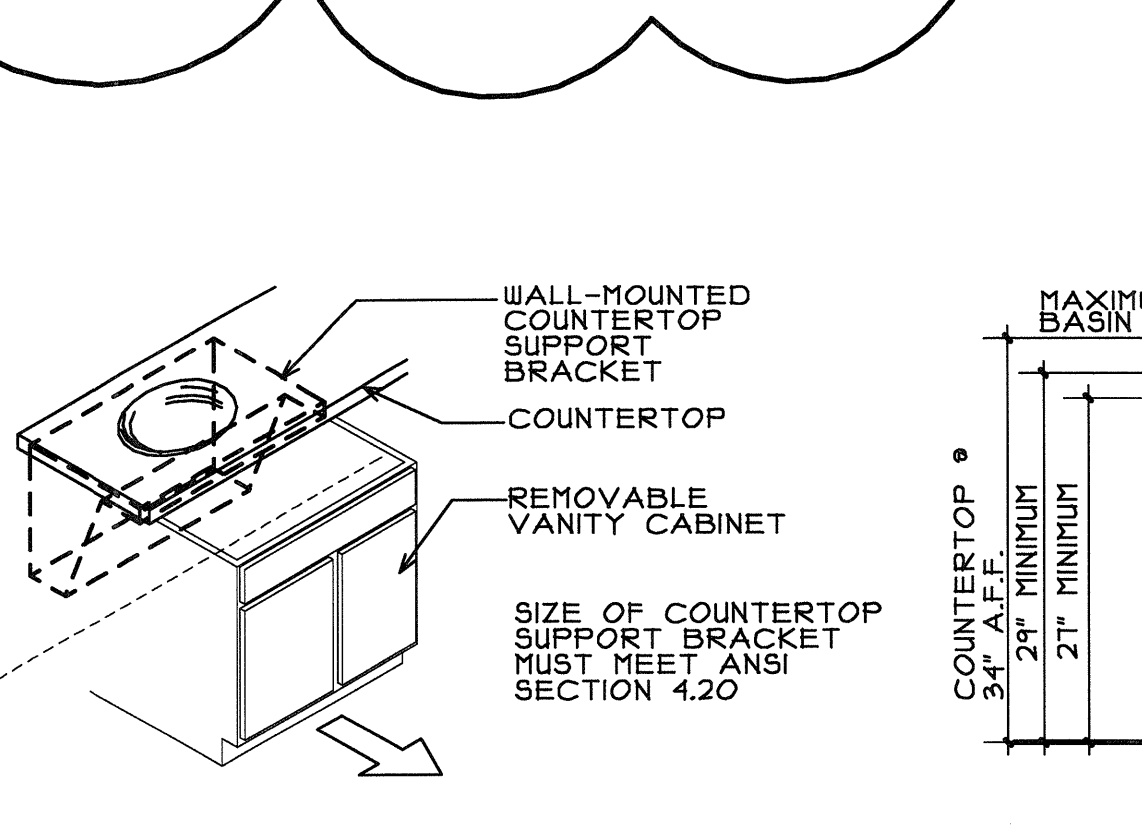


10 REMOVABLE VANITY CABINET
SCALE: 1 1/2"=1'-0"

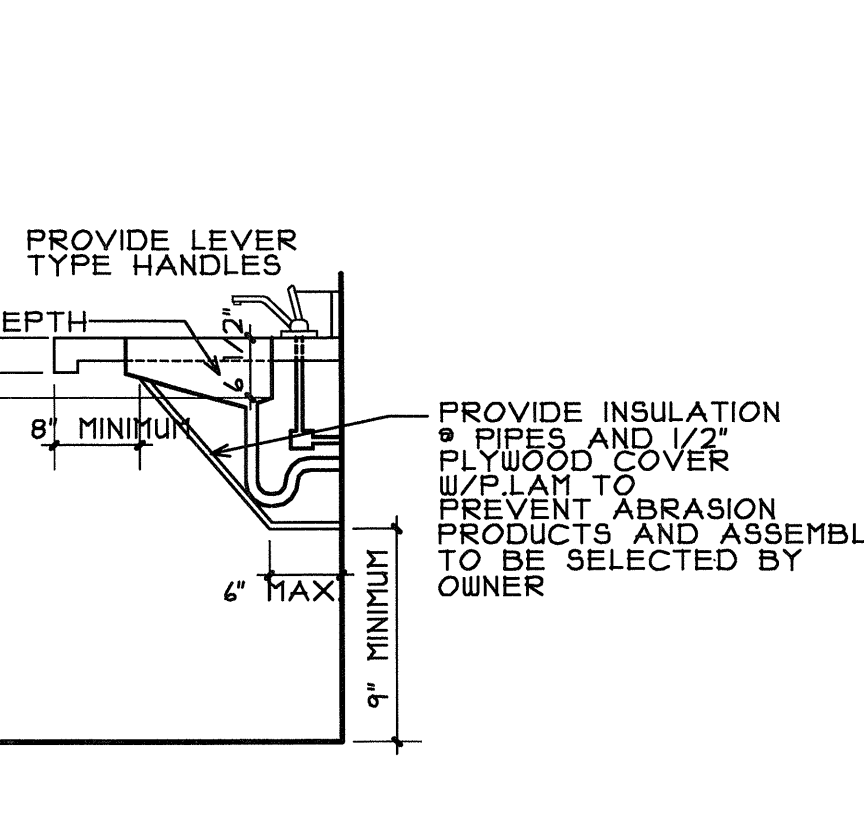

11 ACCESSIBLE SINK DETAIL
SCALE: 1 1/2"=1'-0"

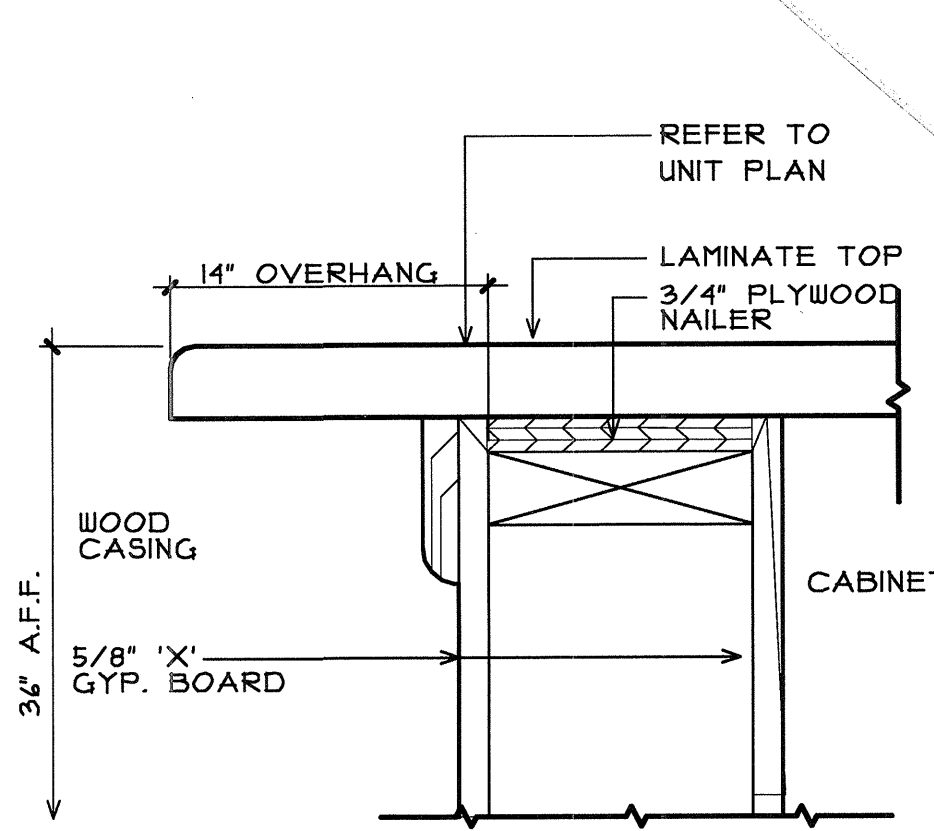

12 TYP. COUNTER EXT. & KITCHEN
SCALE: 3/8"=1'-0"

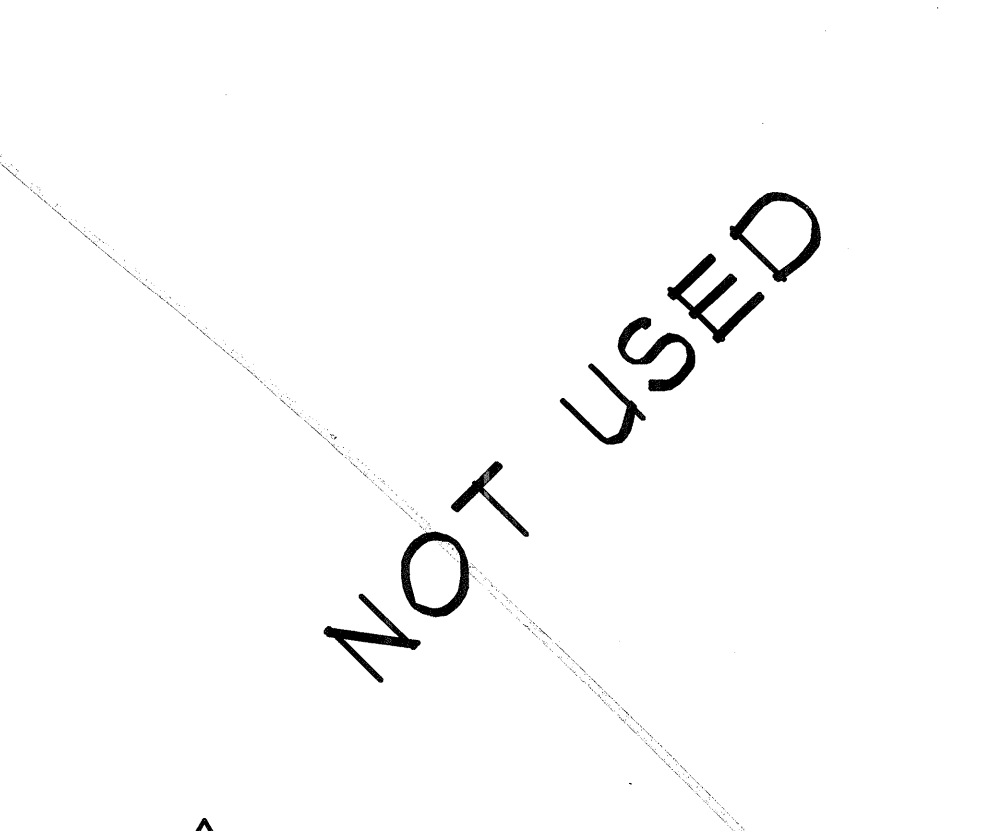

13 NOT USED
SCALE: 3/8"=1'-0"



REVISIONS
 COORDINATION 10-11-2011
 RFI- 85, 141, and 155 01-09-2012

KELLER SPRINGS LOFTS
 LOFT APARTMENTS IN ADDISON, TEXAS

CONSTRUCTION ISSUE
 10-17-2011

BGO architects

4144 N. Central Expy.
 Suite 855
 Dallas, TX 75204
 214.520.8878
 bgoarchitects.com

DATE
 08-05-2011

PROJECT
 11129
 SHEET NUMBER

2.0
SCHEDULE

COPYRIGHT © Beeler Guest Owens Architects ALL RIGHTS RESERVED