

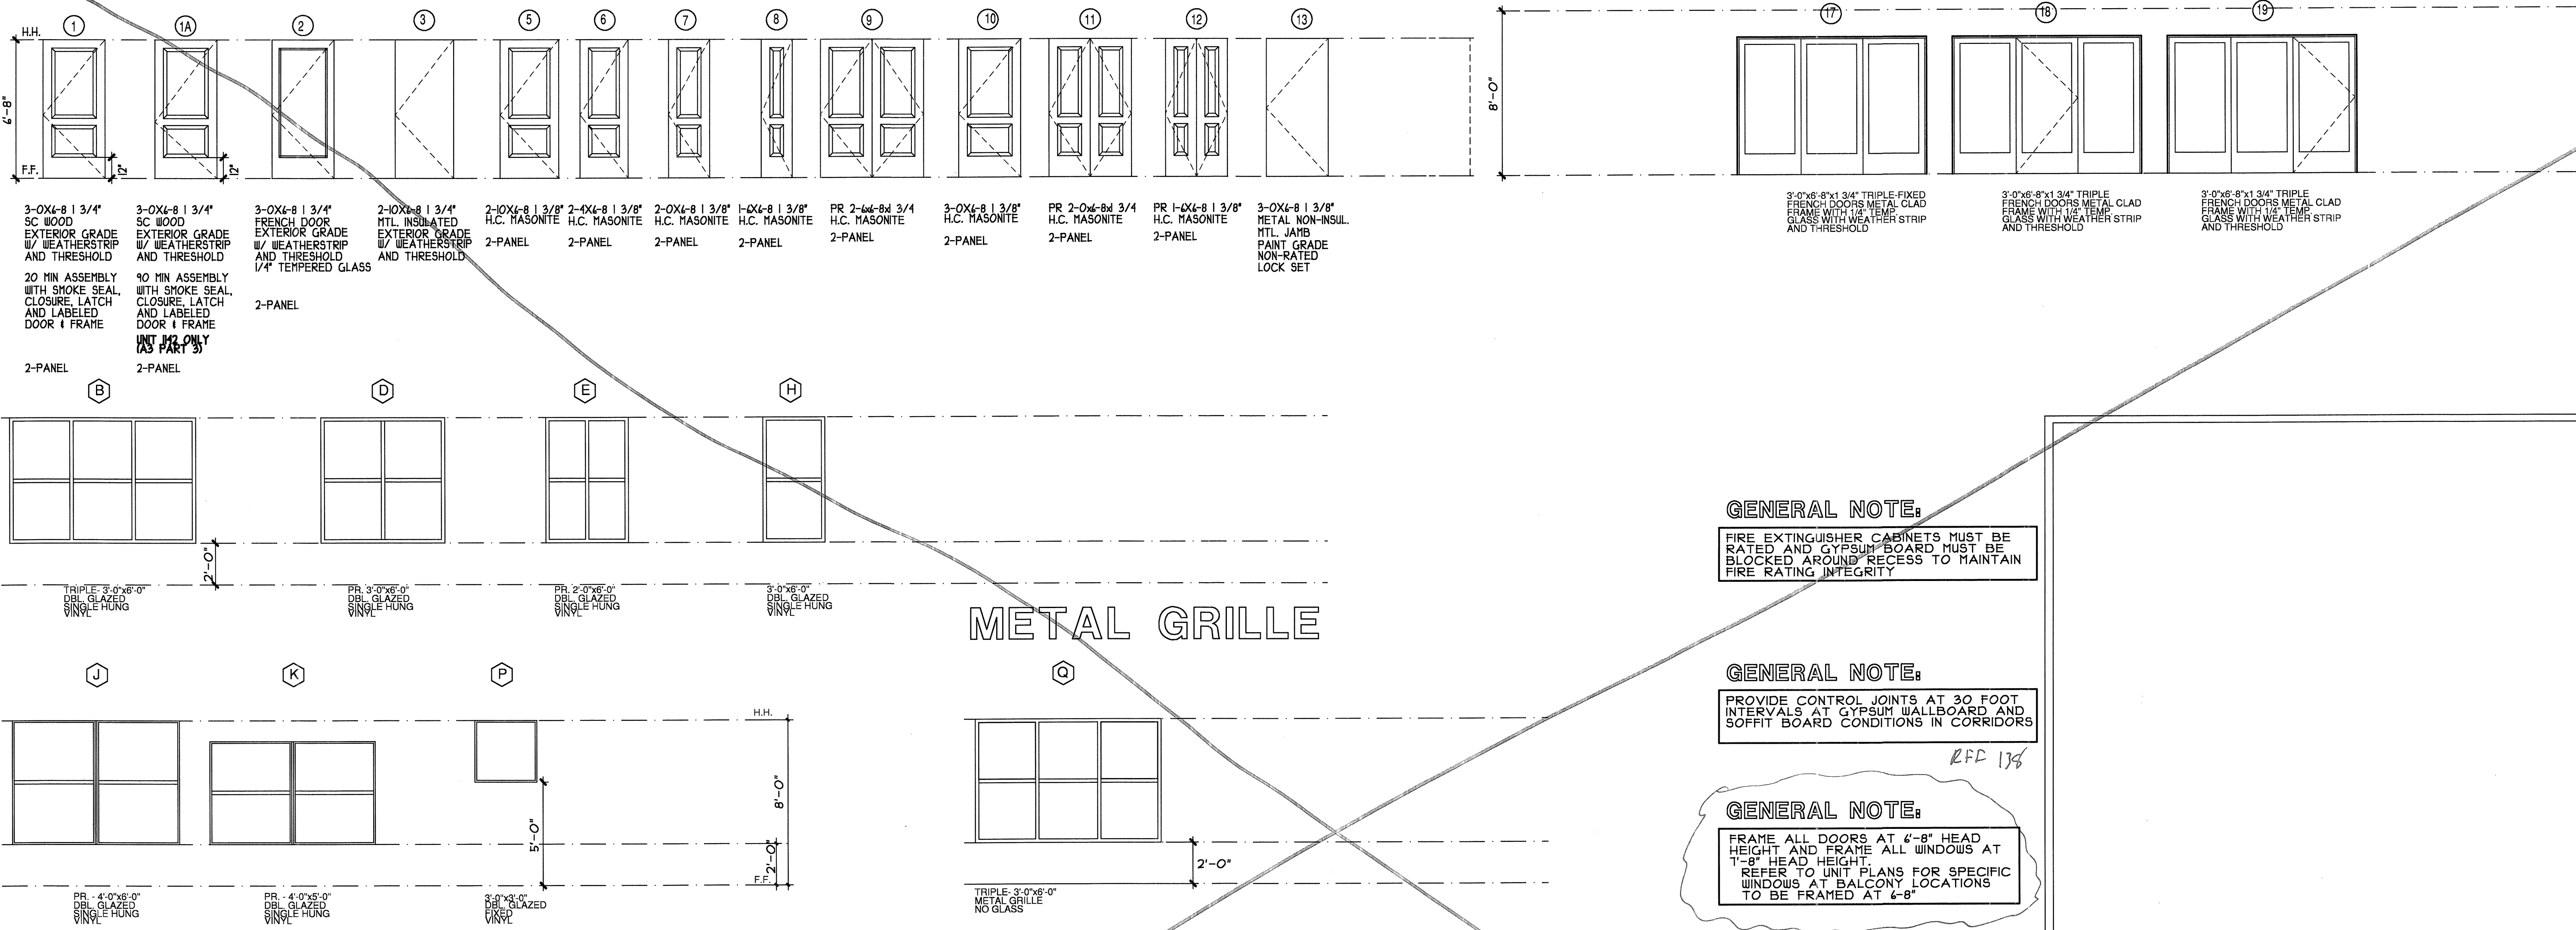


# DOOR/WINDOW SCHEDULE

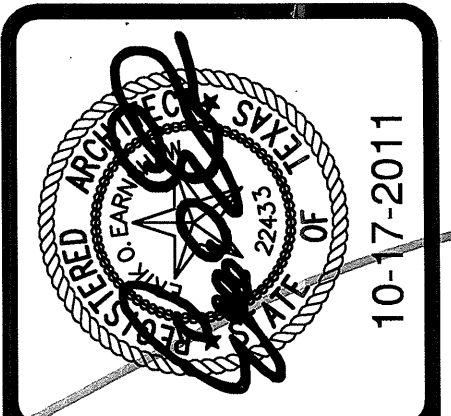

## TYPICAL SECTIONS

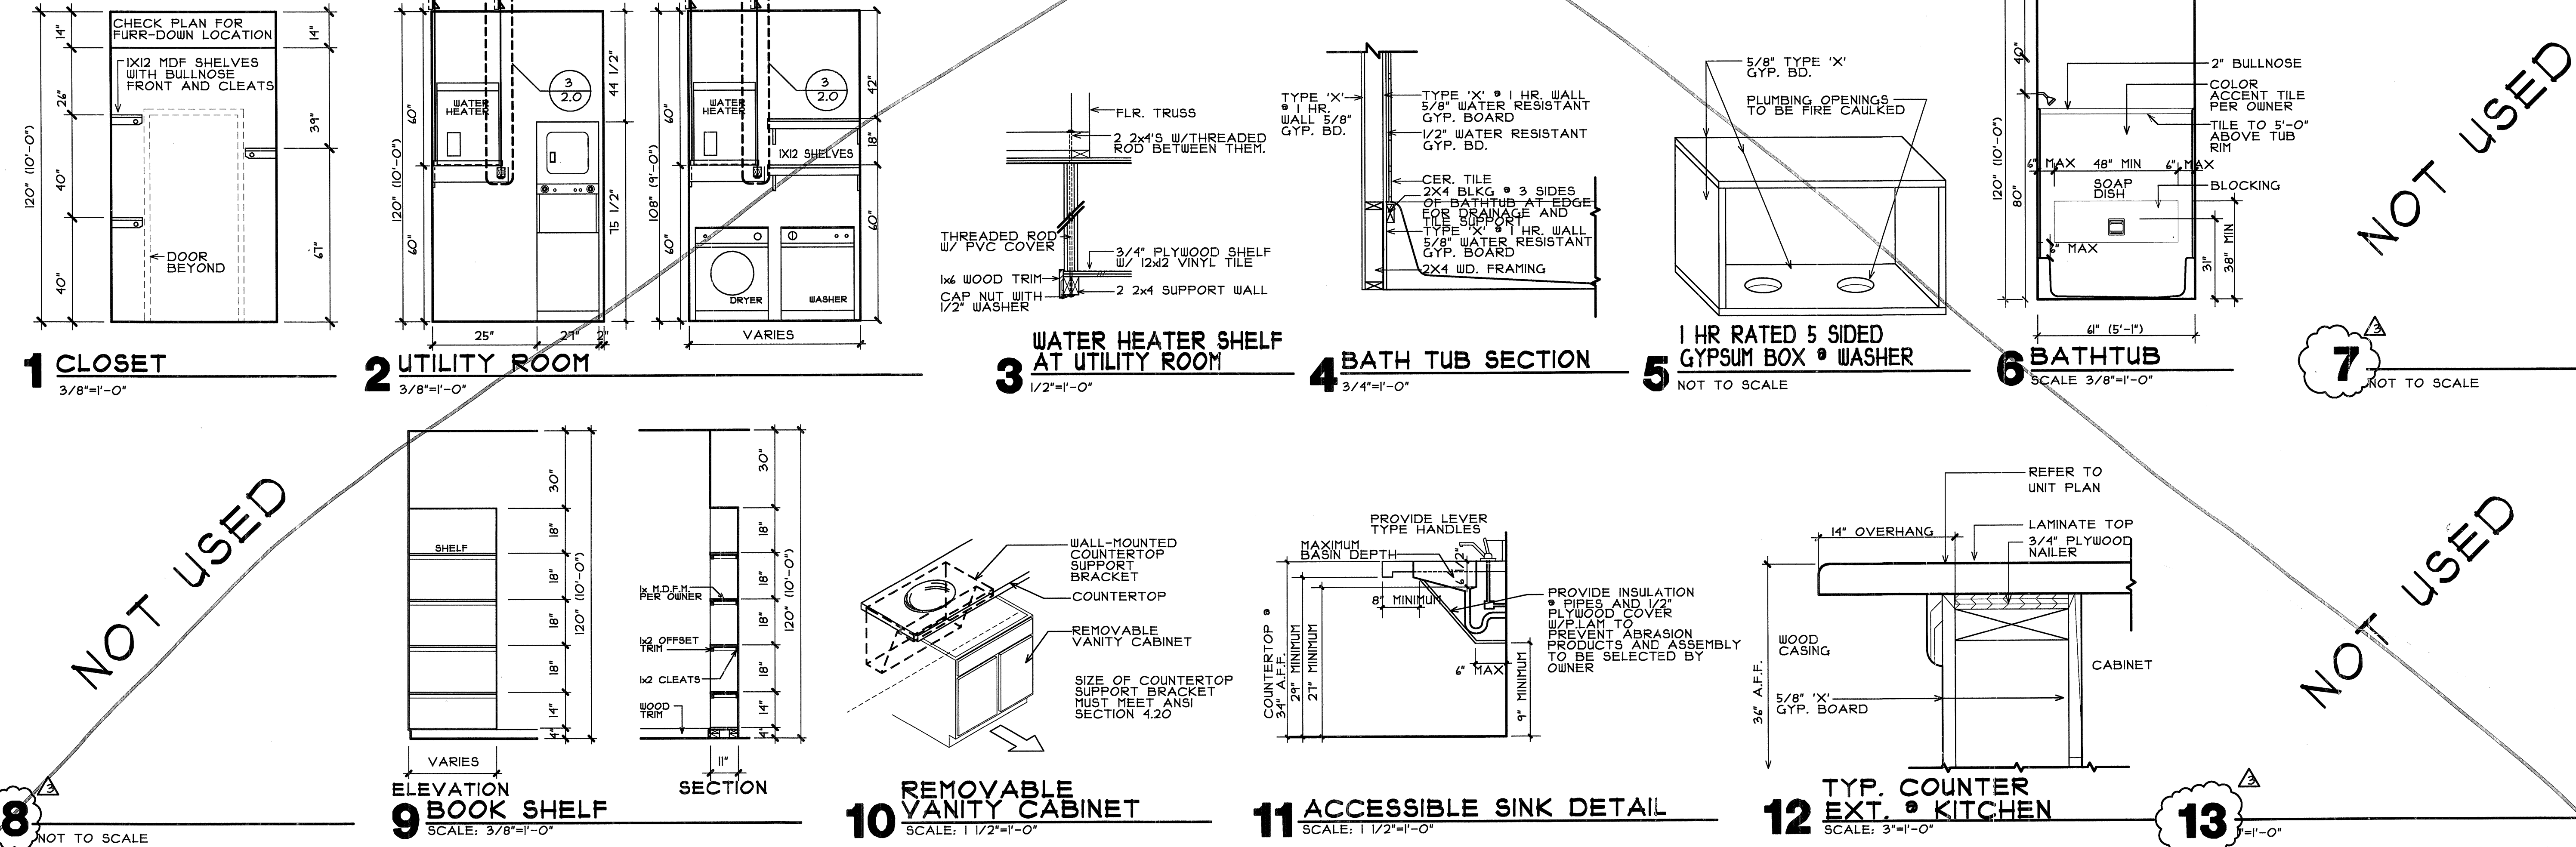

REVISIONS  
 COORDINATION  
 10-11-2011

**KELLER SPRINGS LOFTS**  
 LOFT APARTMENTS IN ADDISON, TEXAS

CONSTRUCTION ISSUE  
 10-17-2011

**BGO**  
 architects

4144 N. Central Exp.  
 Suite 855  
 Dallas, TX 75204  
 214.520.8878  
 bgoarchitects.com

DATE  
 08-05-2011

PROJECT  
 11129

SHEET NUMBER

**2.0**

**SCHEDULE**

COPYRIGHT © Beeler Guest Owens Architects ALL RIGHTS RESERVED