

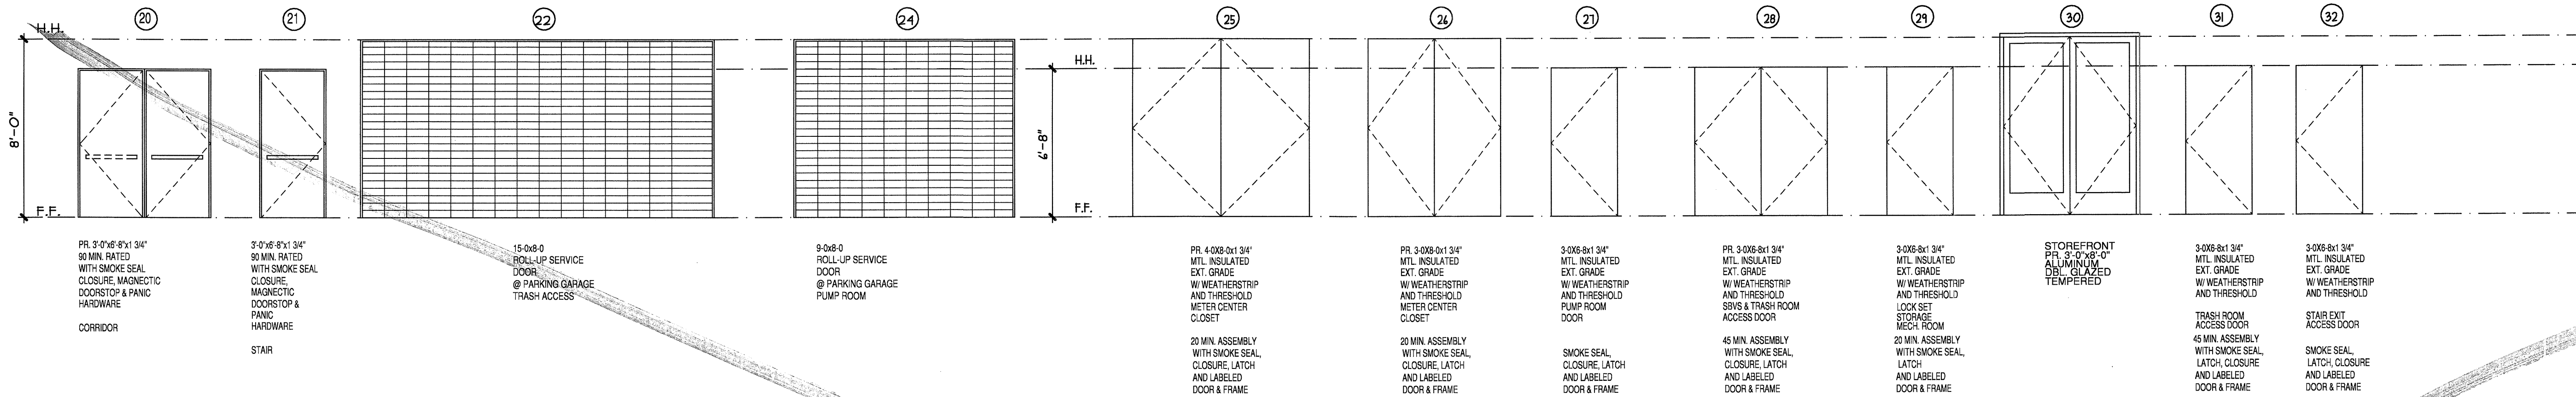


DOOR SCHEDULE (CONTINUED)

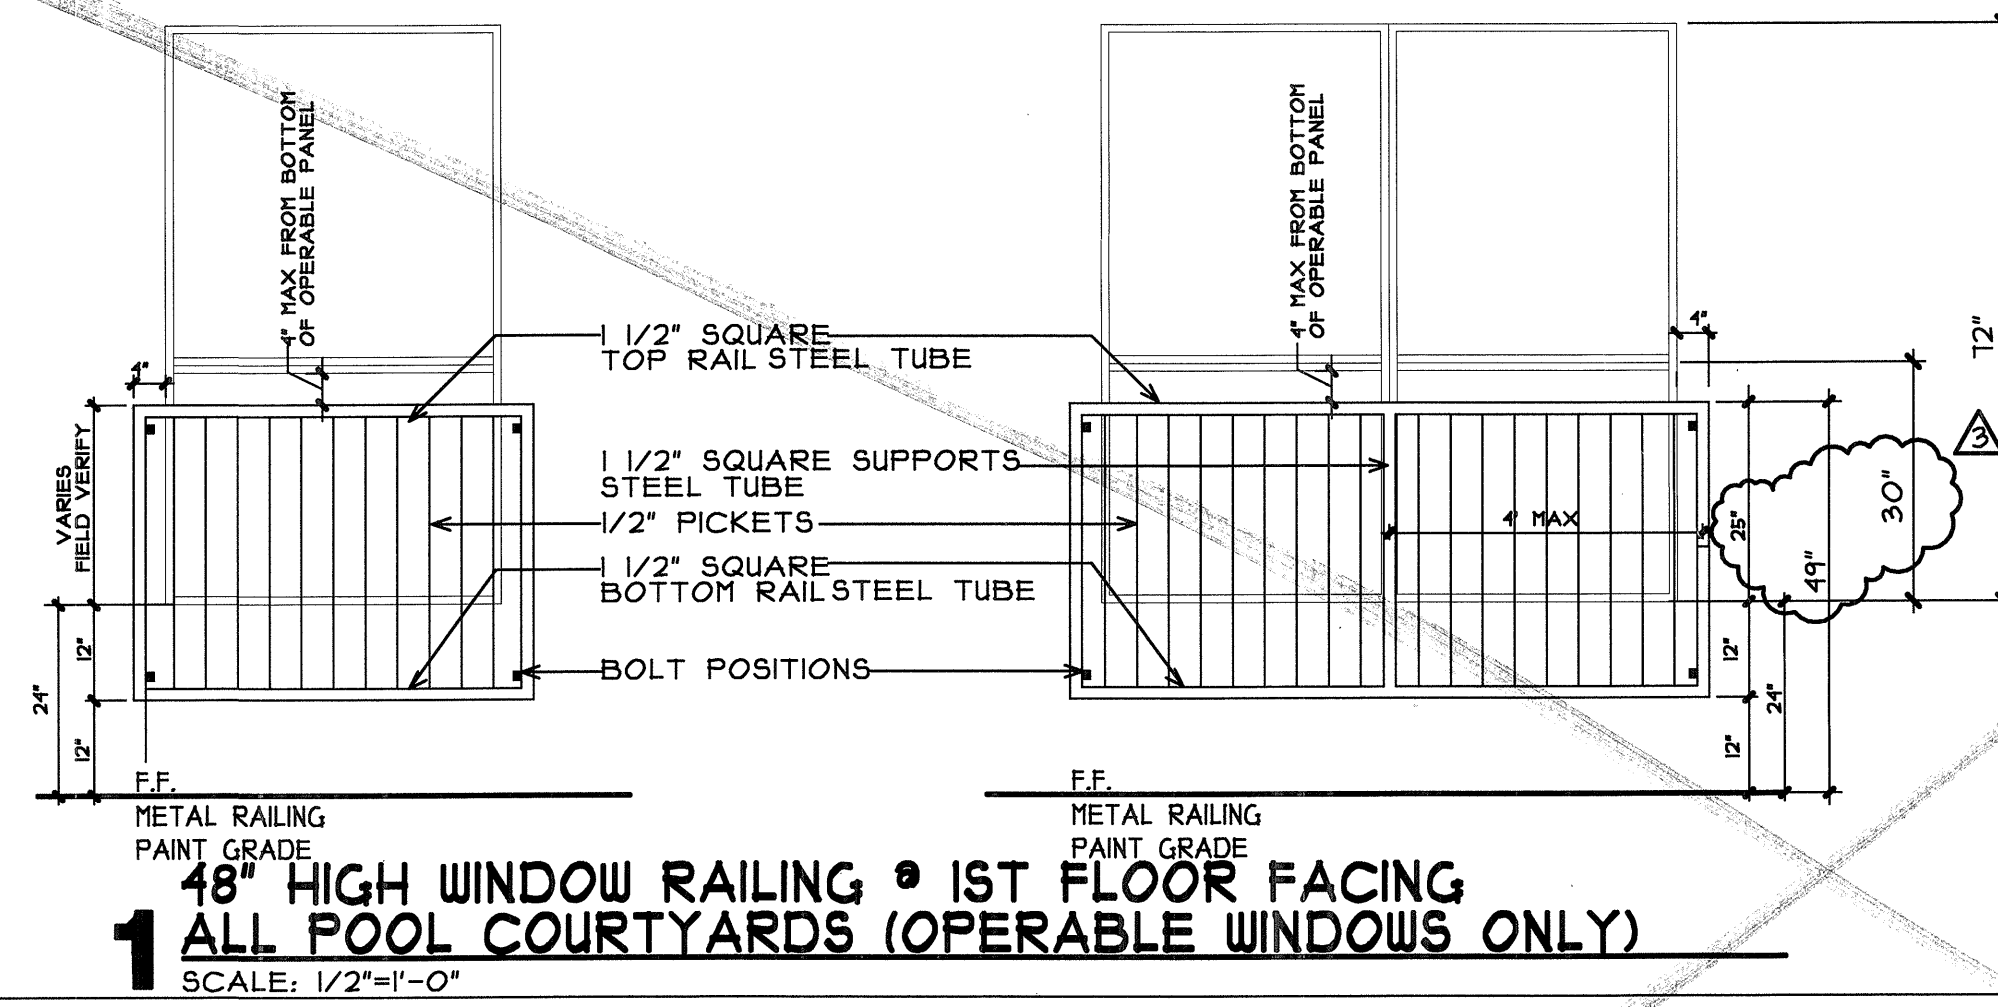


COMMON WINDOW SCHEDULE

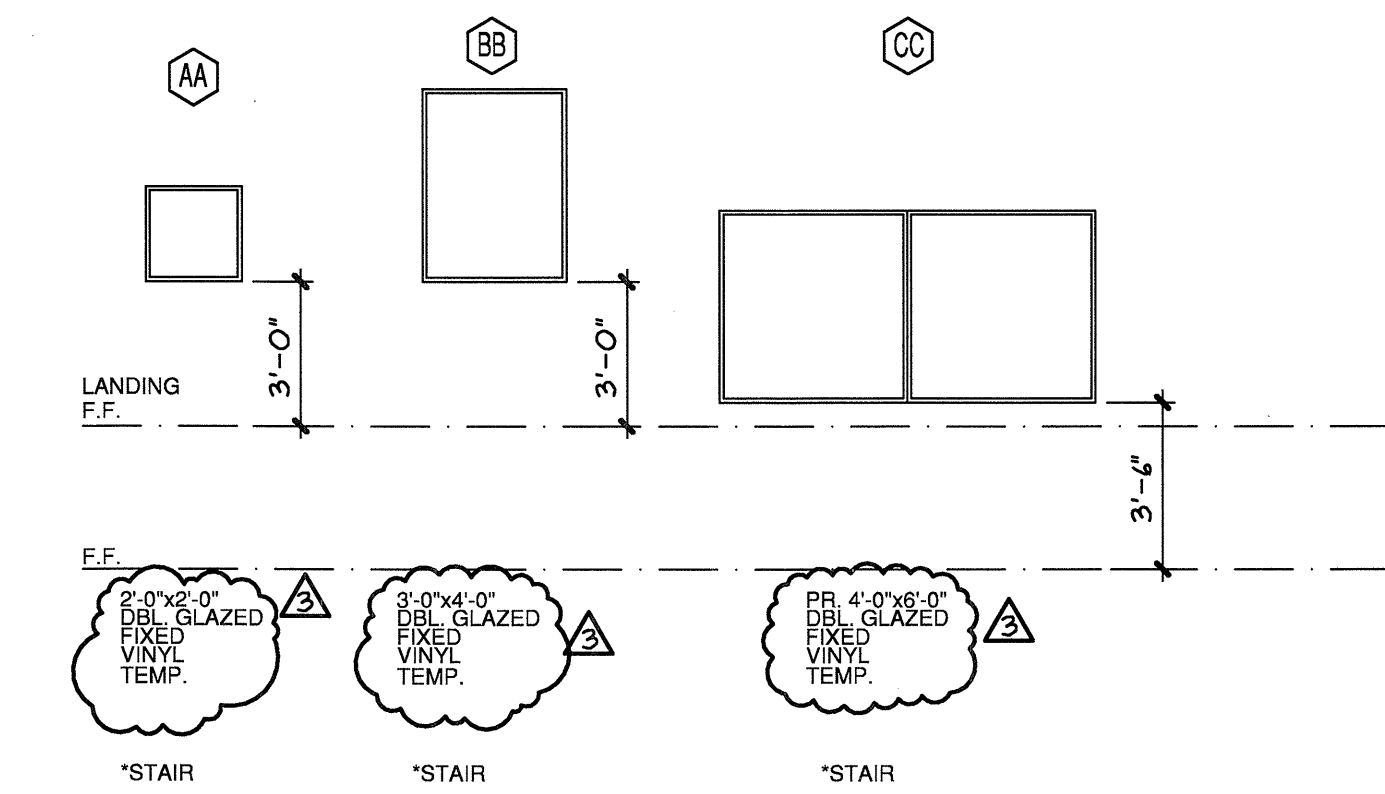

GENERAL NOTE:
FIELD VERIFY ALL OPENINGS PRIOR TO GRILLE AND GATE FABRICATION.

STOREFRONT SCHEDULE

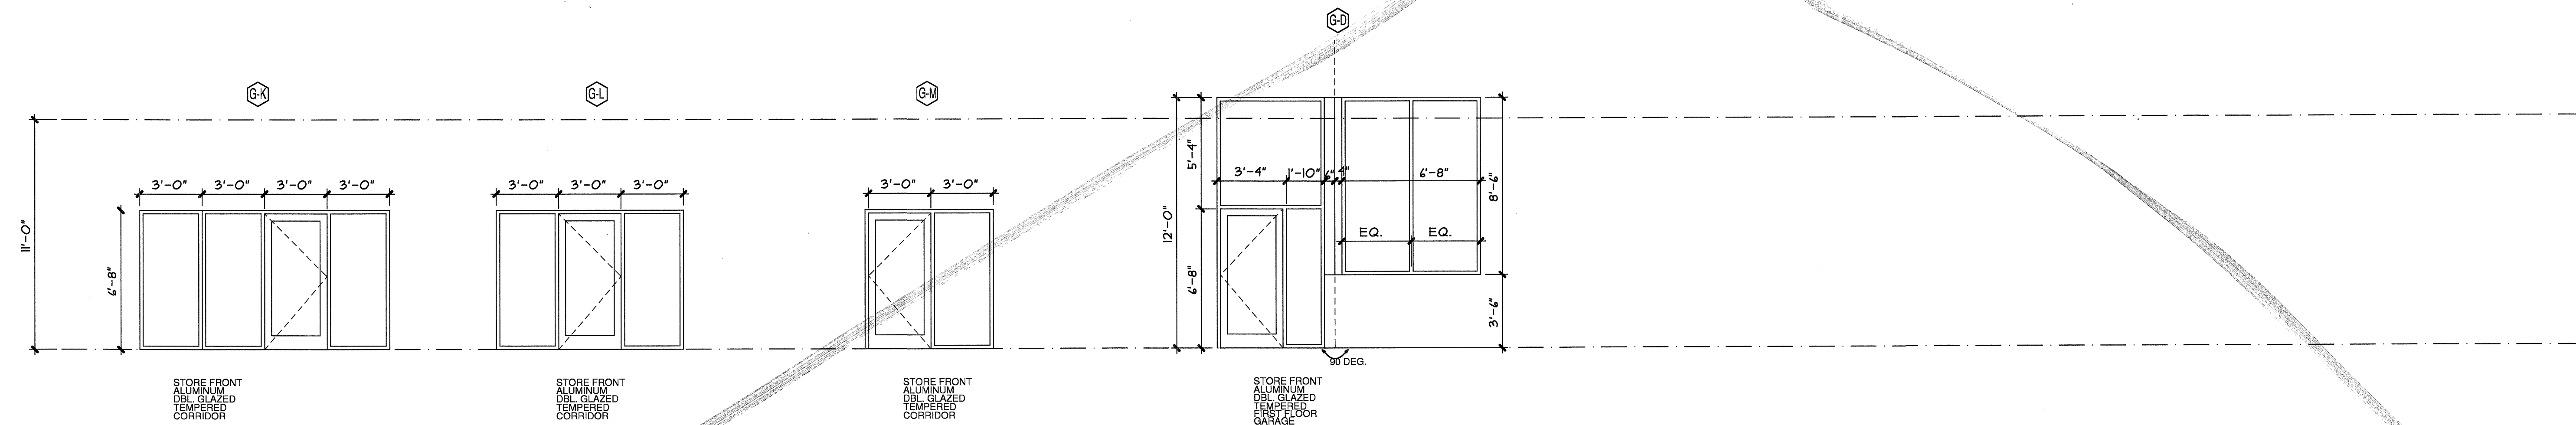

10-17-2011

REVISIONS
3 COORDINATION
10-11-2011

KELLER SPRINGS LOFTS
LOFT APARTMENTS IN ADDISON, TEXAS

CONSTRUCTION ISSUE
10-17-2011

BGO architects
4144 N. Central Expy.
Suite 855
Dallas, TX 75204
214.520.8878
bgoarchitects.com

DATE
08-05-2011

PROJECT
11129

SHEET NUMBER

2.0a

SCHEDULE

COPYRIGHT © Beiler Guest-Owens Architects ALL RIGHTS RESERVED