

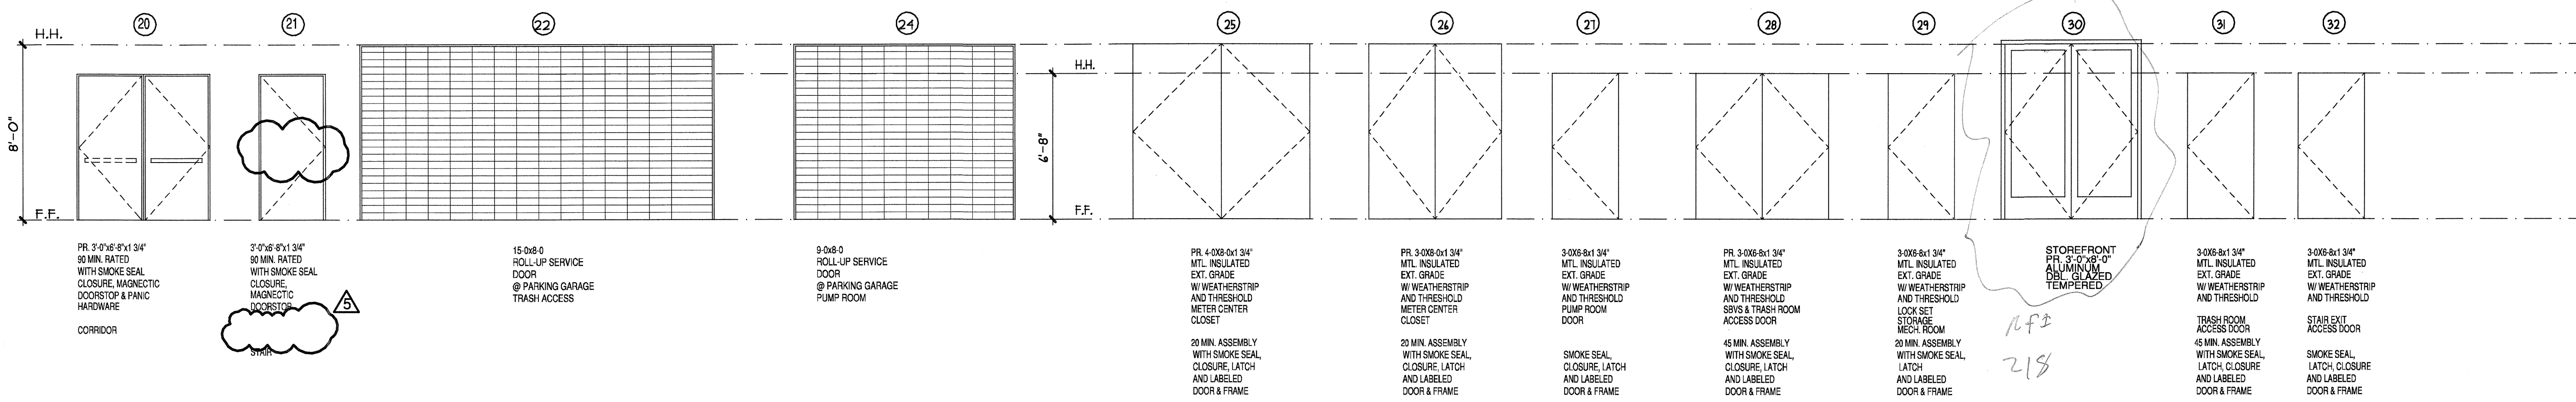


DOOR SCHEDULE (CONTINUED)

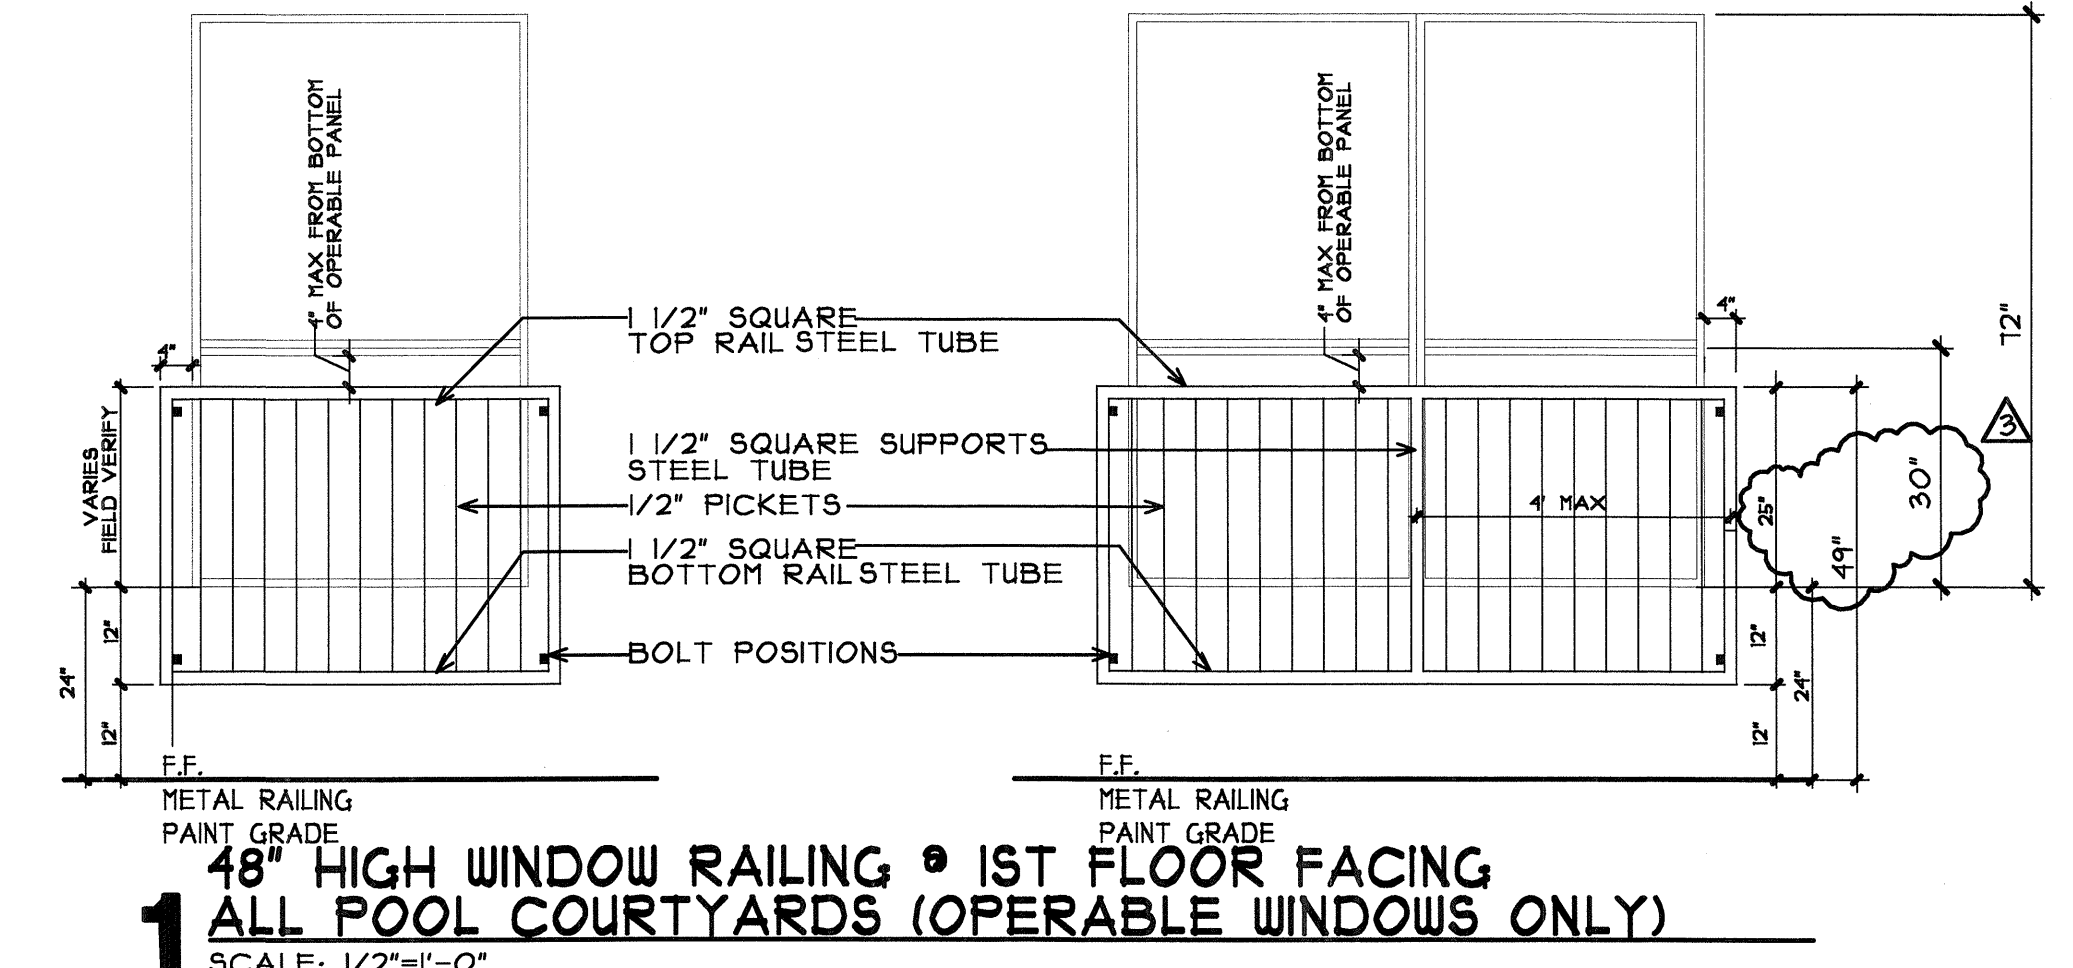


COMMON WINDOW SCHEDULE

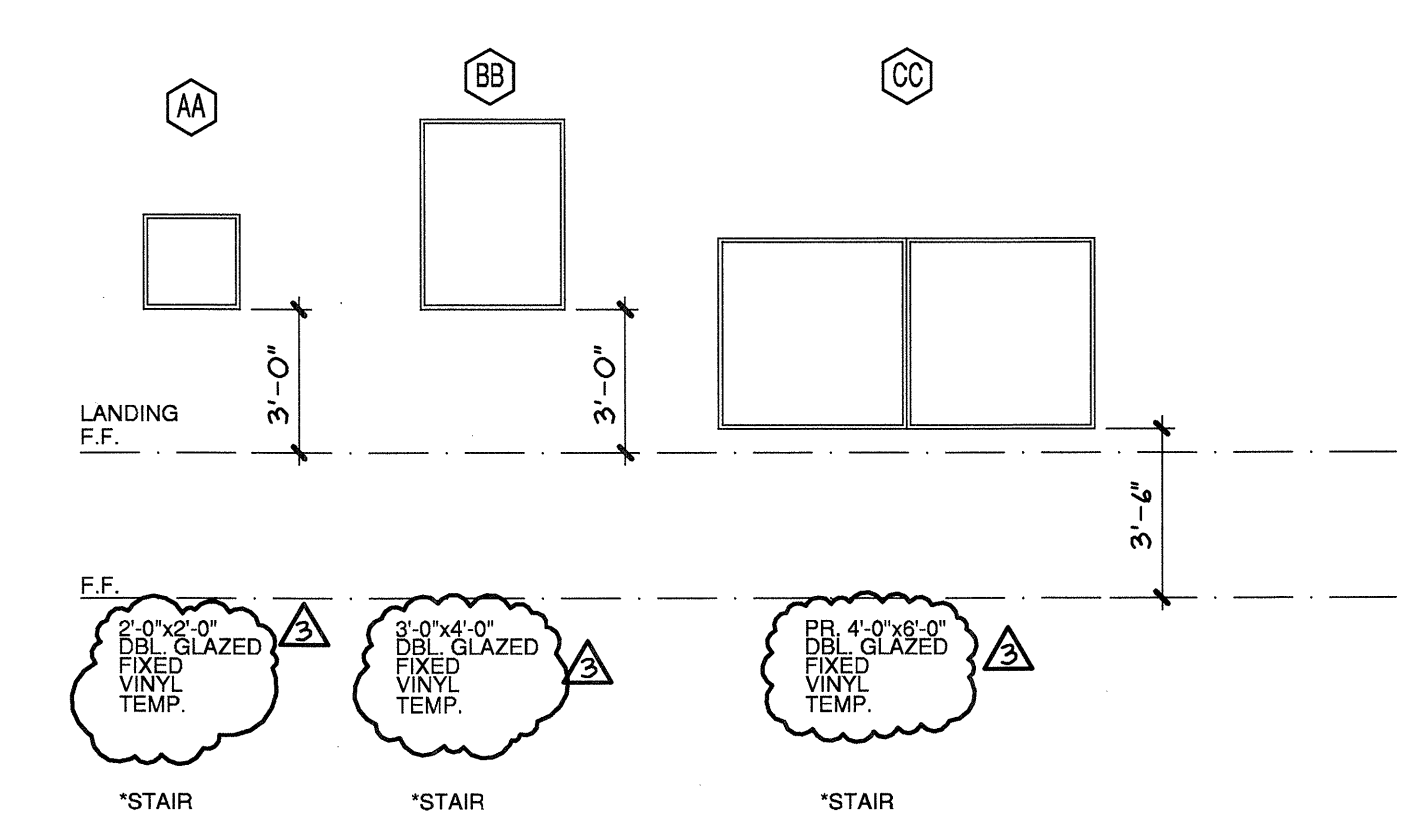

GENERAL NOTE:
FIELD VERIFY ALL OPENINGS PRIOR TO GRILLE AND GATE FABRICATION.

STOREFRONT SCHEDULE

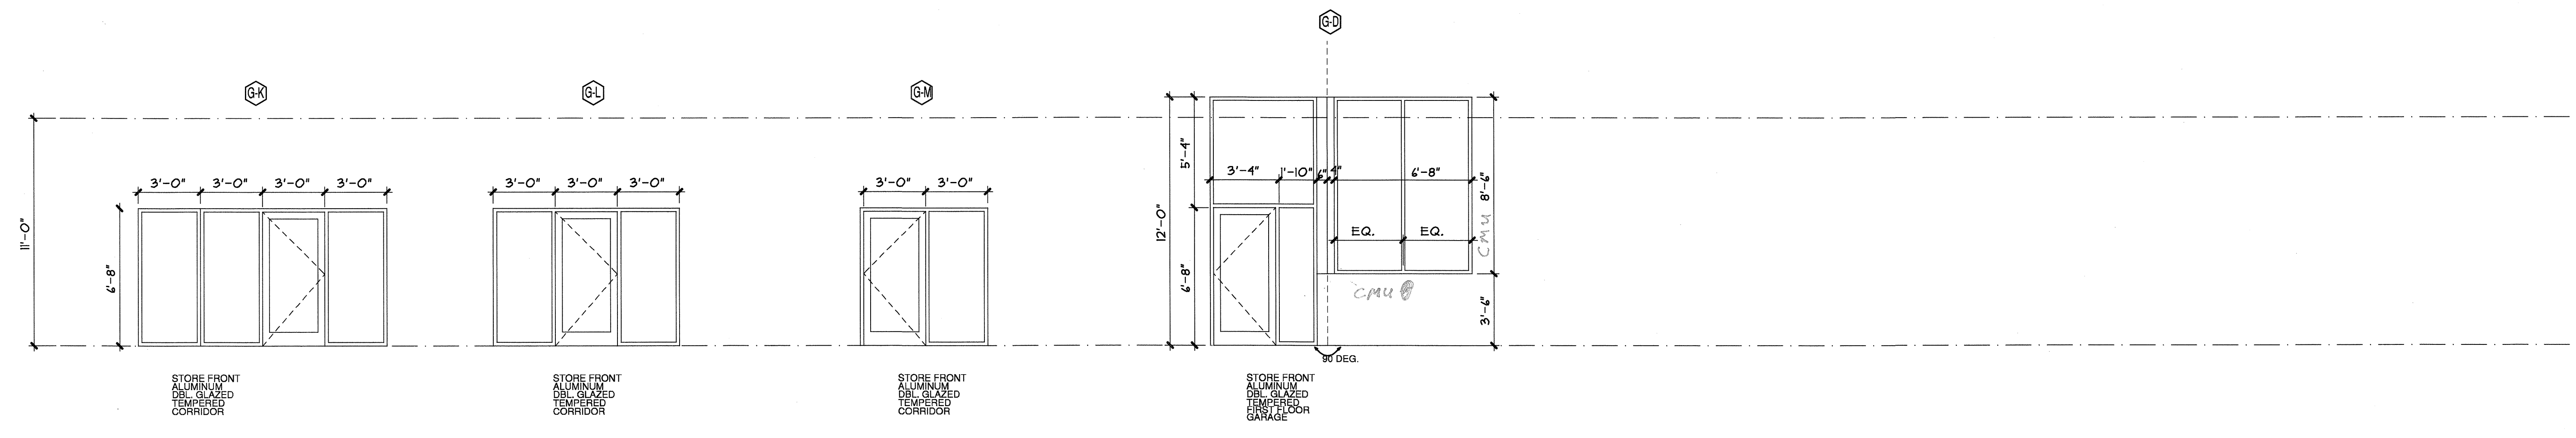

REVISIONS

COORDINATION	10-17-2011
COORDINATION	02-29-2012

KELLER SPRINGS LOFTS

LOFT APARTMENTS IN ADDISON, TEXAS

CONSTRUCTION ISSUE
10-17-2011

BGO architects
4144 N. Central Expy.
Suite 855
Dallas, TX 75204
214.520.8878
bgoarchitects.com

DATE
08-05-2011

PROJECT
11129

SHEET NUMBER

2.0A

SCHEDULE

COPYRIGHT © Beeler Guest Architects. All Rights Reserved