

RFI

To: Erik Earnshaw
 Beiler Guest Owens Architects
 4245 N. Central Expressway
 Suite 300
 Dallas, TX 75205
 Ph: 214/520-8878 Fax: 214/520-8879

RFI #: 125
 Date: 5/21/2012
 Job: EB-02 Keller Springs Lofts
 Phone: 877-777-5115

CC:
 Subject: A1 and A1-HC Unit Questions

Drawing: A2.2 & A2.2HC
 Cost Impact: None

Spec Section:
 Schedule Impact: None

Request: Date Required: 5/29/2012
 A1 Unit - Please provide length of wall dimension for wall that separates vanity and toilet.
 A1HC Unit - Please provide door number for bathroom door from the kitchen area. Also provide dimensions for where the door sits.


Requested by: David Miller
 Embrey Builders LLC

Response: The wall in the A1 unit is 2'-1".
 The door tag in A1HC is 10.
 Off the plumbing wall where the tub is, the wall is 4" for the door frame, the door is 3'-0", then there is 2'-0" till the wall where the closet door is.
 The dimension text that is on top of the door tag says 5'-4".

Ryan Faulds
 BGO architects
 June 01, 2012

Answered by _____
 Company _____ Date _____

Platform for lowboy + Tallboy
 EMBREY STANDARD DETAIL
 5/29/12

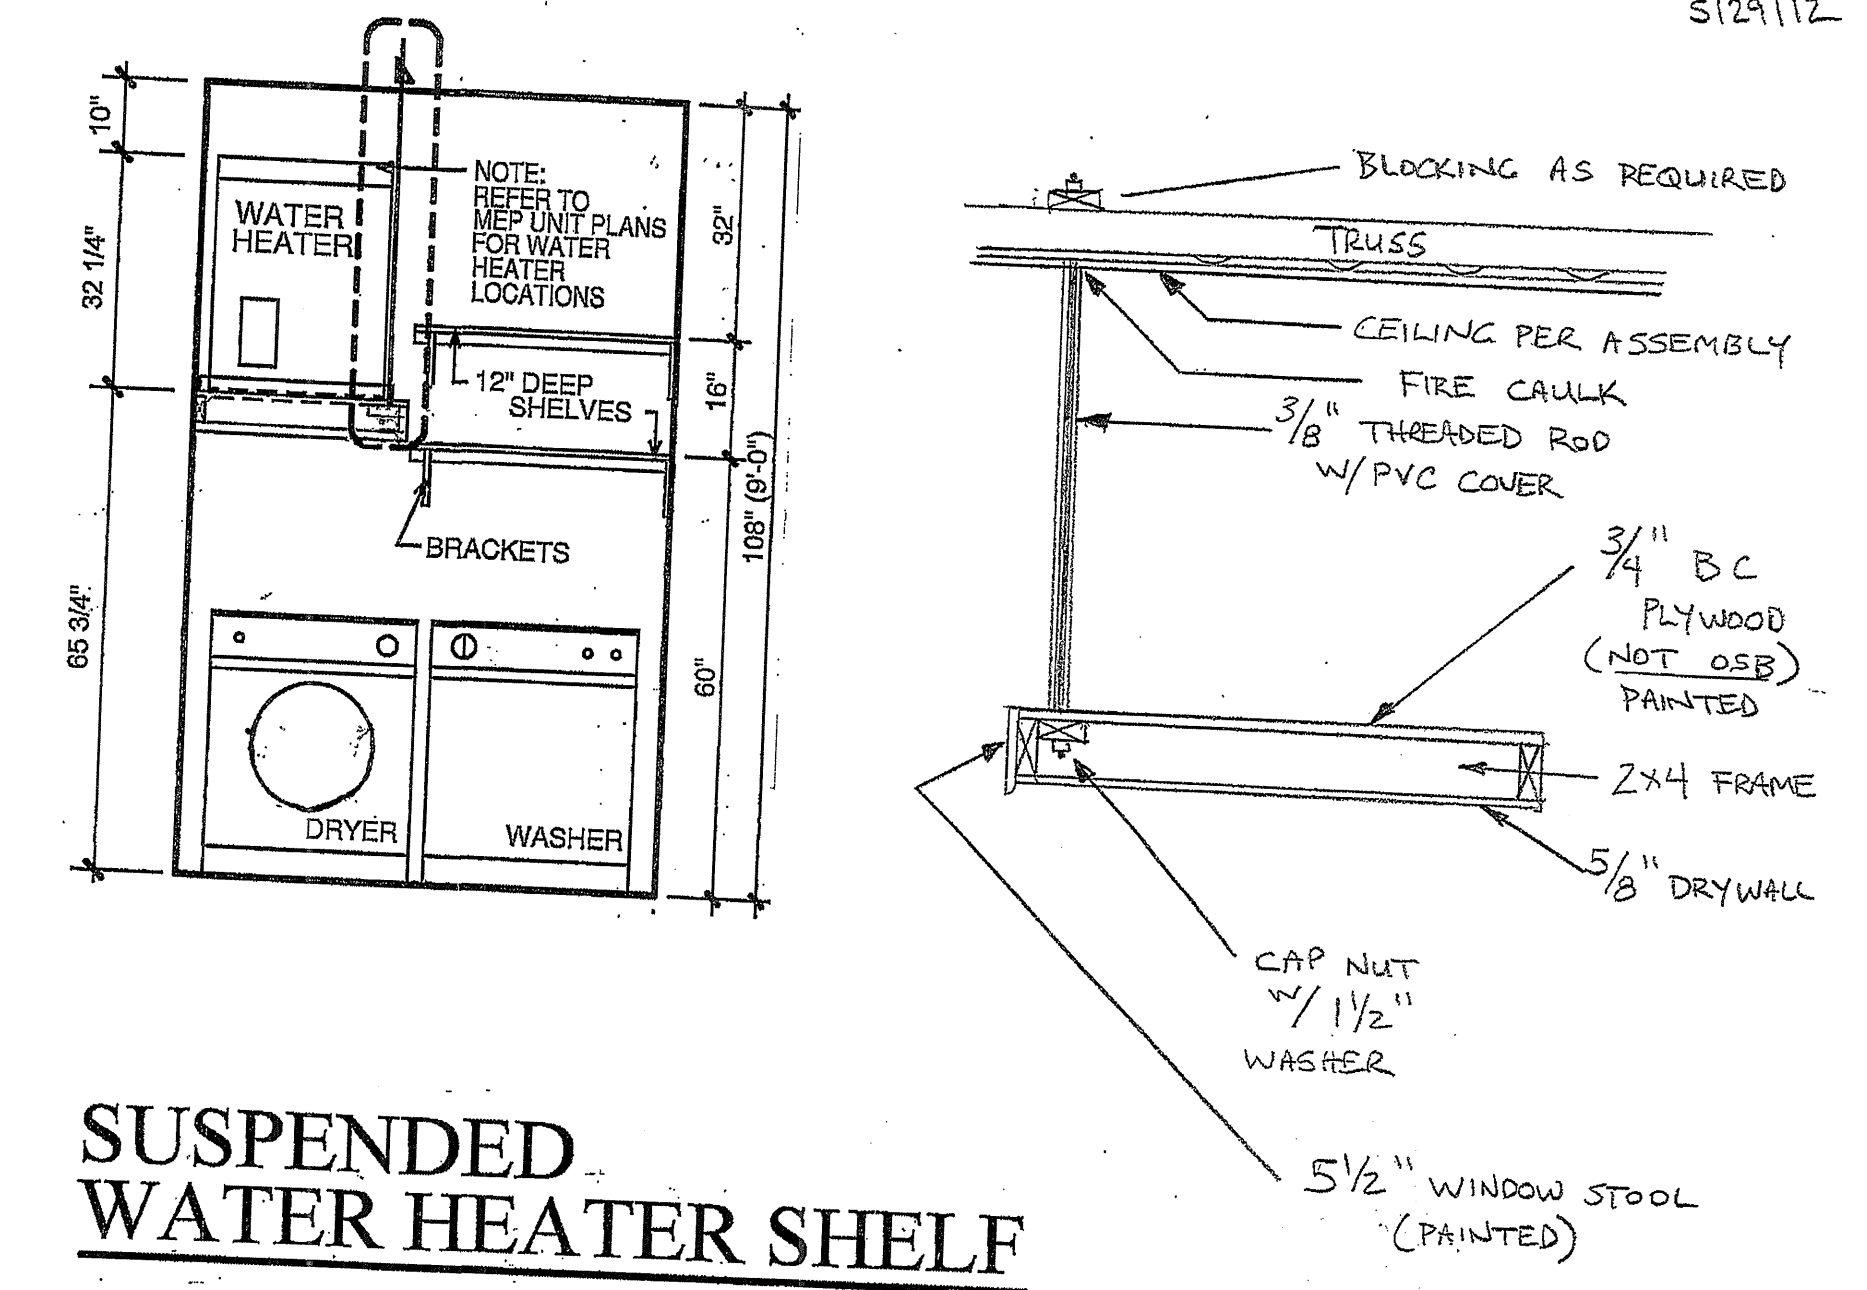

SUSPENDED WATER HEATER SHELF